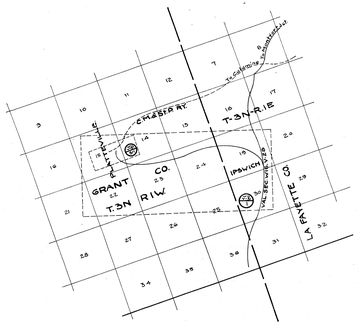

No.	Grantor	Grantee	Instrument	Date	Recorded Book	Recorded Page	Recorded Date	Remarks	Area Sq.Ft.	Area Ac.
1	Henry C. Doscher	C.M.& St.P.Ry.Co.	W.C.D.	June 3, 1863	31	37	June 11, 1863			2.40
2	Heirs of R.R.Huntington	C.& N.W.Ry.Co.	Deed	May 23, 1875	51	6	Aug. 23, 1875			1.90
3	Mary Smith, et al	C.& N.W.Ry.Co.	W. D.	Oct. 27, 1862	38	196	Dec. 26, 1859			1.24
	A. A. Stephens (Guardian)	&c	Orde.Deed	Aug. 22, 1857	35	299	Dec. 26, 1859			
			GRANT		FOUR					
4	Same Deed as Parcel #2								40350	
5	William Trenary	C.& N.W.Ry.Co.	Deed	May 22, 1875	73	515	Aug. 23, 1875			2.94
6	William Fruseig	C.& N.W.Ry.Co.	W. D.	Dec. 3, 1026	107	306	Dec. 16, 1865			1.24
7	Same Deed as Parcel #6									1.31
8	Francis Rose	C.& N.W.Ry.Co.	Deed	Feb. 25, 1875	73	516	Aug. 23, 1875		33350	
9	Thomas Chapman	C.& N.W.Ry.Co.	Deed	Feb. 20, 1875	73	517	Aug. 23, 1875			0.71
10	Possessory Title							Held by adverse possession since 1875.	18500	
11	Nora D. Jones, et al	C.M.& St.P.Ry.Co.	W.C.D.	May 24, 1863	98	570	June 11, 1863		13500	
	Hannah C. Dupley	&c	W.C.D.	May 31, 1863	100	24	June 14, 1863			
12	H. Robbins	C.& N.W.Ry.Co.	Deed	Aug. 4, 1875	73	516	Aug. 23, 1875			0.32
	Hannah Robbins	C.& N.W.Ry.Co.	W. D.	Jan. 3, 1863	98	286	Jan. 10, 1863			
13	Noah H. Virgin	C.M.& St.P.Ry.Co.	W. D.	Sept.30, 1862	97	236	Oct. 2, 1862			1.46

STATE OF ILLINOIS
COUNTY OF COOK

I, the undersigned, officer of the Chicago and North Western Railway, do hereby certify that this is a correct MAP in a series of 1 primary sheets and 1 supplemental sheets of said Railway from survey station 1371+00 to survey station 1569+58, MADISON Division, State of WISCONSIN prepared from the records of said company.

Correct Howard Hazelhurst
Valuation Engineer.

J. Mimkey
Chief Engineer.

Subscribed and sworn before me this 9th day of Jan. 1918.

Howard S. Latimer
Notary Public in and for the County of Cook, State of Illinois

My commission expires April 27th 1921.

RIGHT OF WAY AND TRACK MAP
CHICAGO AND NORTH-WESTERN RAILWAY
OPERATED BY THE
C.& N-W. RY. CO.
MADISON DIVISION
IPSWICH to PLATTEVILLE, WIS.
STA. 1371+00 TO STA. 1569+58

SCALE 1-IN - 400 FT. JUNE 30, 1917.
OFFICE OF CHIEF ENGINEER
CHICAGO, ILL.

W.I.S. V-31 1

PLATTED-R.W.-MAY 8, 1917
CHAINING NOTES-
TRACED-A.H.-MAY 28, 1917
CHECKED-S.K.Y.-JUN