











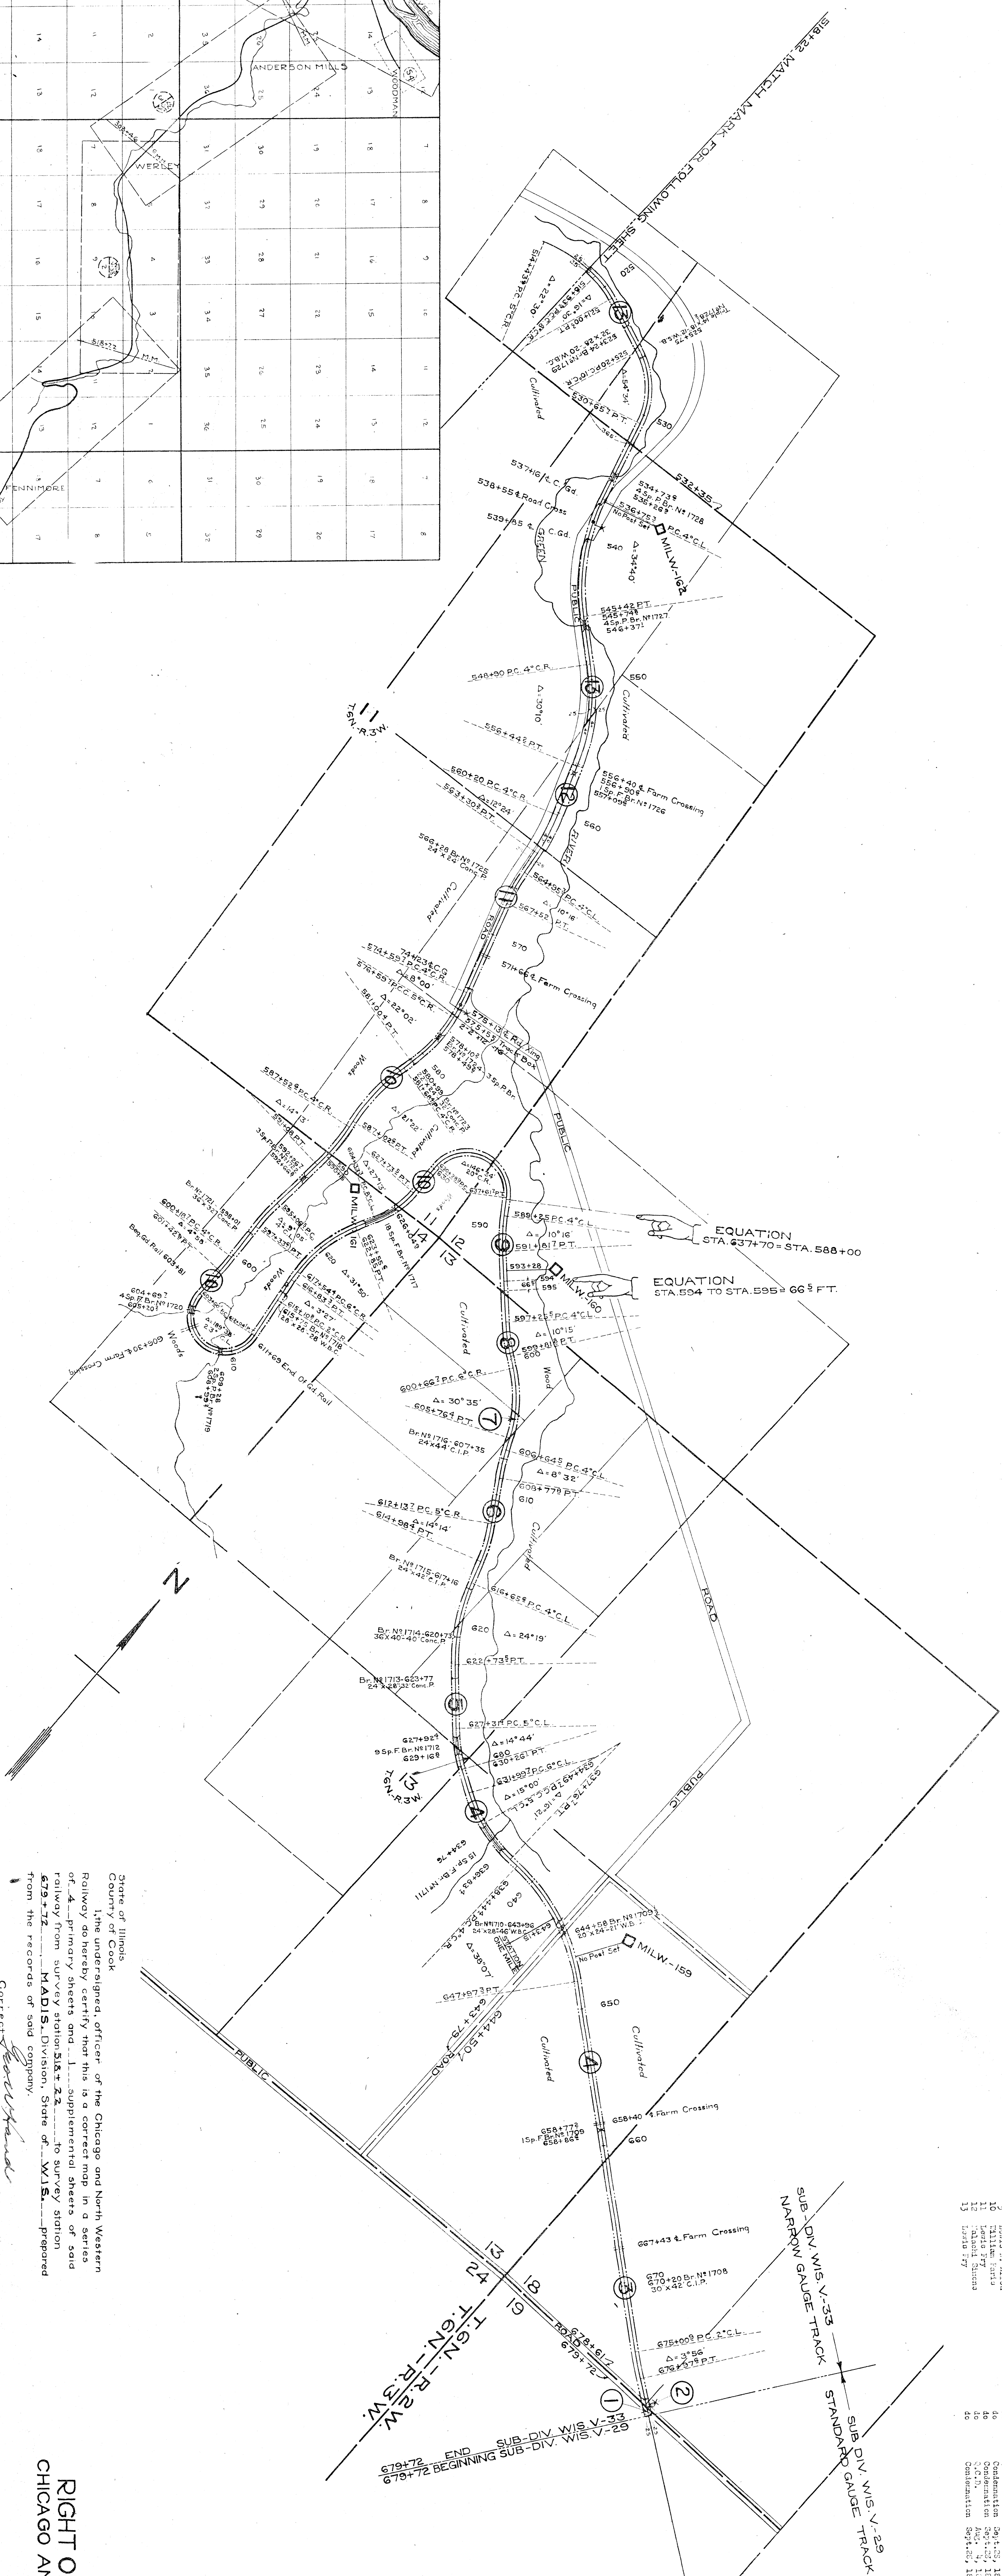

State of Illinois
County of Cook

MADIS


Correct George Hand

Valuation Engineer
W. J. Anderson
 Chief Engineer
 Subscribed and sworn to before me, this 26 day of December, 1917

Arnold's
Notary Public in and for the
County of Cook
State of Illinois

RIGHT OF WAY AND TRACK MAP
CHICAGO AND NORTH-WESTERN RAILWAY
OPERATED BY THE
C. & N-W. RY. CO.
MADISON DIVISION
FENNIMORE, WIS. TO WOODMAN, WIS.
STA. 516+22 TO STA. 679+72
SCALE H-IN. = 400 FT. JUNE 30, 1917.
OFFICE OF CHIEF ENGINEER
CHICAGO, ILL.