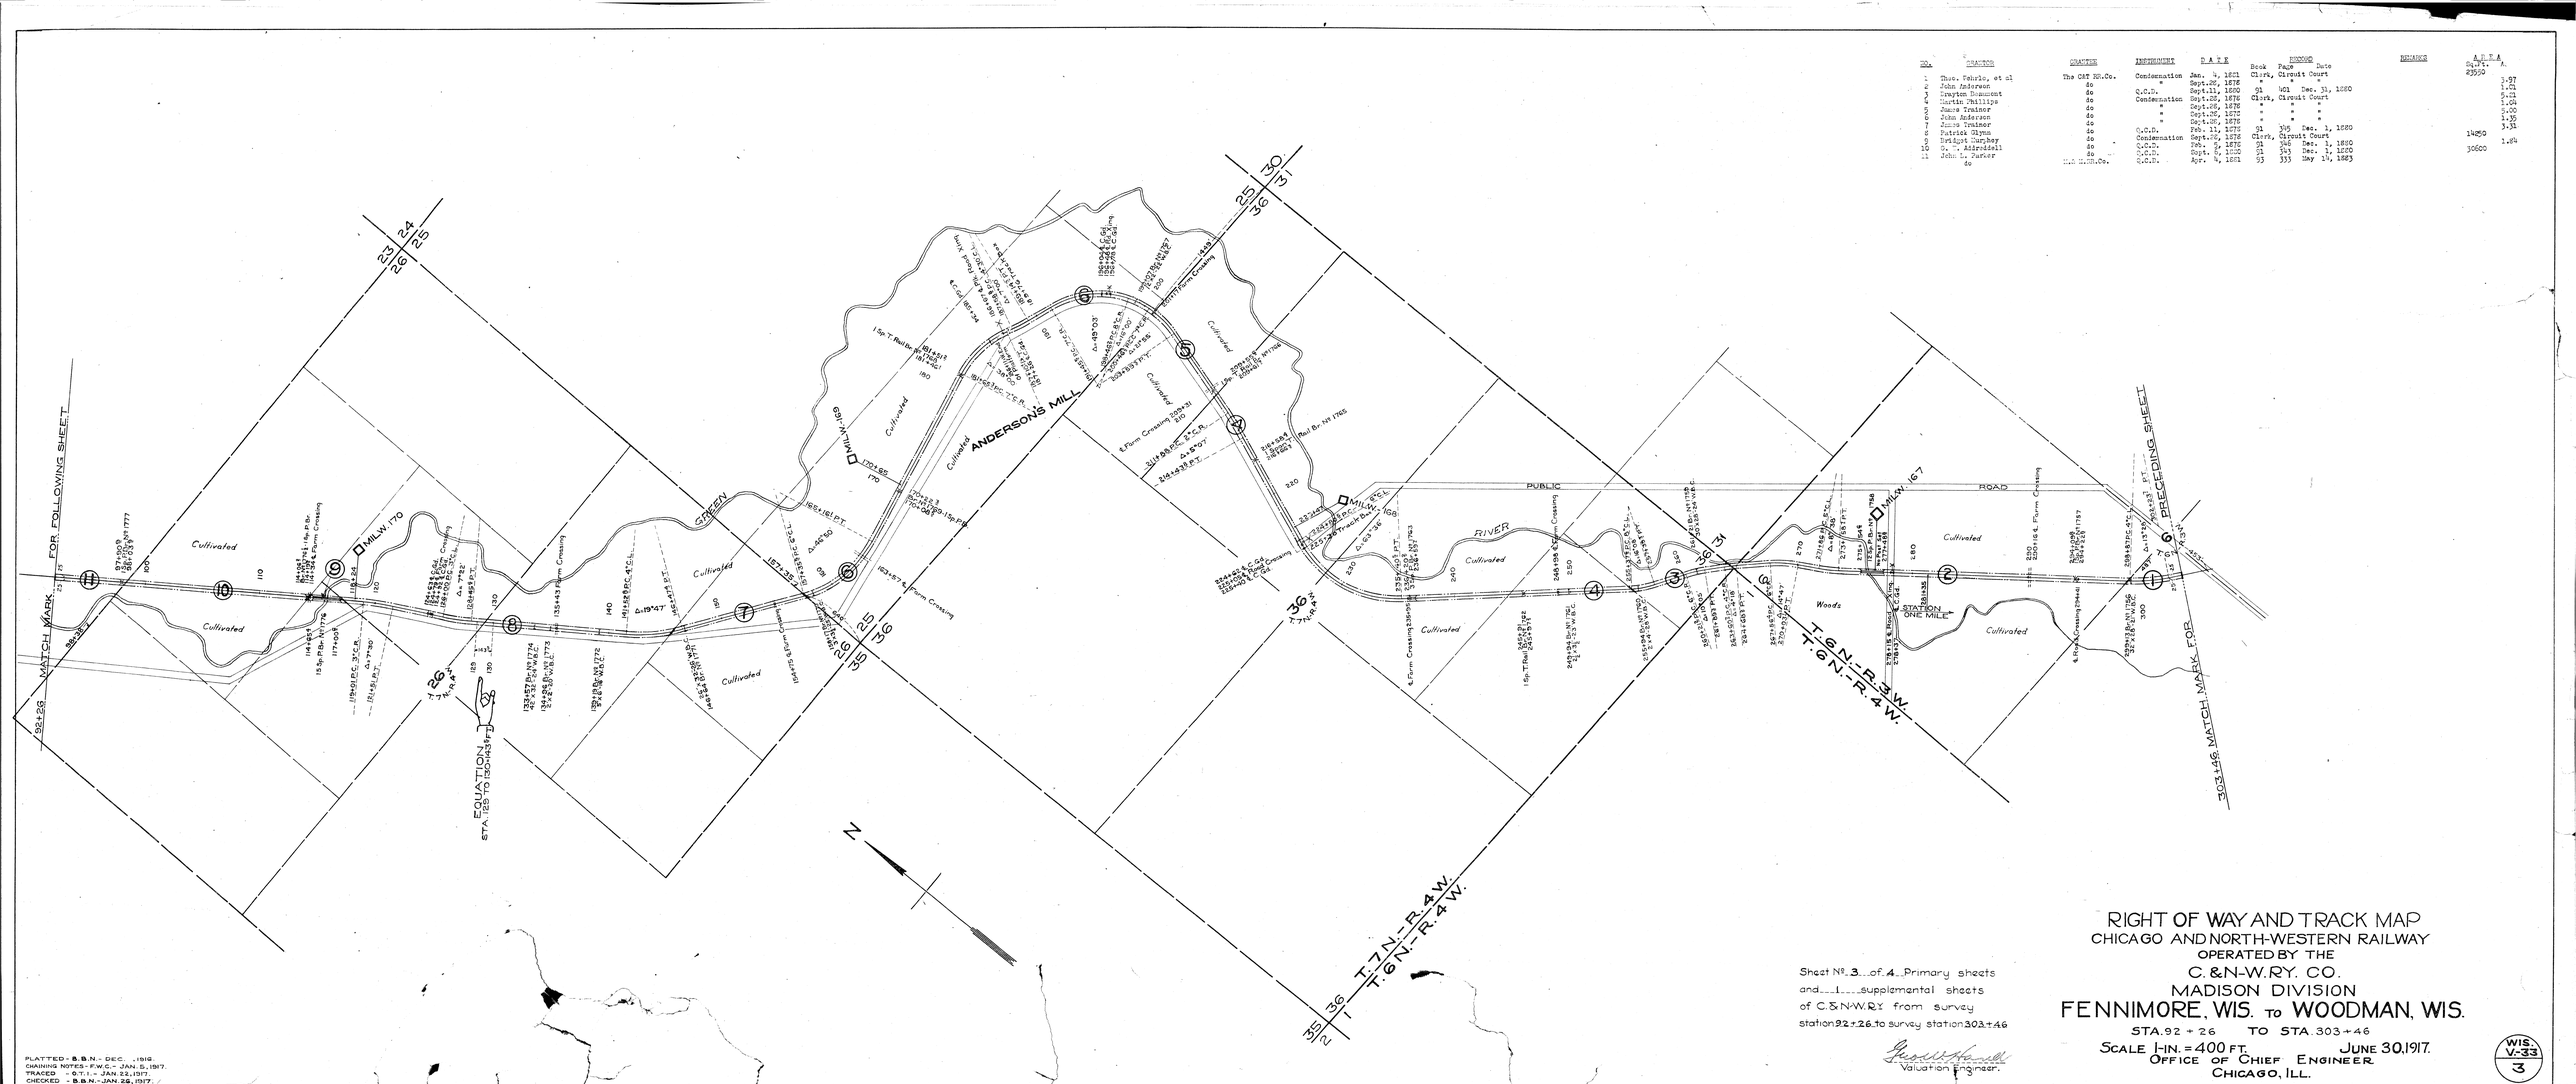

NO.	GRANTOR	GRANTEE	INSTRUMENT	DATE	RECORD Book	Page	Date	REMARKS	AREA Sq.ft.	A.
1	Thos. Fehrle, et al	The C&T RR.Co.	Condemnation	Jan. 4, 1861	Clerk, Circuit Court				23550	
2	John Anderson	do	"	Sept.26, 1870	"	"	"			3.97
3	Drayton Doucont	do	Q.C.D.	Sept.11, 1880	91	401	Dec. 31, 1880			1.01
4	Martin Phillips	do	Condemnation	Sept.28, 1870	Clerk, Circuit Court					1.01
5	Joana Trainor	do	"	Sept.26, 1870	"	"	"			1.04
6	John Anderson	do	"	Sept.26, 1870	"	"	"			2.00
7	Joana Trainor	do	"	Sept.26, 1870	"	"	"			1.35
8	Patrick Glynn	do	Q.C.D.	Feb. 11, 1870	91	395	Dec. 1, 1880			3.31
9	Bridget Carney	do	Condemnation	Sept.26, 1870	Clerk, Circuit Court				14250	
10	O. C. Aldredell	do	Q.C.D.	Feb. 8, 1870	91	396	Dec. 1, 1880			1.64
11	John L. Parker	do	Q.C.D.	Sept. 8, 1880	91	393	Dec. 1, 1880		30600	
	do	The C.&N.W.Co.	Q.C.D.	Apr. 4, 1881	93	333	May 19, 1883			

PLATTED - B.B.N. - DEC. , 1916.
CHAINING NOTES - F.W.C. - JAN. 5, 1917.
TRACED - G.T.I. - JAN. 22, 1917.
CHECKED - B.B.N. - JAN. 26, 1917.

Sheet No. 3 of 4 Primary sheets
and 1 supplemental sheets
of C.&N.W.RY. from survey
station 92+26 to survey station 303+46

Valuation Engineer.

RIGHT OF WAY AND TRACK MAP
CHICAGO AND NORTH-WESTERN RAILWAY
OPERATED BY THE
C. & N-W. RY. CO.
MADISON DIVISION
FENNIMORE, WIS. to WOODMAN, WIS.

STA. 92 + 26 TO STA. 303 + 46

SCALE 1 IN. = 400 FT. JUNE 30, 1917.

OFFICE OF CHIEF ENGINEER
CHICAGO, ILL.

WIS. V.-33
3