Wis. V-34. Sheet 1.

TRACT NO.	GRANTOR	GRANTEE	INSTRUMENT	DATE	RECORD	REMARKS	ACREAGE
1.	Grunewaldt Heirs	M.E.&N.W Ry.Co.	Special Commissioners Deed.	Dec. 23, 1909	Vol. 600, P.118-119, Jan. 4, 1910.		17.59 Ac.
	Elizabeth Grunewaldt	"	C. C. D.	Dec. 14, 1909	Vol. 600, P. 121-122 Jan. 4, 1910		
	Martin Grunewaldt	"	W. D.	Dec. 14, 1909	Vol. 601, P. 21-23 Jan. 4, 1910		
	Elizabeth Grunewaldt	"	Release	Oct. 27, 1910	Office of Land Commissioner.	Release of Damage	
2.	Ernst Otting & W.	"	W. D.	Nov. 5, 1909	Vol. 587, P. 611-612 Nov.11, 1909		1.92 *
3.	C. H. Schwarz & W.	"	W. D.	Nov. 5, 1909	Vol. 588, P. 103-104 Nov.11, 1909		2.42 *
4.	William Kiehnau & W.	"	W. D.	Nov. 4, 1909	Vol. 583, P. 506-507 Nov.11, 1909		6.93 *
5.	T. J. Perales & W.	"	W. D.	Nov. 23, 1909	Vol. 588, P. 557-559, Dec. 4, 1909		5.65 *
	" "	"	Grant	Nov. 29, 1910	Vol. 603, P. 570-571 Dec. 22, 1910	Right for crossing approaches outside of right of way.	
6.	Wm. Eggert & W.	"	W. D.	Oct. 30, 1909	Vol. 599, P. 87-88, Nov.11, 1909		3.04 *
	" "	"	Release	Sept.20, 1910	Vol. 602, P. 603-607, Oct.17, 1910	Release of Crossing	
	" "	"	"	Mar. 29, 1913	Office of Land Commissioner	" " Damage	
7.	Friedrich Boehlke & W.	"	W. D.	Nov. 4, 1909	Vol. 600, P. 67-69 Nov.11, 1909		3.03 *
	" " " "	"	Grant	Sept.25, 1910	Vol. 620, P. 154-155 Oct.17, 1910	Right for farm crossing approaches outside of right of way and Release of Damage.	
8.	Wilhelm Heckbarth	"	W. D.	Nov. 4, 1909	Vol. 599, P. 85-87 Nov.11, 1909		29.08 *
9.	C. M. & St. P. Ry.	"	Contract	Apr. 10, 1910	Office of Secy B. 39, P. 304	Right of Crossing (4426 Sq. Ft.)	
10.	John A. Heckbarth	"	W. D.	Nov. 4, 1909	Vol. 598, P. 110-111 Nov.12, 1909		4.58 *
	"	"	Release	Oct. 26, 1910	Vol. 603, P. 539, Dec. 6, 1910	Release of Crossing	
11.	Oswald Kiehnau & W.	C.&N.W Ry. Co.	W. D.	Oct. 7, 1913	Vol. 676, P. 435-440 Nov. 6, 1913		0.17 *
12.	Auguste Giesfeldt	M.E.&N.W Ry.Co.	W. D.	Nov. 6, 1909	Vol. 600, P. 76-78, Nov.13, 1909		4.25 *
13.	William Madden	"	W. D.	Nov. 4, 1909	Vol. 587, P. 613-614 Nov.11, 1909		9.51 *
14.	" "	Wis.T. L. Co.	W. D.	Feb. 7, 1910	Vol. 598, P. 282-283 Feb.25, 1910		27.17 *
15.	John Sparts & W.	M.E.&N.W Ry.Co.	W. D.	Oct. 30, 1909	Vol. 600, P. 69-70 Nov.11, 1909		5.21 *
16.	Herman Gilbert & W.	"	W. D.	Nov. 24, 1909	Vol. 599, P. 129-130 Dec. 4, 1909		8.97 *
17.	Wilhelmine Gauger et al	"	W. D.	Nov. 8, 1909	Vol. 588, P. 520-521 Nov.16, 1909		4.01 *
17a	Highway Crossing				Highway carried over Railroad. Bridge #6401. Plans on file Chief Engineer's office.		
18	Possessory Title						0.70 +

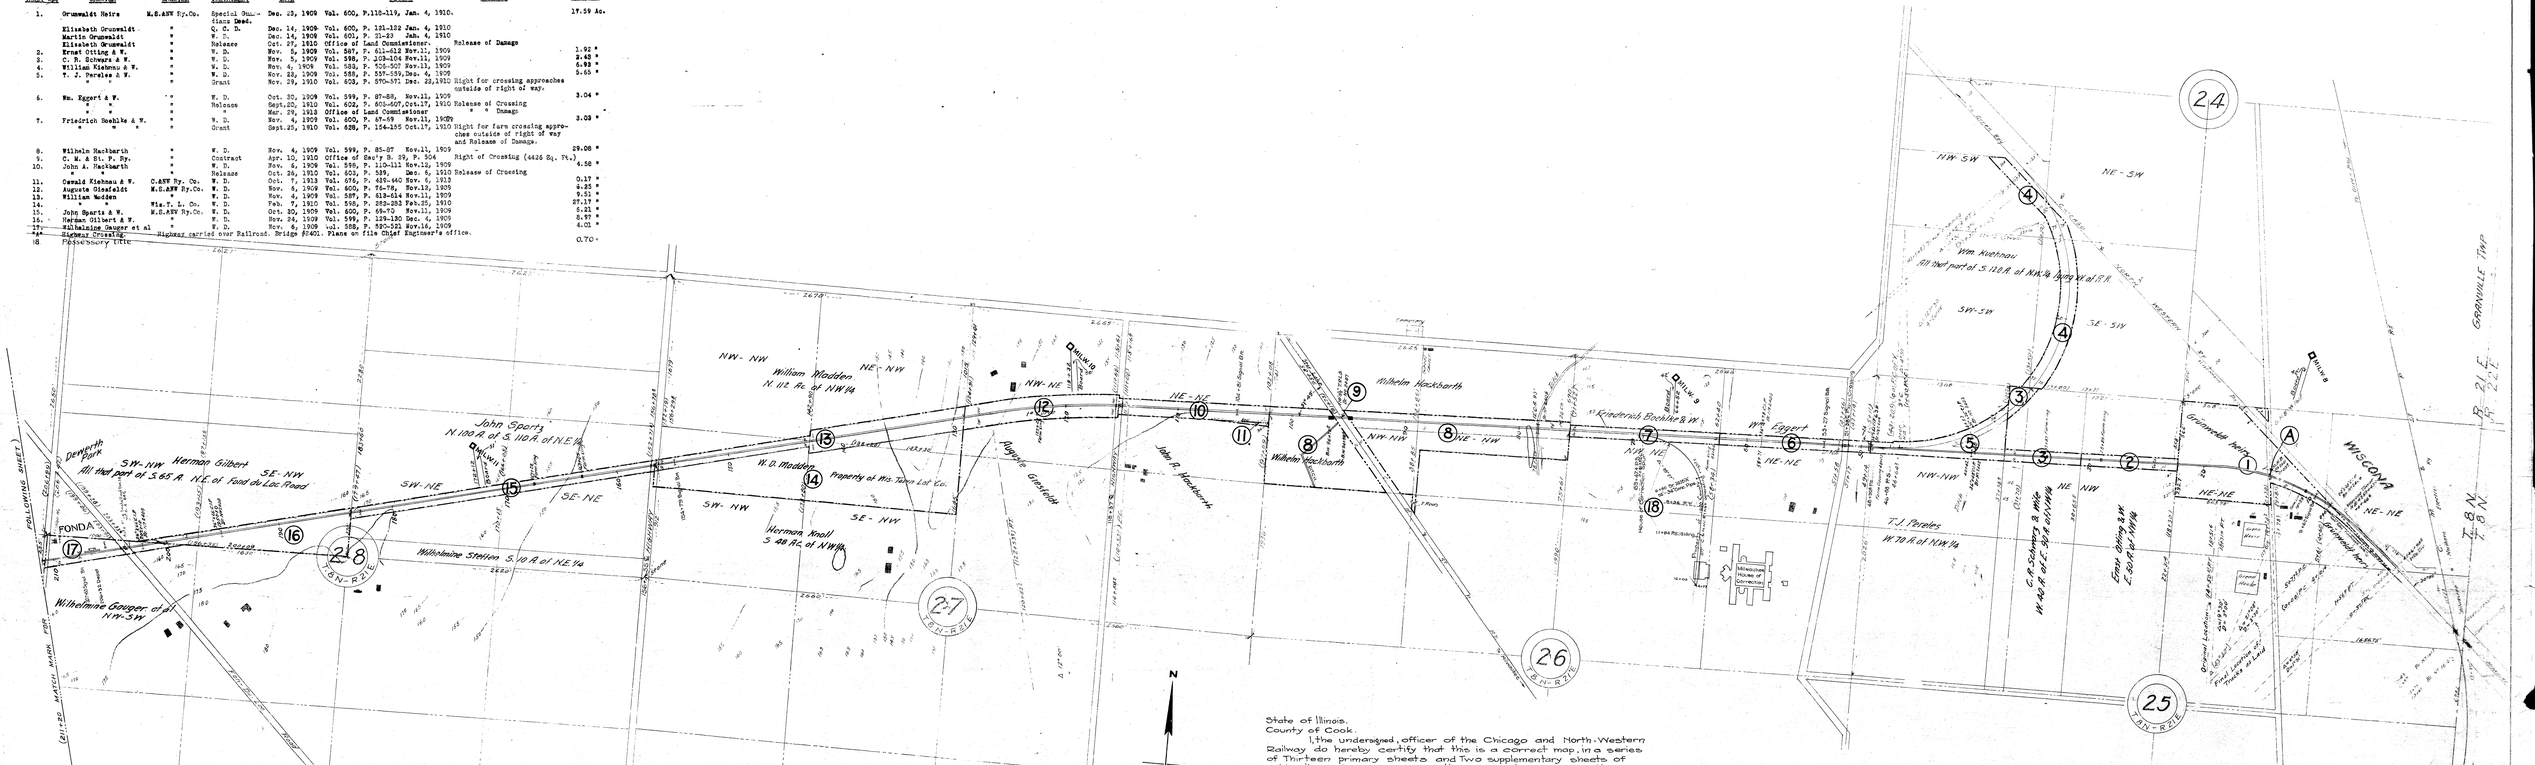

State of Illinois.
County of Cook.
I, the undersigned, officer of the Chicago and North-Western Railway do hereby certify that this is a correct map, in a series of Thirteen primary sheets and Two supplementary sheets of said railway from survey station 0+00 to survey station 2307+61.4 - Madison Division, State of Wisconsin, prepared from the records of said company

Correct: Geo. W. Haid
Valuation Engineer

W. B. Kinley
Chief Engineer

Subscribed and sworn to before me this 7th day of April, 1916

Jesse B. Wilson
Notary Public in and for the County of Cook, State of Illinois.

My commission expires May 11th 1918

RIGHT OF WAY AND TRACK MAP
CHICAGO AND NORTH-WESTERN RAILWAY
OPERATED BY THE
C. & N-W. RY. CO.
MADISON DIVISION
MILWAUKEE, WIS. to CLYMAN JCT. WIS.
STA. 0+00 TO STA. 211+20
SCALE 1 IN. = 400 FT. JUNE 30, 1917.
OFFICE OF CHIEF ENGINEER
CHICAGO, ILL.

WIS. V-34 1