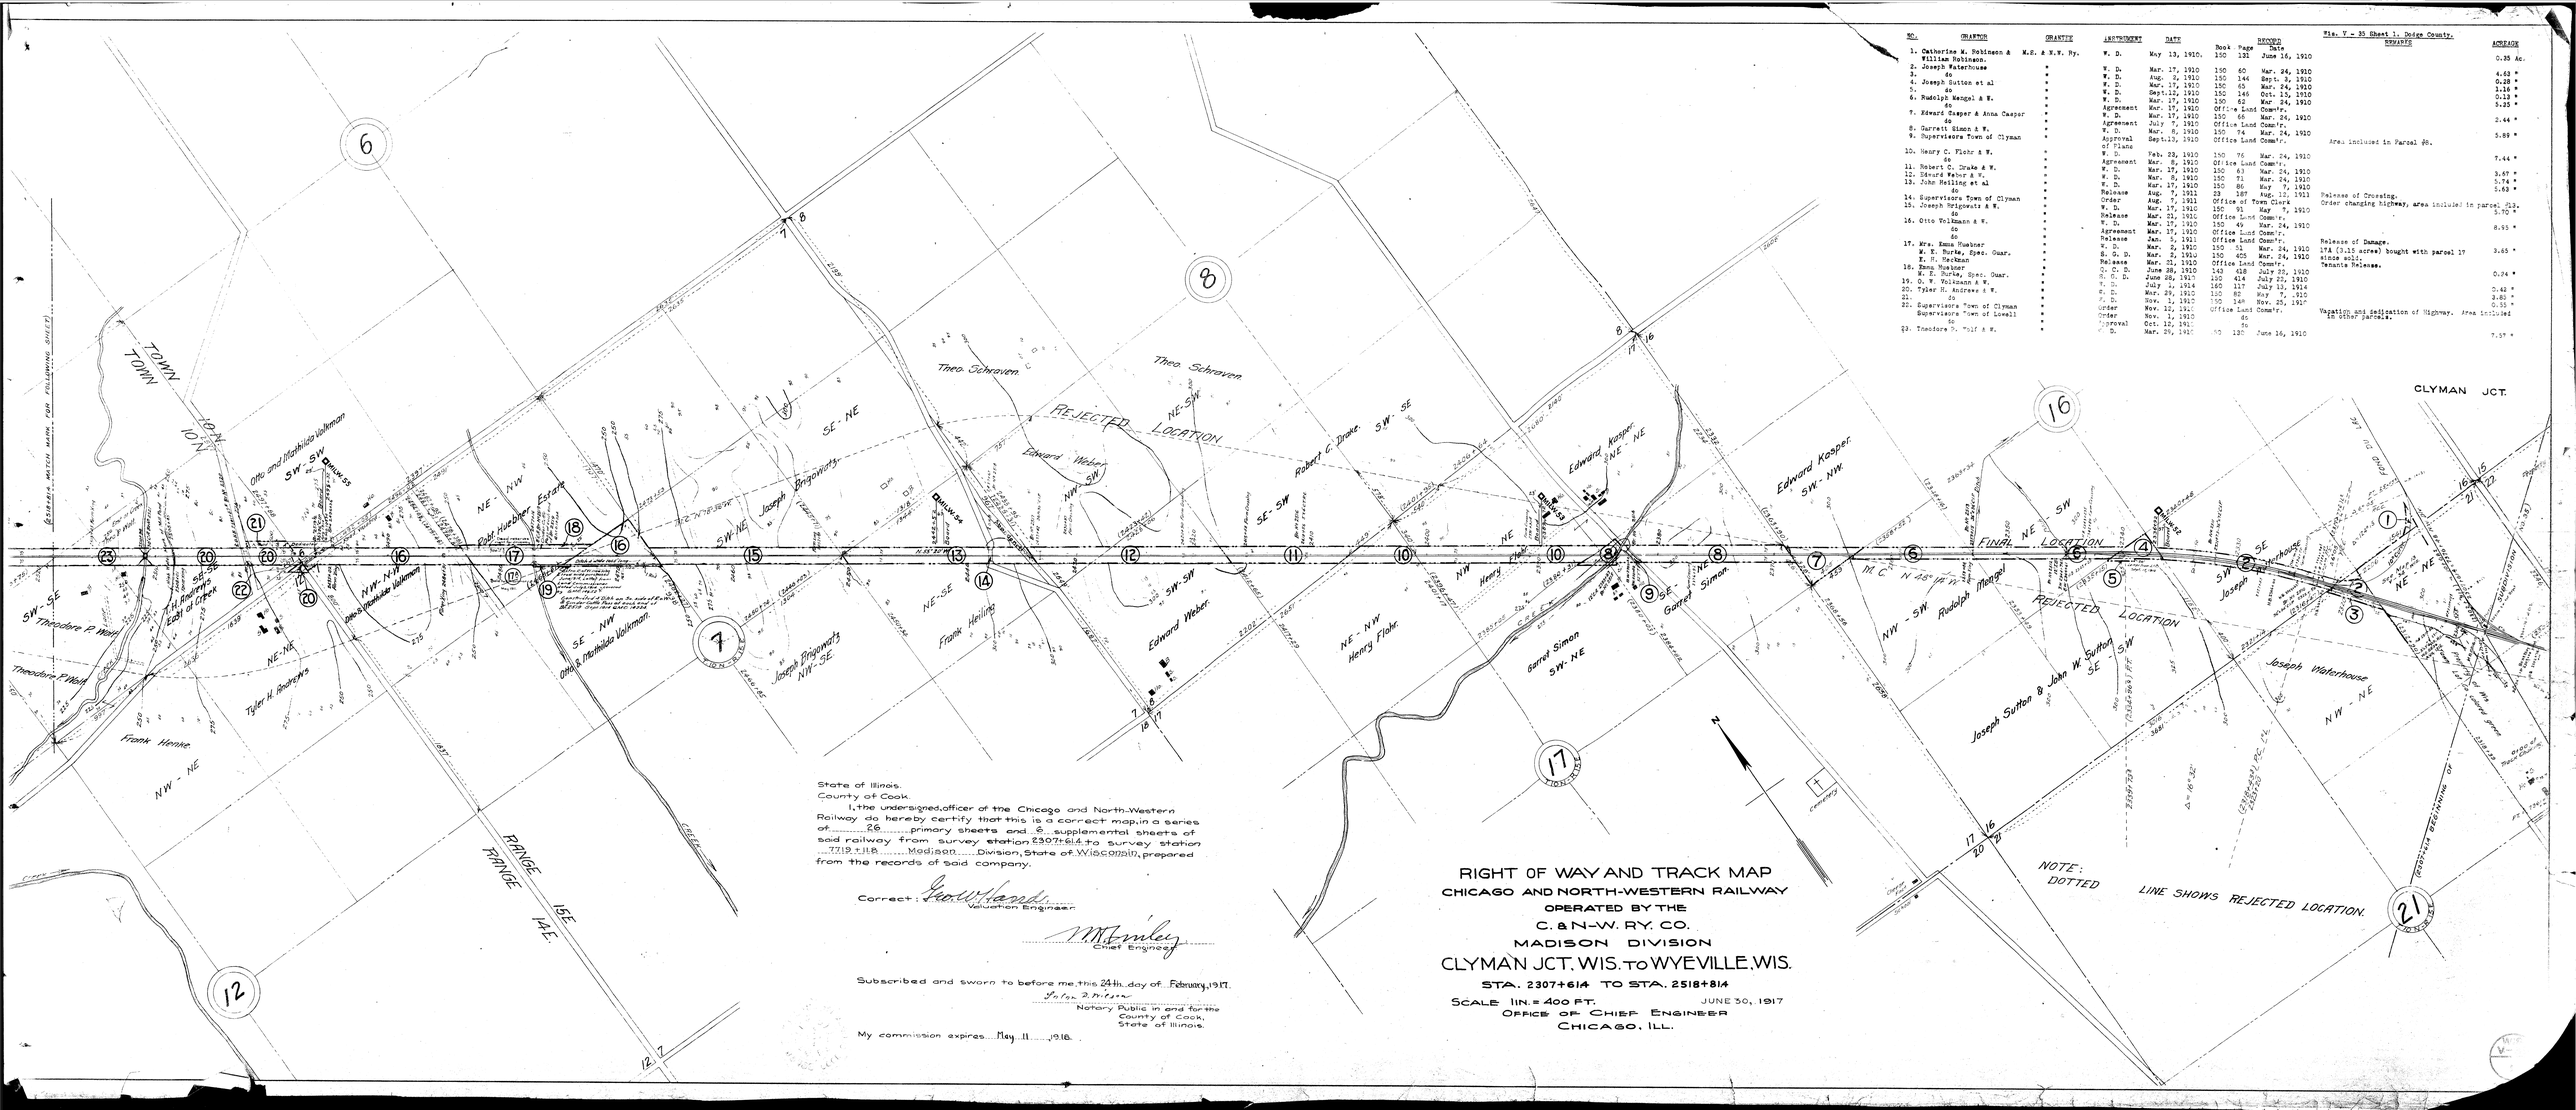

Wis. V - 35 Sheet 1. Dodge County.
NO. GRANTOR GRANTEE INSTRUMENT DATE RECORDED Book Page Date ACREAGE
1. Catherine M. Robinson & William Robinson. M.S. & N.W. Ry. W. D. May 13, 1910. 150 121 June 16, 1910 0.35 Ac.
2. Joseph Waterhouse. W. D. Mar. 17, 1910 150 60 Mar. 24, 1910 4.63 *
3. do W. D. Aug. 9, 1910 150 144 Sept. 2, 1910 0.28 *
4. Joseph Sutton et al W. D. Mar. 17, 1910 150 65 Mar. 24, 1910 1.16 *
5. do W. D. Sept.12, 1910 152 146 Oct. 15, 1910 0.13 *
6. Rudolph Mengel & W. W. D. Mar. 17, 1910 150 62 Mar 24, 1910 5.25 *
do Agreement Mar. 17, 1910 Office Land Comm'r.
7. Edward Casper & Anna Casper W. D. Mar. 17, 1910 150 66 Mar. 24, 1910 2.44 *
do Agreement July 7, 1910 Office Land Comm'r.
8. Garrett Simon & W. W. D. Mar. 8, 1910 150 74 Mar. 24, 1910 5.89 *
9. Supervisors Town of Clyman Approval of Plans Sept.13, 1910 Office Land Comm'r. Area included in Parcel #8.
10. Henry C. Flohr & W. W. D. Feb. 23, 1910 150 76 Mar. 24, 1910 7.44 *
do Agreement Mar. 8, 1910 Office Land Comm'r.
11. Robert C. Drake & W. W. D. Mar. 17, 1910 150 63 Mar. 24, 1910 3.67 *
12. Edurd Weber & W. W. D. Mar. 8, 1910 150 71 Mar. 24, 1910 5.74 *
13. John Helling et al W. D. Mar. 17, 1910 150 86 May 7, 1910 5.63 *
do Release Aug. 7, 1911 23 187 Sept. 12, 1911 Release of Crossing.
14. Supervisors Town of Clyman Order Aug. 7, 1911 Office of Town Clerk Order changing highway, area included in parcel #13. 5.70 *
15. Joseph Brigowatz & W. W. D. Mar. 17, 1910 150 81 May 7, 1910
do Release Mar. 21, 1911 Office Land Comm'r.
16. Otto Vollmann & W. W. D. Mar. 17, 1910 150 49 Mar. 24, 1910 8.93 *
do Agreement Mar. 17, 1910 Office Land Comm'r.
do Release Jan. 5, 1911 Office Land Comm'r.
17. Mrs. Emma Muehner W. D. Mar. 8, 1910 150 51 Mar. 24, 1910 Release of Damage.
M. E. Burke, Spec. Guar. S. D. D. Mar. 8, 1911 150 405 Mar. 24, 1910 17A (3.15 acres) bought with parcel 17 3.65 *
E. H. Markham Release Mar. 21, 1910 Office Land Comm'r. since sold.
18. Emma Muehner C. C. D. June 28, 1910 143 418 July 25, 1910 Tenants Release.
M. E. Burke, Spec. Guar. R. C. D. June 28, 1910 150 414 July 25, 1910 0.24 *
19. O. W. Volkmann & W. W. D. July 1, 1914 160 117 July 13, 1914
20. Tyler H. Andrews & W. W. D. Mar. 29, 1910 150 80 May 7, 1910 0.42 *
21. do W. D. Nov. 1, 1910 150 148 Nov. 25, 1910 3.81 *
22. Supervisors Town of Clyman Order Nov. 12, 191- Office Land Comm'r. 0.55 *
Supervisors Town of Lowell Order Nov. 1, 1910 do Vacation and dedication of Highway. Area included in other parcels.
do Approval Oct. 12, 191- do
23. Theodore P. Wolf & W. W. D. Mar. 24, 191- 70 130 June 16, 1910 7.57 *
TOWN 10 N
RANGE 16E
RANGE 14E
Otto and Mathilda Vollmann
Rob Huebner Estate
Theo. Schraven
REJECTED LOCATION
Edward Weber
Joseph Brigowatz
Robert C. Drake
Edward Kasper
Garret Simon
Henry Flohr
Frank Helling
Rudolph Mengel
Joseph Sutton & John W. Sutton
Joseph Waterhouse
Theodore P. Wolf
Tyler H. Andrews
Frank Henne
FINAL LOCATION
CLYMAN JCT.
NOTE: DOTTED LINE SHOWS REJECTED LOCATION.
State of Illinois.
County of Cook.
I, the undersigned, officer of the Chicago and North-Western Railway do hereby certify that this is a correct map, in a series of 26 primary sheets and 6 supplemental sheets of said railway from survey station 2307+614 to survey station 7719+118 Madison Division, State of Wisconsin, prepared from the records of said company.
Correct: Geo. W. Hands, Valuation Engineer.
M. M. Kinsley, Chief Engineer.
Subscribed and sworn to before me, this 24th day of February, 1917.
Notary Public in and for the County of Cook, State of Illinois.
My commission expires May 11 1918.
RIGHT OF WAY AND TRACK MAP
CHICAGO AND NORTH-WESTERN RAILWAY
OPERATED BY THE
C. & N-W. RY. CO.
MADISON DIVISION
CLYMAN JCT. WIS. TO WYEVILLE, WIS.
STA. 2307+614 TO STA. 2518+814
SCALE 1 IN. = 400 FT. JUNE 30, 1917
OFFICE OF CHIEF ENGINEER
CHICAGO, ILL.