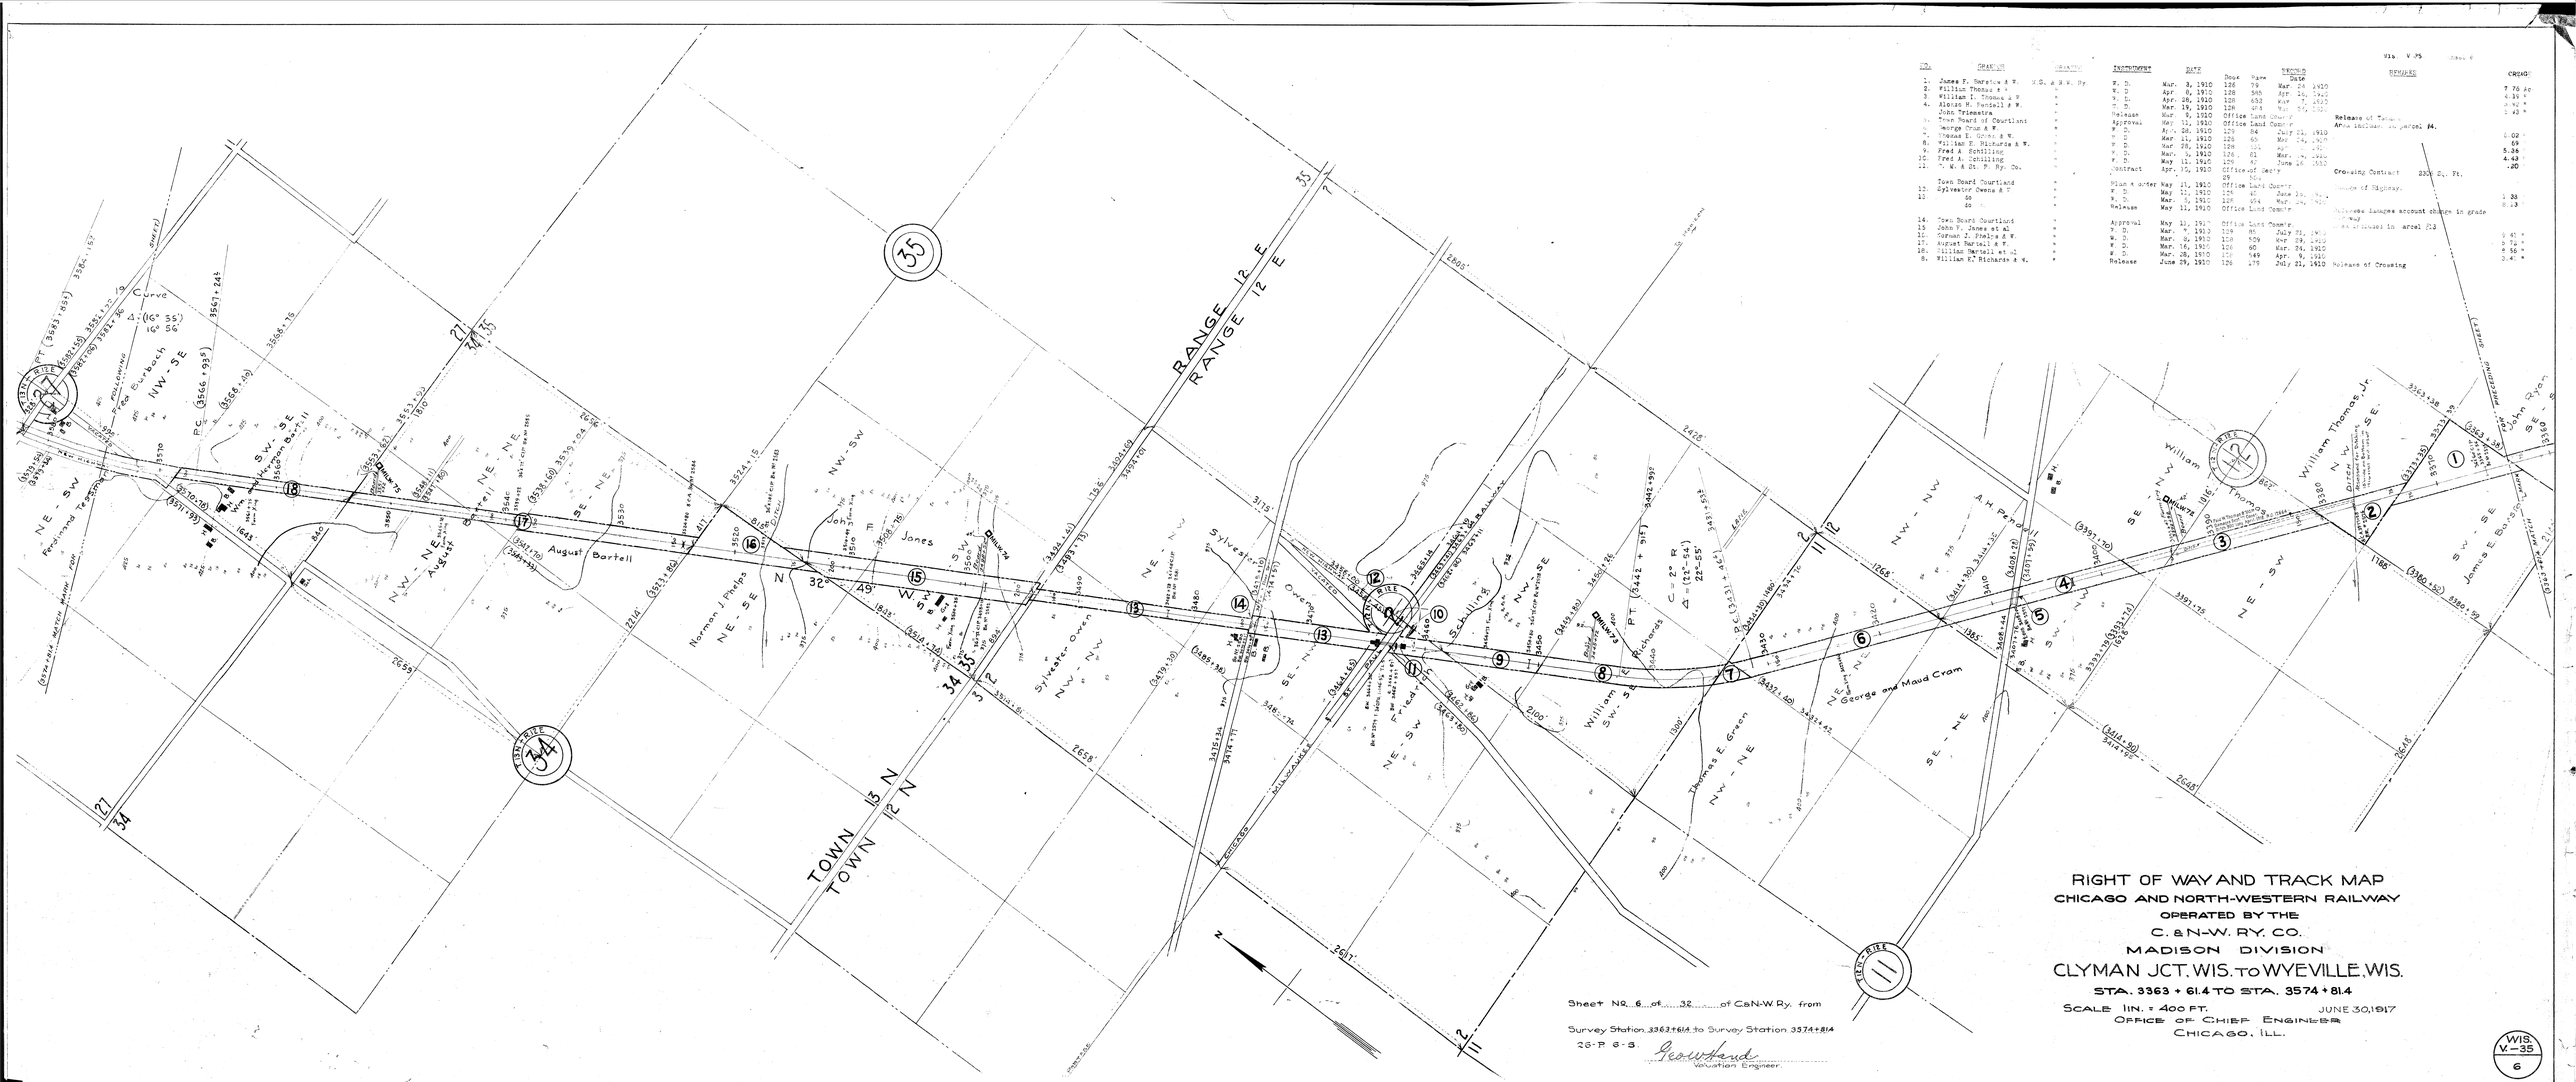

No.	Grantor	Grantee	Instrument	Date	Book	Page	Recorded Date	Remarks	Credit
1.	James F. Barstow & W.	C.St.P.M.& O. Ry.	W. D.	Mar. 3, 1910	128	79	Mar. 24, 1910		7.76 Ac
2.	William Thomas & "	"	W. D.	Apr. 8, 1910	128	545	Apr. 14, 1910		1.15 "
3.	William L. Thomas & W.	"	W. D.	Apr. 28, 1910	128	652	May 7, 1910		2.92 "
4.	Alonzo H. Pendell & W.	"	W. D.	Mar. 19, 1910	128	403	Mar. 30, 1910		1.43 "
5.	John Trimestra	"	Release	Mar. 8, 1910	Office Land Comm'r			Release of Taking	
6.	Town Board of Courtland	"	Approval	May 12, 1910	Office Land Comm'r			Anna Hallman as parcel #4.	
7.	George Cram & W.	"	W. D.	Apr. 28, 1910	129	84	July 21, 1910		4.02 "
8.	Thomas E. Green & W.	"	W. D.	Mar 11, 1910	128	63	Mar 24, 1910		69
9.	William E. Richards & W.	"	W. D.	Mar 28, 1910	128	521	Apr " "		5.38 "
10.	Fred A. Schilling	"	W. D.	Mar. 9, 1910	128	61	Mar. " "		4.43 "
11.	C. M. & St. P. Ry. Co.	"	Contract	Apr. 10, 1910	128	67	June 28 1910		.20
					Office of Sec'y			Crossing Contract 2350 Sq. Ft.	
	Town Board Courtland	"			29	504			
12.	Sylvester Owens & W.	"	Plan & order	May 21, 1910	Office Land Comm'r			Change of Highway.	
13.	" do "	"	W. D.	May 12, 1910	128	47	June 24, 1910		1.33 "
	" do "	"	Release	May 11, 1910	Office Land Comm'r				8.13 "
14.	Town Board Courtland	"	Approval	May 12, 1910	Office Land Comm'r			Highway	
15.	John Y. Jones et al	"	W. D.	Mar. 7, 1910	129	86	July 21, 1910	Damages included in parcel #13	
16.	Norman J. Phelps & W.	"	W. D.	Mar. 8, 1910	128	509	Mar 29, 1910		9.41 "
17.	August Bartell & W.	"	W. D.	Mar. 16, 1910	128	60	Mar. 24, 1910		9.72 "
18.	William Bartell et al	"	W. D.	Mar. 28, 1910	128	549	Apr. 9, 1910		8.56 "
19.	William H. Richards & W.	"	Release	June 29, 1910	128	478	July 21, 1910	Release of Crossing	3.47 "

Sheet No. 6 of 32 of C&N-W Ry. from Survey Station 3363+61.4 to Survey Station 3574+81.4

26-P 8-3.

Geo. Wehrend
Valuation Engineer.

RIGHT OF WAY AND TRACK MAP
CHICAGO AND NORTH-WESTERN RAILWAY
OPERATED BY THE
C. & N-W. RY. CO.
MADISON DIVISION
CLYMAN JCT. WIS. TO WYEVILLE, WIS.
STA. 3363 + 61.4 TO STA. 3574 + 81.4

SCALE 1 IN. = 400 FT. JUNE 30, 1917

OFFICE OF CHIEF ENGINEER
CHICAGO, ILL.

WIS. V-35
6