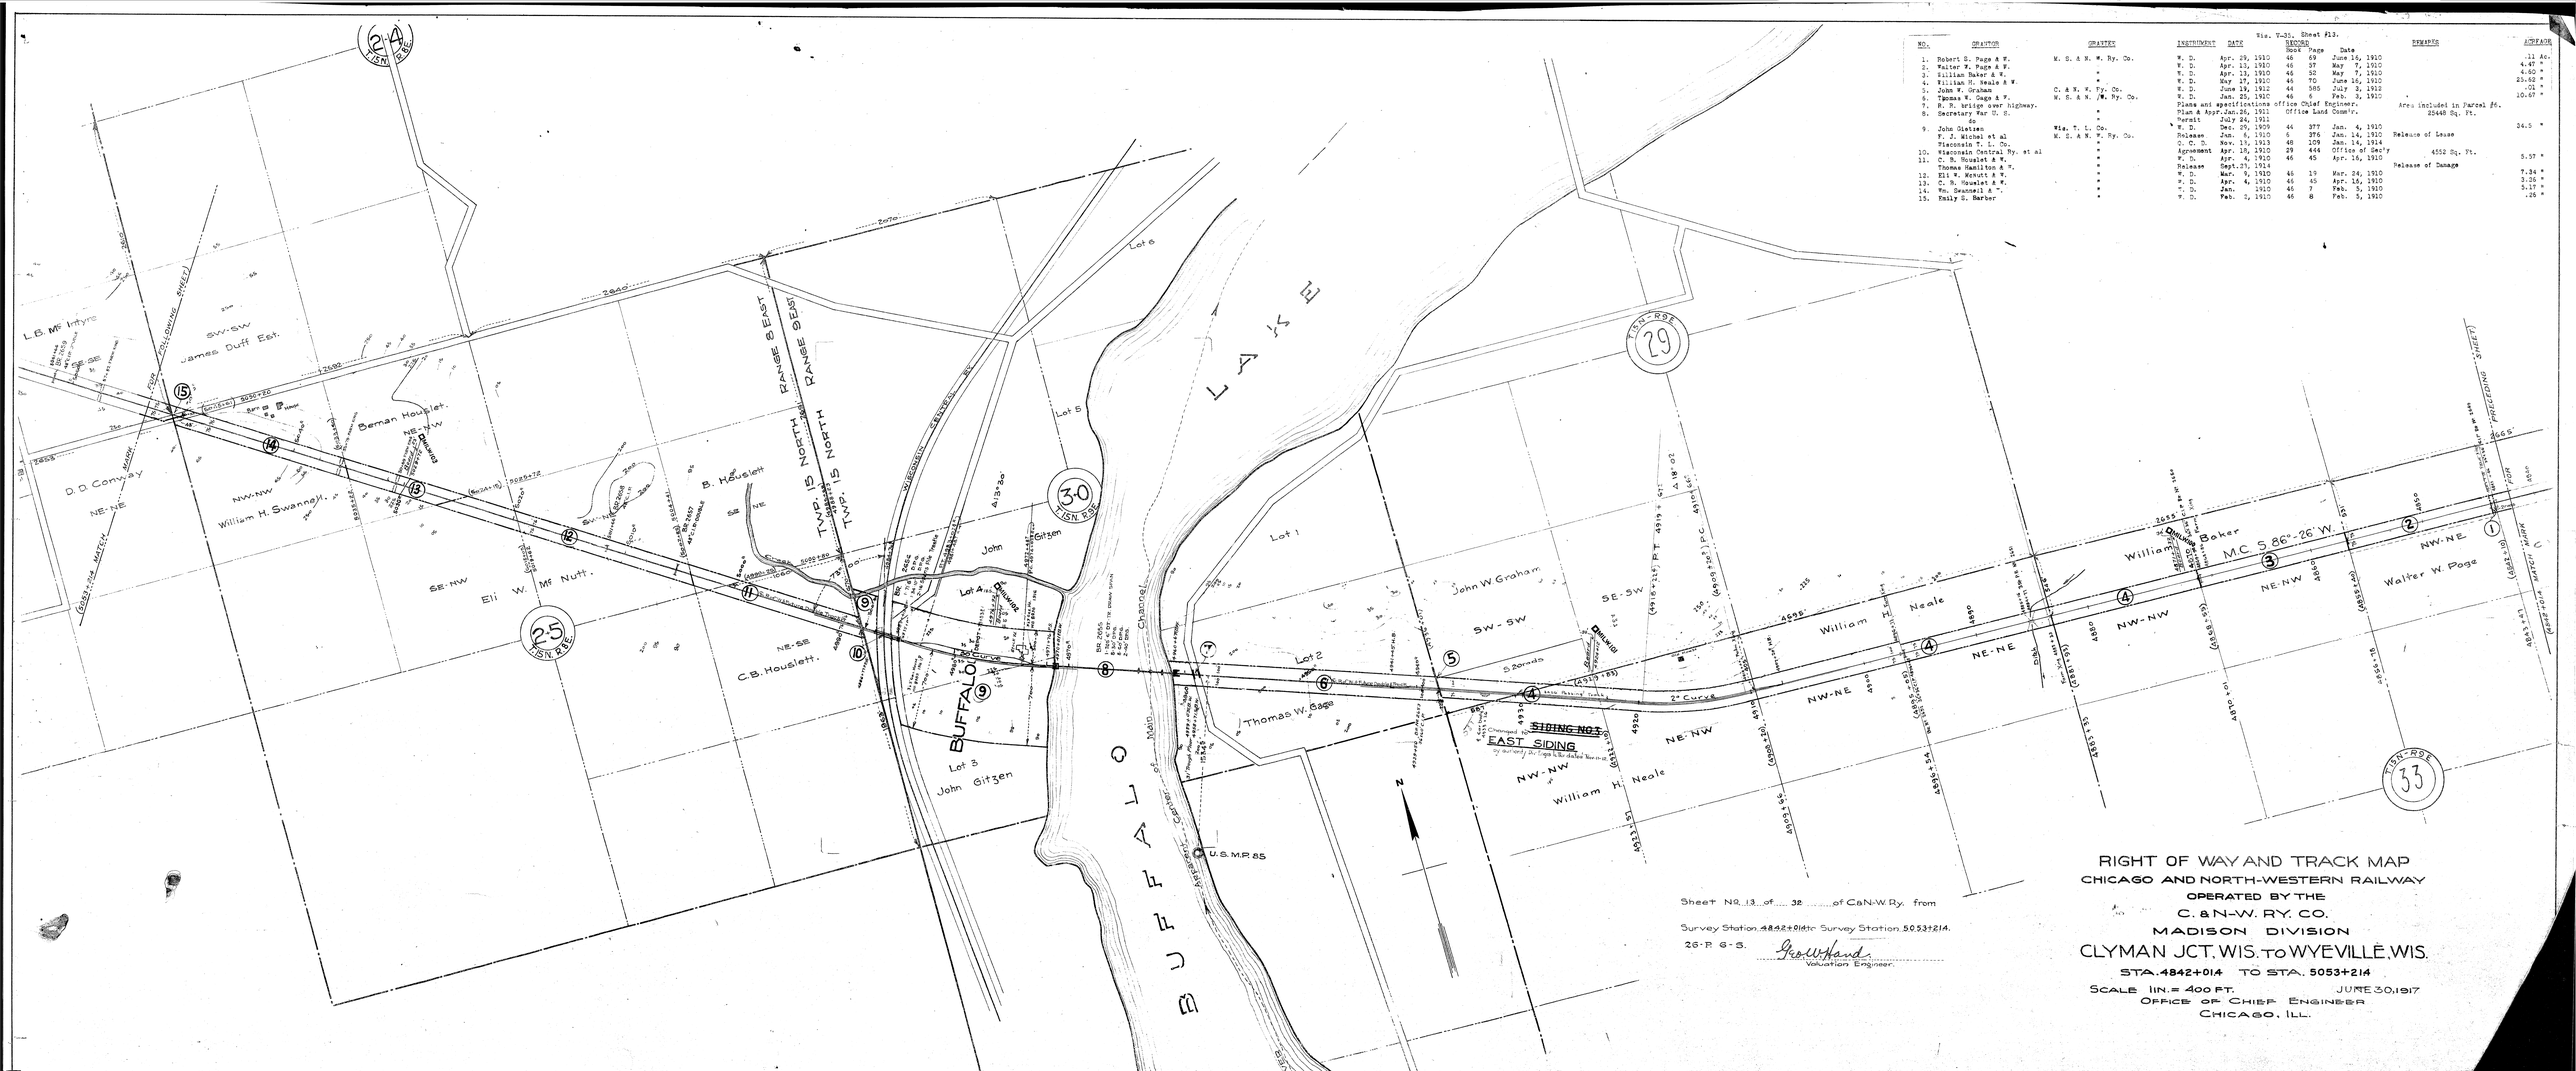

NO.	GRANTOR	GRANTEE	INSTRUMENT	DATE	RECORDED Book	Page	Date	REMARKS	ACREAGE
1.	Robert S. Page & W.	W. S. & N. W. Ry. Co.	W. D.	Apr. 29, 1910	46	69	June 16, 1910		.11 Ac.
2.	Walter W. Page & W.	"	W. D.	Apr. 13, 1910	46	37	May 7, 1910		4.47 *
3.	William Baker & W.	"	W. D.	Apr. 13, 1910	46	52	May 7, 1910		4.60 *
4.	William H. Neale & W.	"	W. D.	May 17, 1910	46	70	June 16, 1910		23.62 *
5.	John W. Graham	C. & N. W. Ry. Co.	W. D.	June 19, 1912	44	385	July 2, 1912		.01 *
6.	Thomas W. Gage & W.	W. S. & N. W. Ry. Co.	W. D.	Jan. 25, 1910	46	6	Feb. 3, 1910		10.69 *
7.	M. R. bridge over highway.	"	Plans and specifications office Chief Engineer.					Area included in Parcel #6.	
8.	Secretary War U. S.	"	Plan & Appr.	Jan. 26, 1911	Office Land Comm'r.			25448 Sq. Ft.	
	do	"	Permit	July 24, 1911					
9.	John Gietzen	Wis. T. L. Co.	W. D.	Dec. 29, 1909	44	377	Jan. 4, 1910		34.5 *
	F. J. Michel et al	W. S. & N. W. Ry. Co.	Release	Jan. 6, 1910	6	376	Jan. 14, 1910	Release of Lease	
	Wisconsin T. L. Co.	"	C. C. D.	Nov. 13, 1913	48	109	Jan. 14, 1914		
10.	Wisconsin Central Ry. et al	"	Agreement	Apr. 15, 1910	29	444	Office of Secty	4552 Sq. Ft.	
11.	C. B. Houslet & W.	"	W. D.	Apr. 4, 1910	46	45	Apr. 16, 1910		5.57 *
	Thomas Hamilton & W.	"	Release	Sept. 21, 1914				Release of Damage	
12.	Eli W. Mcnutt & W.	"	W. D.	Mar. 9, 1910	46	19	Mar. 24, 1910		7.34 *
13.	C. B. Houslet & W.	"	W. D.	Apr. 4, 1910	46	45	Apr. 16, 1910		3.26 *
14.	Wm. Seanell & W.	"	W. D.	Jan. 1910	46	7	Feb. 5, 1910		5.17 *
15.	Emily G. Barber	"	W. D.	Feb. 3, 1910	46	8	Feb. 5, 1910		.26 *

Wis. V-30, Sheet #13.

RIGHT OF WAY AND TRACK MAP

CHICAGO AND NORTH-WESTERN RAILWAY

OPERATED BY THE

C. & N-W. RY. CO.

MADISON DIVISION

CLYMAN JCT. WIS. TO WYEVILLE, WIS.

STA. 4842+014 TO STA. 5053+214

SCALE 1IN. = 400 FT. JUNE 30, 1917

OFFICE OF CHIEF ENGINEER

CHICAGO, ILL.