Cook County, Ill. V. 36

No.	Grantor	Grantee	Instrument	Date	Book	Page	Recrd Date	Remarks	Acreage
1.	C. St. P. M. & O. Ry. Co.	M.S. & N.W. Ry.	Deed	June 14, 1910	93	416	July 21, 1910		1.55 Ac.
2.	Christian C. Stechelt & W.	"	W. D.	Mar. 18, 1910	29	153	Mar. 24, 1910		6.24 "
3.	Supervisors Town of Pyota	"	Resolution	June 30, 1911	Office Land Comm'r.			Resolution approving plans for changing grade of highway - no area	
4.	Christian C. Stechelt & W.	"	W. D.	Apr. 7, 1911	29	217	Apr. 25, 1911		8.75 "
	Skandia Norwegian Ev.Luth. Assn.	"	Release	Apr. 7, 1911	5	393-7	Apr. 25, 1911	Release of Damage	53.40 "
5.	A. T. Meadows & W.	"	W. D.	May 10, 1911	103	373	June 2, 1911		29.02 "
6.	Robert D. Buchan & W.	"	W. D.	Apr. 17, 1911	29	215	Apr. 25, 1911		8.04 "
7.	John D. Wood & W.	"	W. D.	Mar. 17, 1910	29	149	Mar. 24, 1910		
	Addison J. Wood & W.	"	W. D.	Mar. 17, 1910	29	150	Mar. 24, 1910		2.97 "
8.	Charley O. Wood et al	"	W. D.	Mar. 17, 1910	29	148	Mar. 24, 1910		2.23 "
9.	George Deer - Indian Allotment	"	Approval	Sept.14, 1910	Office Land Comm'r.			Approval of Dept. of Interior	1.01 "
10.	Clarence O. Root & W.	"	W. D.	Mar. 18, 1910	29	152	Mar. 24, 1910		3.18 "
11.	Frank A. Bennett et al	"	W. D.	Mar. 18, 1910	29	151	Mar. 24, 1910		5.38 "
12.	John M. Anderson	"	W. D.	Apr. 6, 1910	29	170	Apr. 11, 1910		1.21 "
13.	Erik Jensen & W.	"	W. D.	Mar. 18, 1910	29	154	Mar. 24, 1910		7.25 "
14.	F. E. Stuart & Emma W. Stuart	"	W.D.	Mar. 25, 1910	29	168	Apr. 11, 1910		1.42 "
15.	Bert D. Steele & W.	"	W. D.	Mar. 18, 1910	29	157	Mar. 24, 1910		5.84 "
16.	Henry Keaton & W.	"	W. D.	Mar. 19, 1910	29	155	Mar. 24, 1910		4.83 "
17.	Louisa Fuhrman	"	W. D.	Mar. 23, 1910	29	167	Apr. 11, 1910		5.67 "
18.	George S. Miller	"	T. D.	Mar. 19, 1910	29	156	Mar. 24, 1910		0.41 "
19.	Sarah M. Graham	"	W. D.	Mar. 19, 1910	29	147	Mar. 24, 1910		5.97 "
20.	John Weitstein & W.	"	W. D.	Mar. 22, 1910	29	169	Apr. 11, 1910		
	Jo et al		Release	Oct. 10, 1910	9	303	Nov. 24, 1910	Release of Crossing	3960 Sq. Ft.
21.	C. M. & St. P. Ry. Co.	"	Contract	Apr. 10, 1910	29	304	Office of Secretary		

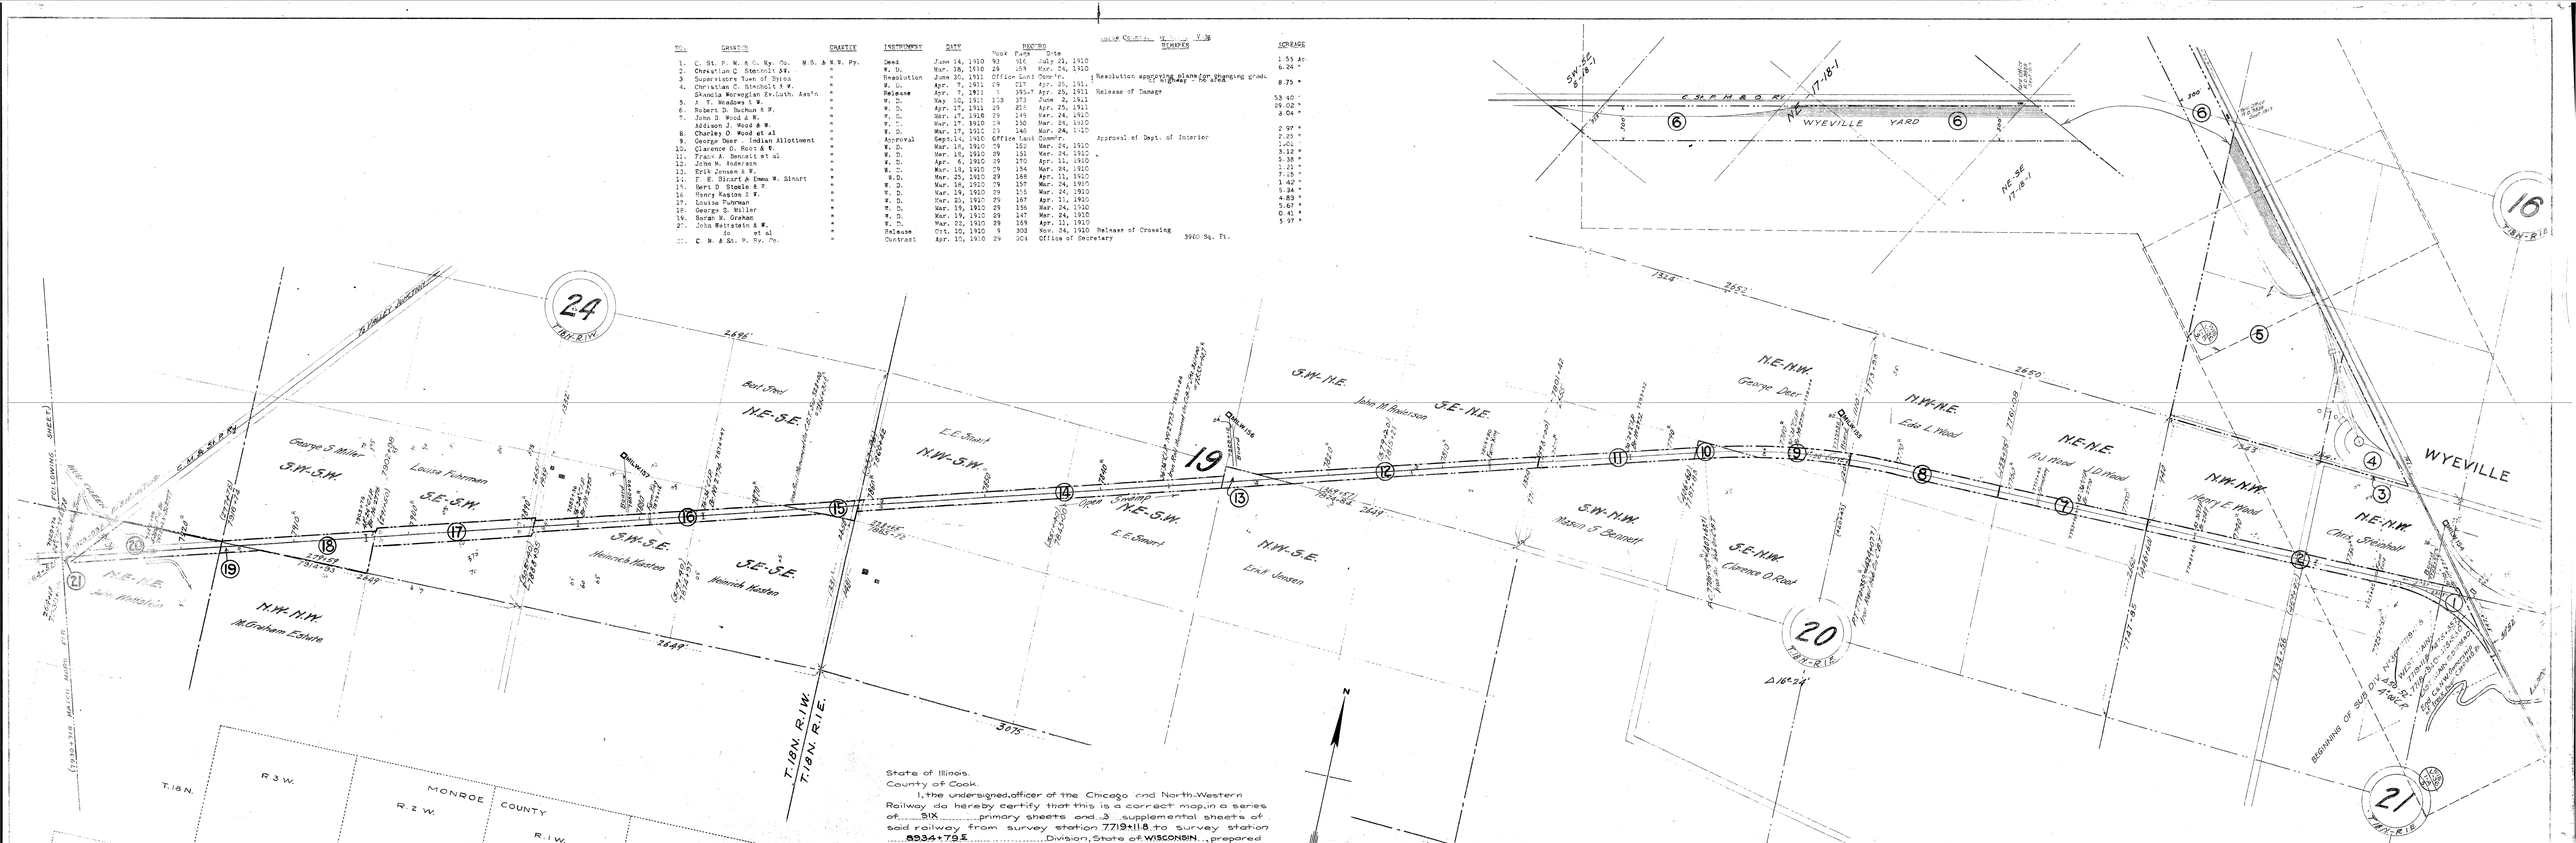

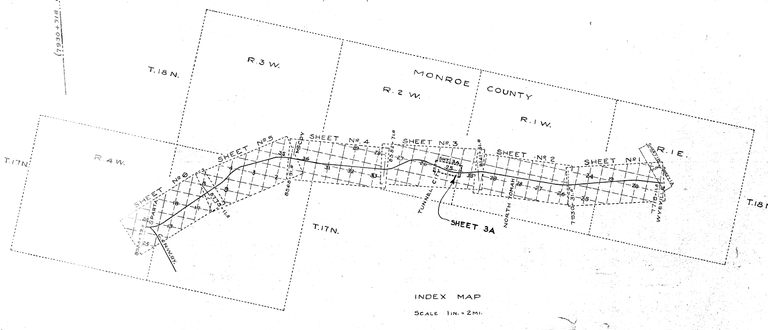

INDEX MAP

SCALE 1 IN. = 2 MI.

State of Illinois.
County of Cook.

I, the undersigned, officer of the Chicago and North-Western Railway do hereby certify that this is a correct map, in a series of six primary sheets and 3 supplemental sheets of said railway from survey station 7719+11.8 to survey station 8934+79.5, Division, State of Wisconsin, prepared from the records of said company.

Correct: Grovestand
Valuation Engineer

W. H. Bradley
Chief Engineer

Subscribed and sworn to before me, this 11th day of April, 1916.

Notary Public in and for the County of Cook, State of Illinois.

My commission expires May, 11th, 1918.

Note:-
From curve west of Wyeville to curve west of Tunnel City the original track was built 6½ south of located line.

RIGHT OF WAY AND TRACK MAP
CHICAGO AND NORTH-WESTERN RAILWAY
OPERATED BY THE
C. & N-W. RY. CO.
MADISON DIVISION
WYEVILLE, WIS. TO SPARTA, WIS.
STA. 7719+11.8 TO STA. 7930+31.8

SCALE 1 IN. = 400 FT. JUNE 30, 1917
OFFICE OF CHIEF ENGINEER
CHICAGO, ILL.

WIS V-36