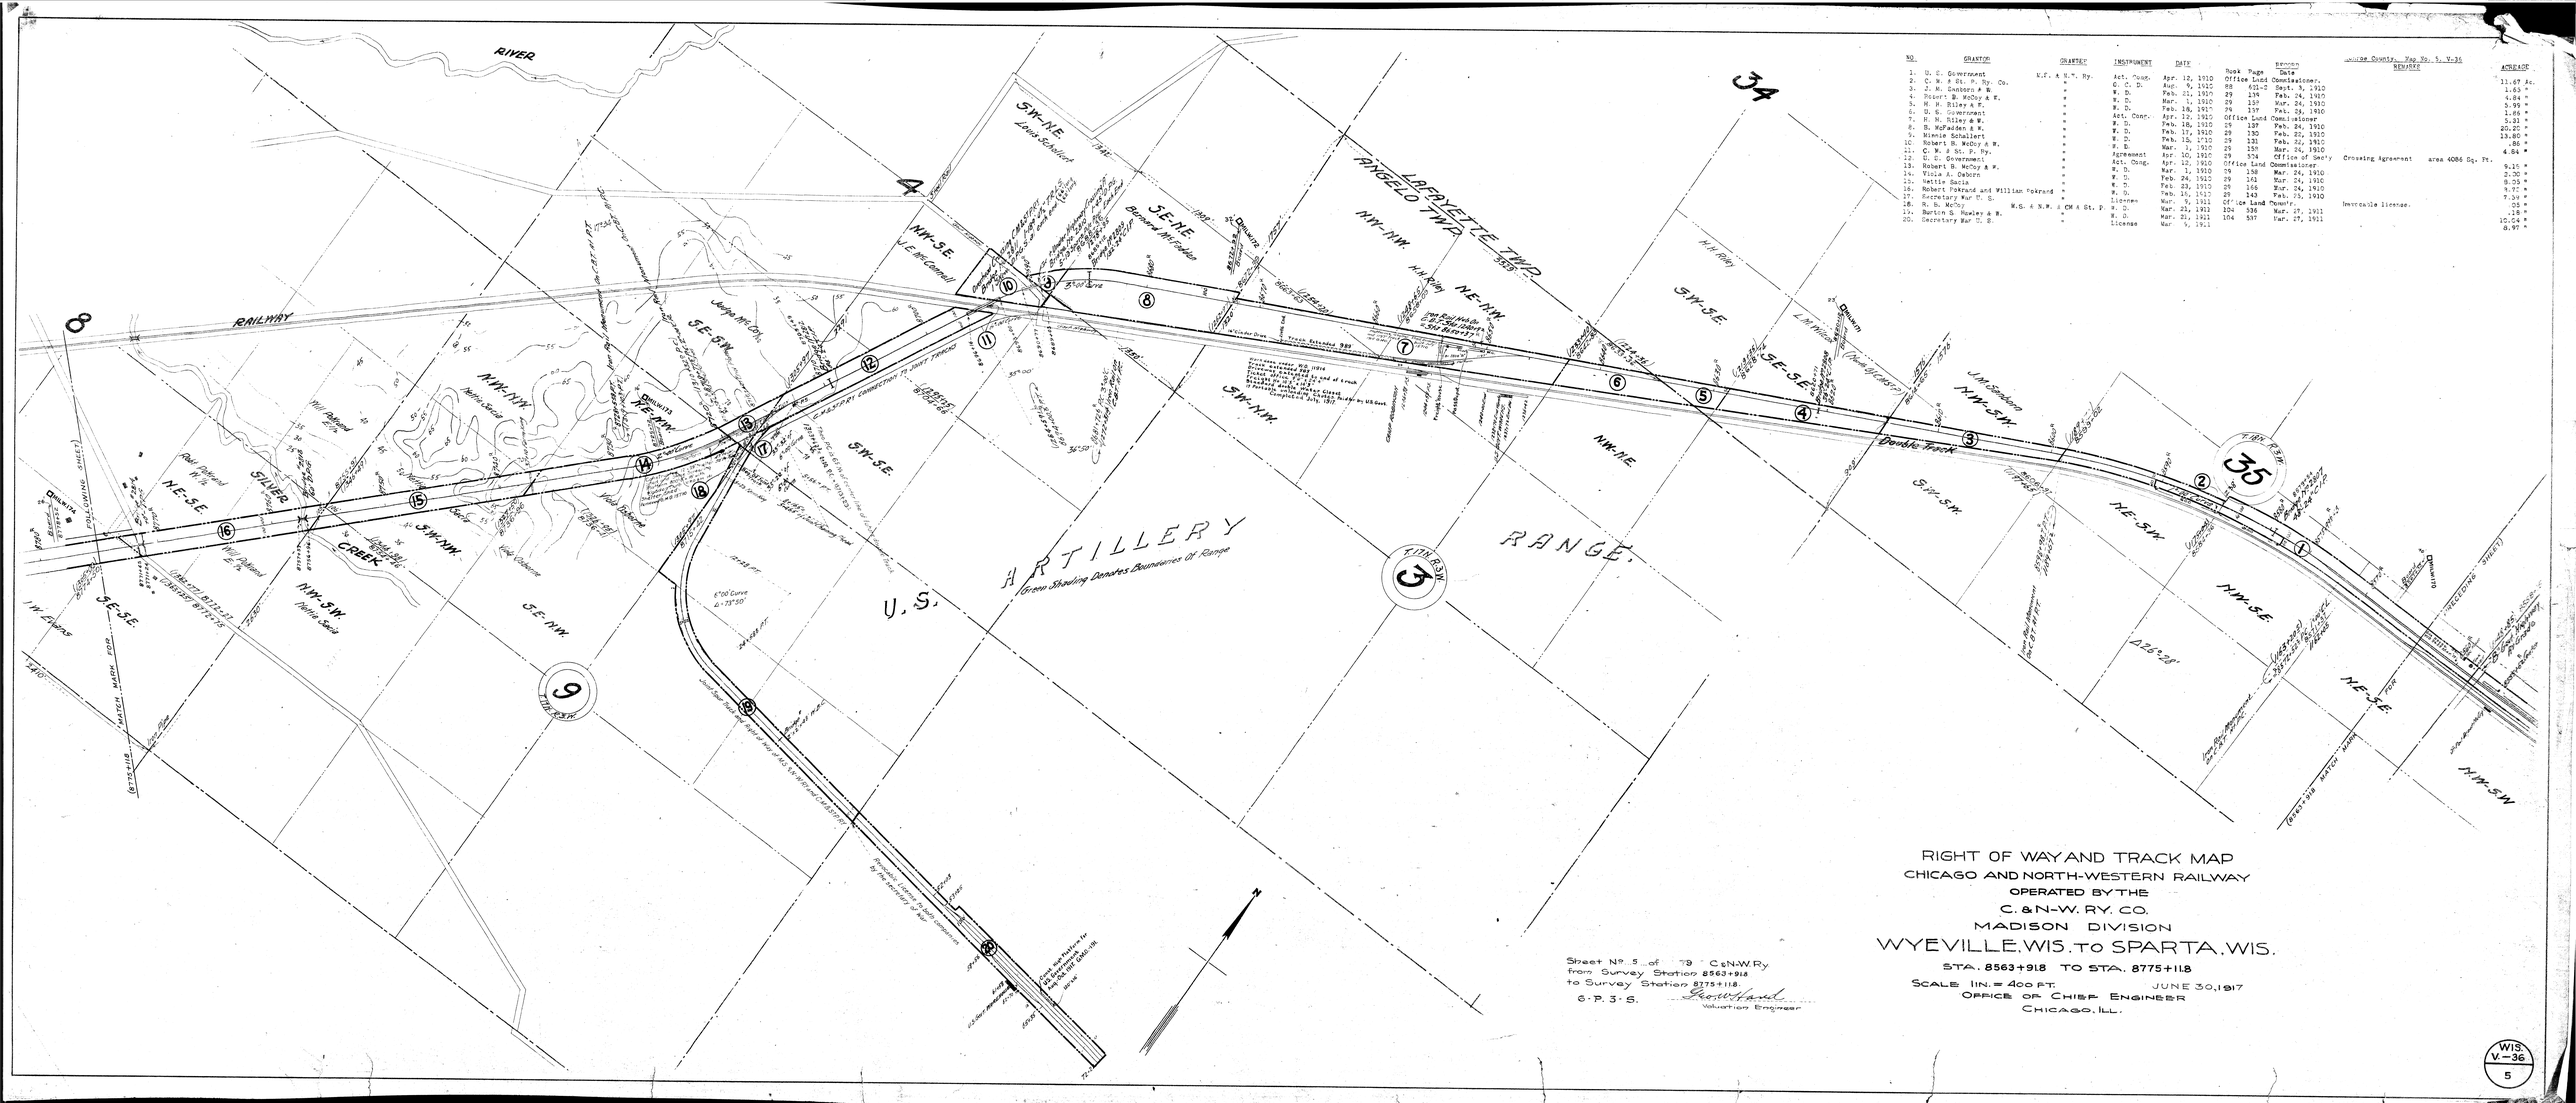
RIVER
RAILWAY
LAFAYETTE TWP.
RANGE
ARTILLERY
U.S.
Green Shading Denotes Boundaries of Range
34
35
4
3
9
8
5W-NE
NW-SE
SE-NE
SW-NE
NW-NW
SE-SW
SW-SE
SW-NW
NW-NE
NE-NW
SE-SE
NE-SW
NW-SW
SE-NW
NE-SE
Double Track
