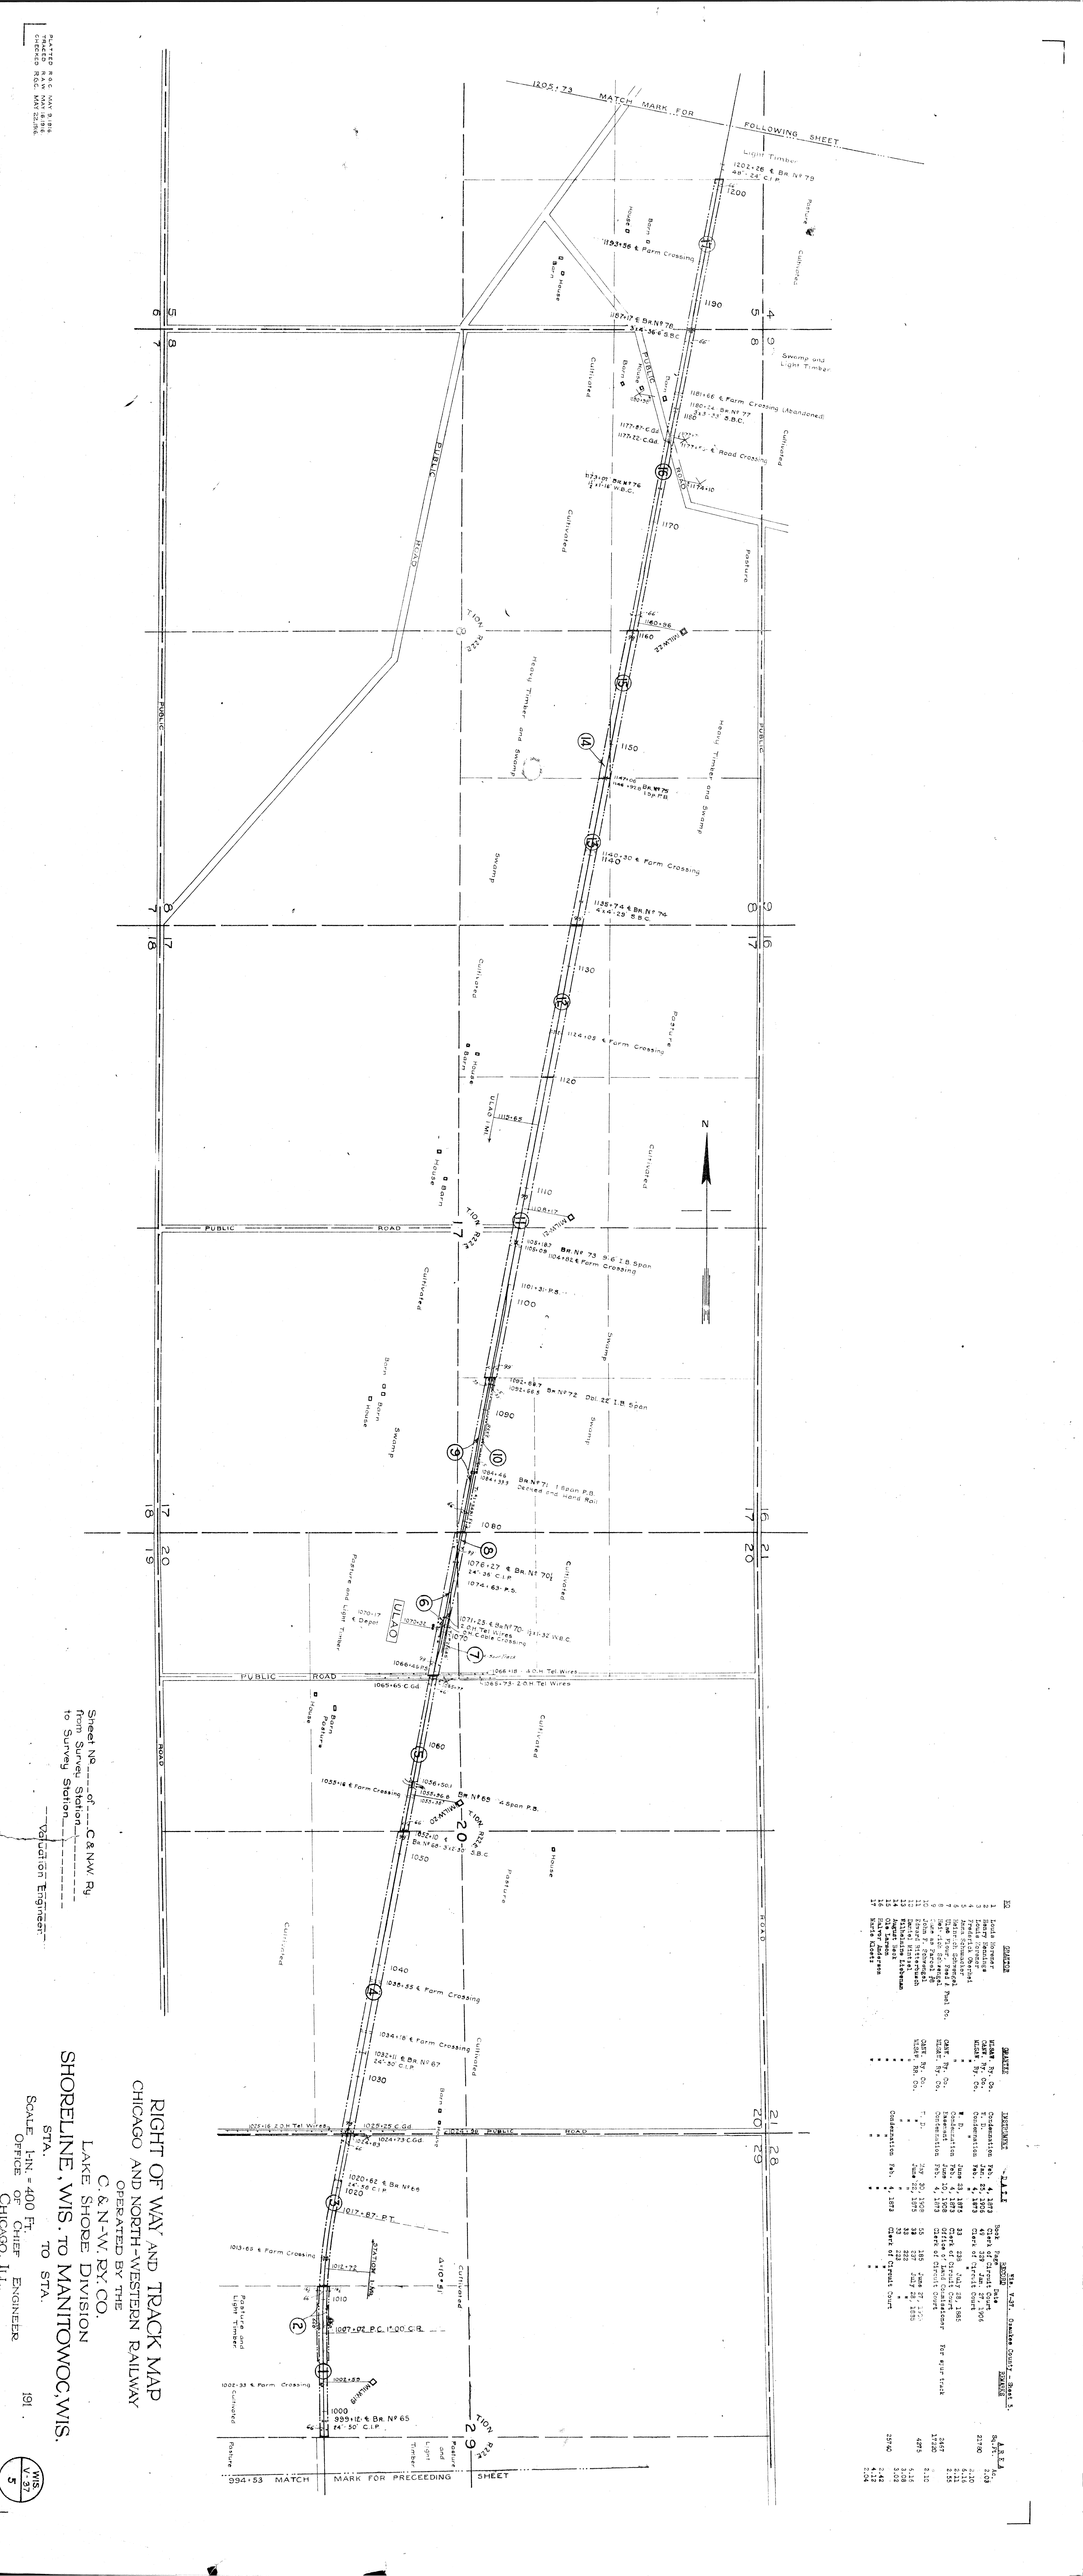

Sheet No. ____ of ____ C & N.W. Ry.
from Survey Station ____
to Survey Station ____

Valuation Engineer.

RIGHT OF WAY AND TRACK MAP
CHICAGO AND NORTH-WESTERN RAILWAY
OPERATED BY THE
C. & N.-W. RY. CO.
LAKE SHORE DIVISION
SHORELINE, WIS. TO MANITOWOC, WIS.
STA. TO STA.

SCALE 1 IN. = 400 FT.
OFFICE OF CHIEF ENGINEER
CHICAGO, ILL. 191

WIS. V 37 5

