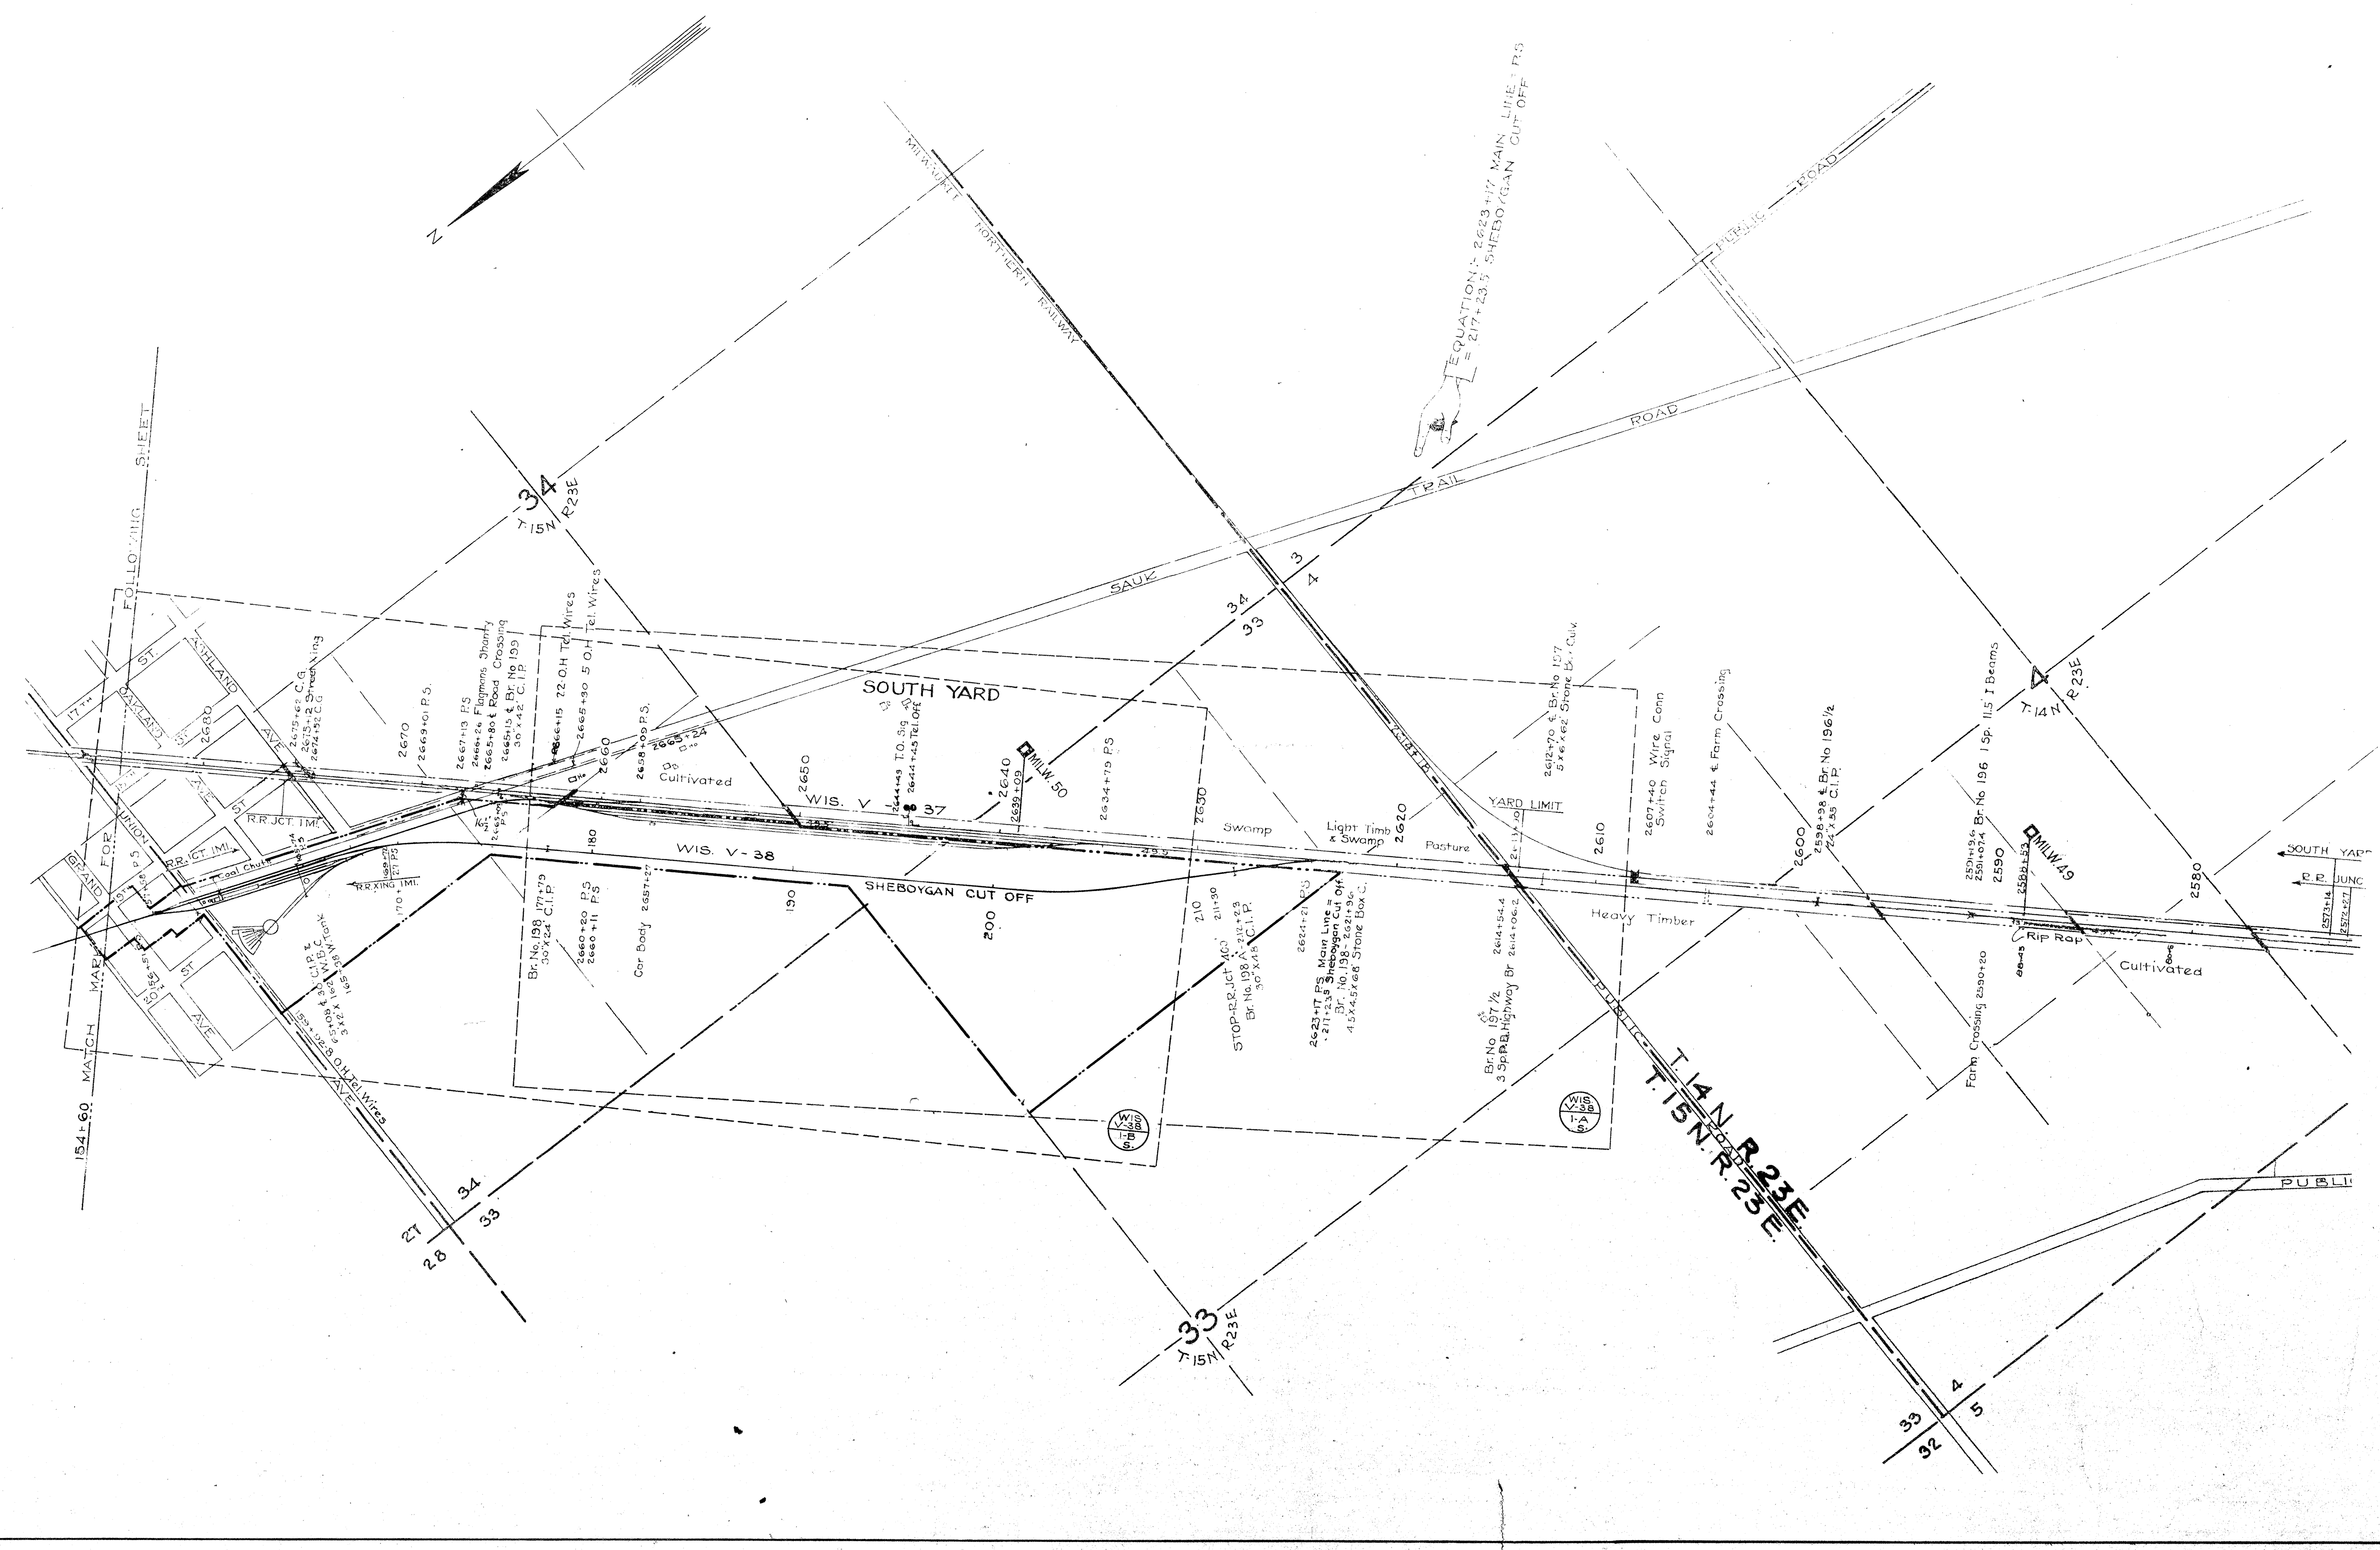


State of Illinois
County of Cook.

I, the undersigned, officer of the Chicago and North Western Railway do hereby certify that this is a corret map, in a series of 2 primary sheets and 8 supplemental sheets of said railway from survey station 217 + 23.5 to survey station 0 + 08 Lake Shore Division, state of Wisconsin prepared from the records of said company.

Correct Geo. W. Hand.
Valuation Engineer.

[signature]
Chief Engineer.

Subscribed and sworn to before me, this 28th day of February 1917.

Solon D. Wilson
Notary Public in and for the
County of Cook
State of Illinois

My commission expires May, 11th 1918.

RIGHT OF WAY AND TRACK MAP
CHICAGO AND NORTH-WESTERN RAILWAY
OPERATED BY THE
C. & N-W. RY. CO.
LAKE SHORE DIVISION
SHEBOYGAN CUT-OFF.
STA. 217 + 23.5 TO STA. 154 + 60

SCALE 1-IN. = 400-FT. JUNE 30, 1917.
OFFICE OF CHIEF ENGINEER
CHICAGO, ILL.

WIS. V-38 1