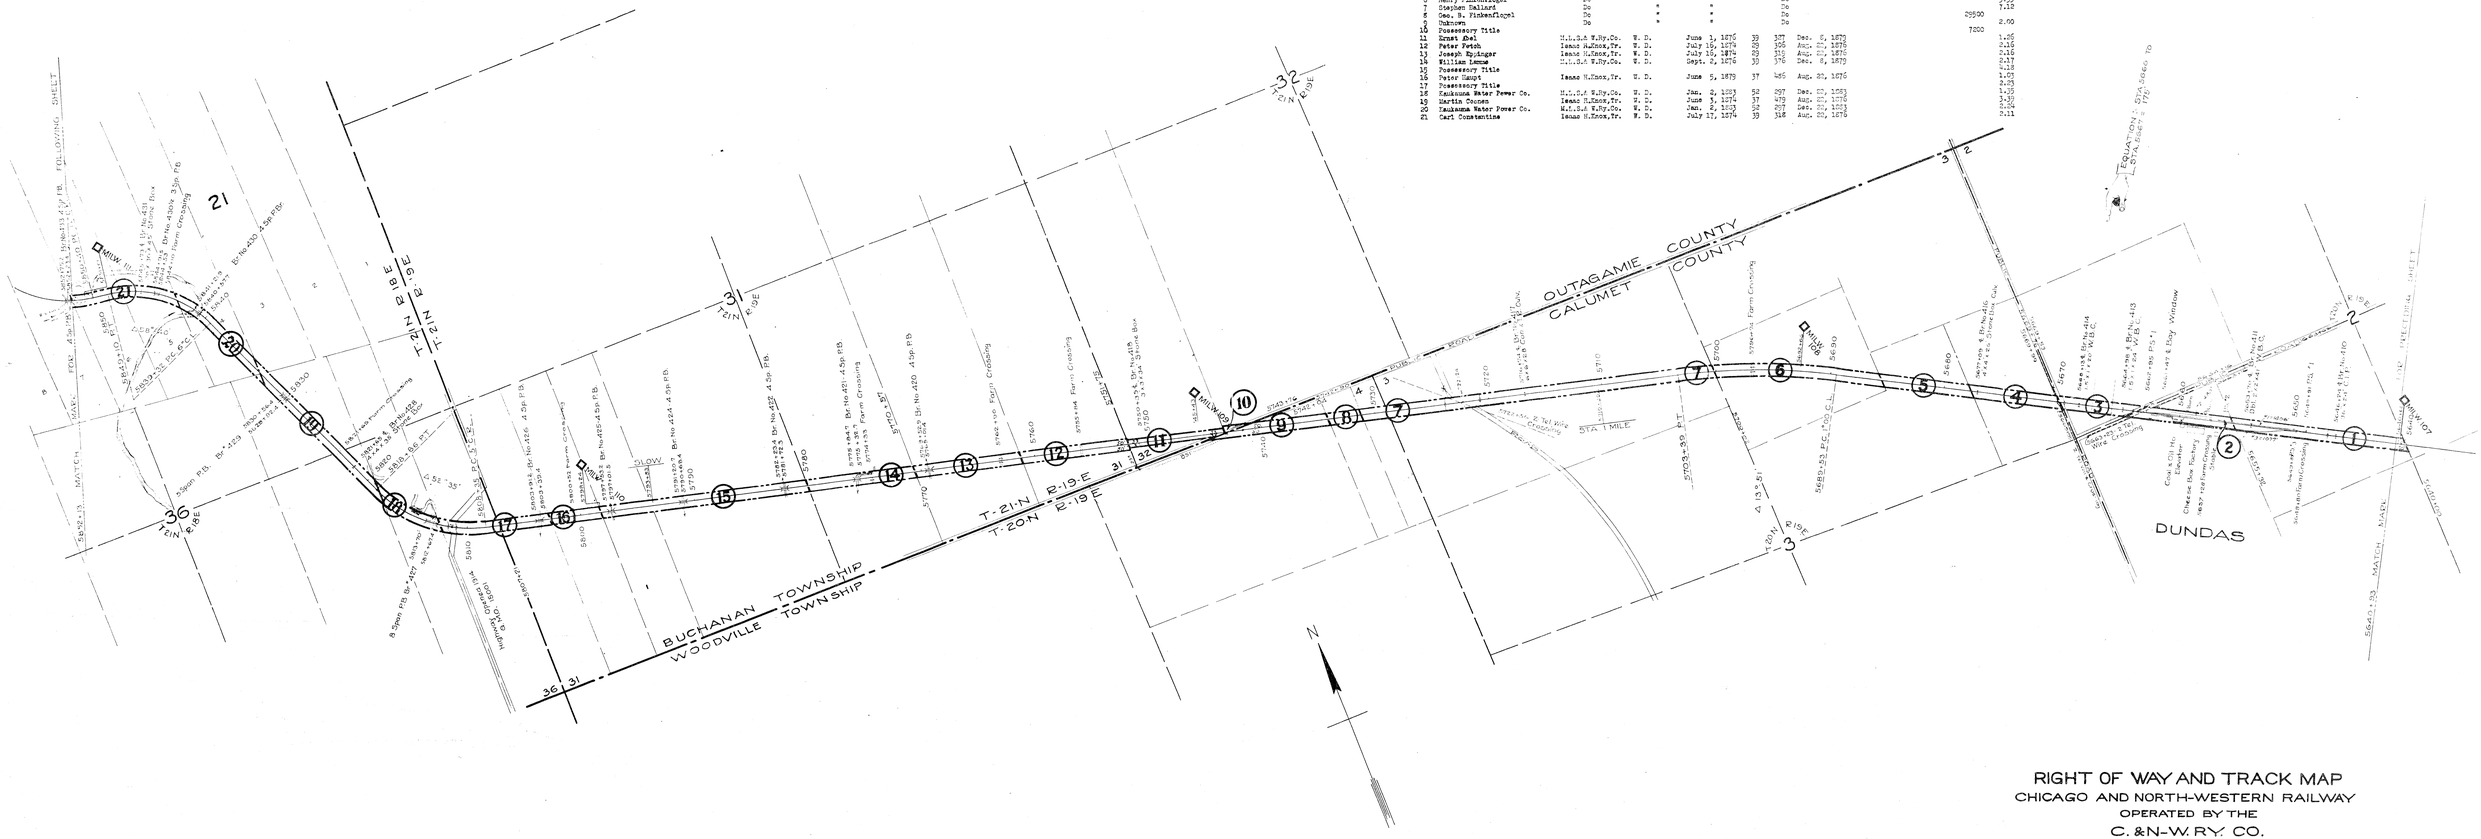

No.	GRANTOR	GRANTEE	INSTRUMENT	DATE	RECORDED Book	Page	Date	REMARKS	A. R. A. Dep't.	Ac.
1	Possessory Title									1.91
2	Gertrude Rolf	A.J. M.L.&Y.Ry.Co.	Condemnation	Apr. 17, 1872	Clerk of Circuit Court					1.92
3	Henry Finkenflogel	Do	"	"	Do					1.27
4	Gerhard Lechmeyer	Do	"	"	Do					1.8
5	Cornelius Verwayst	Do	"	"	Do					1.8
6	Henry Finkenflogel	Do	"	"	Do					3.35
7	Stephen Ballard	Do	"	"	Do					1.12
8	Geo. B. Finkenflogel	Do	"	"	Do				29590	
9	Unknown	Do	"	"	Do					2.00
10	Possessory Title								7200	
11	Ernst Abel	M.L.S.& W.Ry.Co.	W. D.	June 1, 1875	39	327	Dec. 6, 1879			1.26
12	Peter Fetch	Isaac M.Knox,Tr.	W. D.	July 19, 1876	38	306	Aug. 22, 1876			2.16
13	Joseph Eppinger	Isaac M.Knox,Tr.	W. D.	July 19, 1876	38	310	Aug. 22, 1876			2.16
14	William Lemke	M.L.S.& W.Ry.Co.	W. D.	Sept. 2, 1876	30	376	Dec. 8, 1879			2.17
15	Possessory Title									7.18
16	Peter Haupt	Isaac M.Knox,Tr.	U. D.	June 5, 1879	37	496	Aug. 20, 1876			1.03
17	Possessory Title									2.03
18	Kaukauna Water Power Co.	M.L.S.& W.Ry.Co.	W. D.	Jan. 2, 1883	52	297	Dec. 22, 1883			1.05
19	Martin Coenen	Isaac M.Knox,Tr.	W. D.	June 3, 1874	37	479	Aug. 20, 1876			3.30
20	Kaukauna Water Power Co.	W.V.S.A. W.Ry.Co.	W. D.	Jan. 2, 1883	52	297	Dec. 22, 1883			2.04
21	Carl Constantine	Isaac M.Knox,Tr.	W. D.	July 21, 1874	39	348	Aug. 20, 1876			2.11

PLATTED DSL. MAY 16, 1916
TRACED C. H.D. MAY 23, 1916
CHECKED E.P.L. JULY 17 1916

Sheet No. 9 of 26 C. & N-W. Ry.
from Survey Station 5640+93
to Survey Station 5852+13.
10-P. 16-S.
Valuation Engineer

RIGHT OF WAY AND TRACK MAP
CHICAGO AND NORTH-WESTERN RAILWAY
OPERATED BY THE
C. & N-W. RY. CO.
LAKE SHORE DIVISION
MANITOWOC, WIS. to KAUKAUNA, WIS.
STA. 5640+93 TO STA. 5852 + 13
SCALE 1 IN. = 400 FT. JUNE 30, 1917.
OFFICE OF CHIEF ENGINEER
CHICAGO, ILL.

WIS. V-39 9