


ACREAGE	
3.	Ac
4.91	"
1.87	"
1.79	"
3.49	"
6.91	"
5.02	"
5.56	"
7.14	"
7.31	"
5.12	"
2.39	"
5.2	"
4.84	"

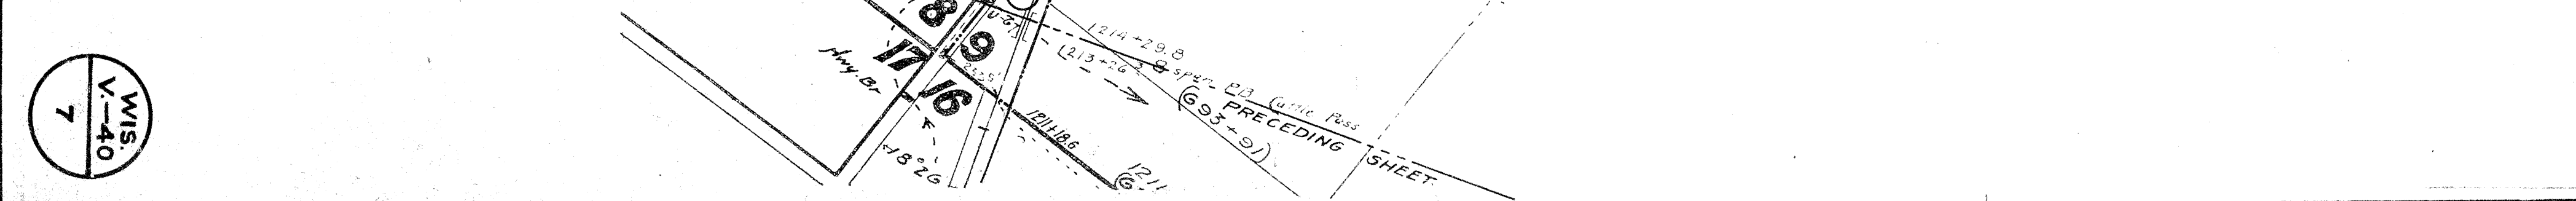

RIGHT OF WAY AND TRACK MAP
CHICAGO AND NORTH-WESTERN RAILWAY
OPERATED BY THE
C. & N-W. RY. CO.
LAKE SHORE DIVISION
MANTOWOC, WIS. TO GREEN BAY, WIS.

Sheet No. 7 of 10 CUNW/Ry
from Survey Station 1214+00
to Survey Station 1425+29
10-F. 0-5. *Handwritten signature*