Sht. V-40, Sheet 8, Brown County.

No.	GRANTOR.	GRANTEE.	INSTRUMENT.	DATE.	Book.	Page.	RECORD. Date.	REMARKS.	ACREAGE.
1.	John C. Eisenman	W. G. B. & N. W. Ry. Co.	W. D.	May 22, 1905	100	371	June 9, 1905		5.83 Ac.
2.	Marie Nelson Abel	"	"	Dec. 11, 1905	103	363	Jan. 26, 1906		3.44 "
3.	Thomas Thompson	"	"	May 9, 1903	100	535	June 9, 1911		2.64 "
4.	Hagemeister Brewing Co.	"	"	July 24, 1905	103	108	Aug. 14, 1905		2.49 "
5.	Michael Gorelanszyk	"	"	Aug. 7, 1905	103	93	Aug. 14, 1905		9.41 "
6.	Hagemeister Brewing Co.	"	"	July 24, 1905	103	108	Aug. 14, 1905		7.58 "
7.	Joseph Alax	"	"	Nov. 15, 1905	103	217	Nov. 24, 1905		6.07 "
8.	Hagemeister Brewing Co.	"	"	July 24, 1905	103	108	Aug. 14, 1905		1.5 "
9.	Frank Calervaerts	"	"	Apr. 18, 1905	100	376	May 1, 1905		3.72 "
10.	Agnes Kuzia	"	"	Apr. 26, 1905	100	464	May 8, 1905		1.07 "
11.	Agnes Norowski	"	Cond.	June 27, 1905	Clk.Cir.Ct.		June 27, 1905		2.55 "
12.	John Klisech	"	W. D.	Apr. 14, 1905	100	368	May 1, 1905		3.31 "
13.	Joseph A. Knoll	"	"	Sept 6, 1905	103	143	Sept 16, 1905	13630 Sq. Ft.	
14.	Edwari Baumgart	"	"	Apr. 21, 1905	100	365	May 1, 1905		3.58 "
15.	John Thaston	"	"	Apr. 24, 1905	100	456	May 8, 1905		1.83 "
16.	Mary Van Der Heiden	"	"	Apr. 20, 1905	100	369	May 1, 1905		2.09 "
17.	Peter Van Yan Roy	"	"	Apr. 24, 1905	100	451	May 8, 1905		1.77 "
	Peter Van Yan Roy	"	Release	Sept 4, 1905	94	317	Oct. 7, 1905	Drainage.	
18.	Lambert Van Boxtel	"	W. D.	Apr. 22, 1905	100	449	May 8, 1905		4.25 "
19.	Joseph Boerschinger	"	"	Apr. 22, 1905	100	443	May 8, 1905	34100 " "	
20.	Lambert Van Boxtel	"	"	Apr. 22, 1905	100	447	May 8, 1905		3.81 "

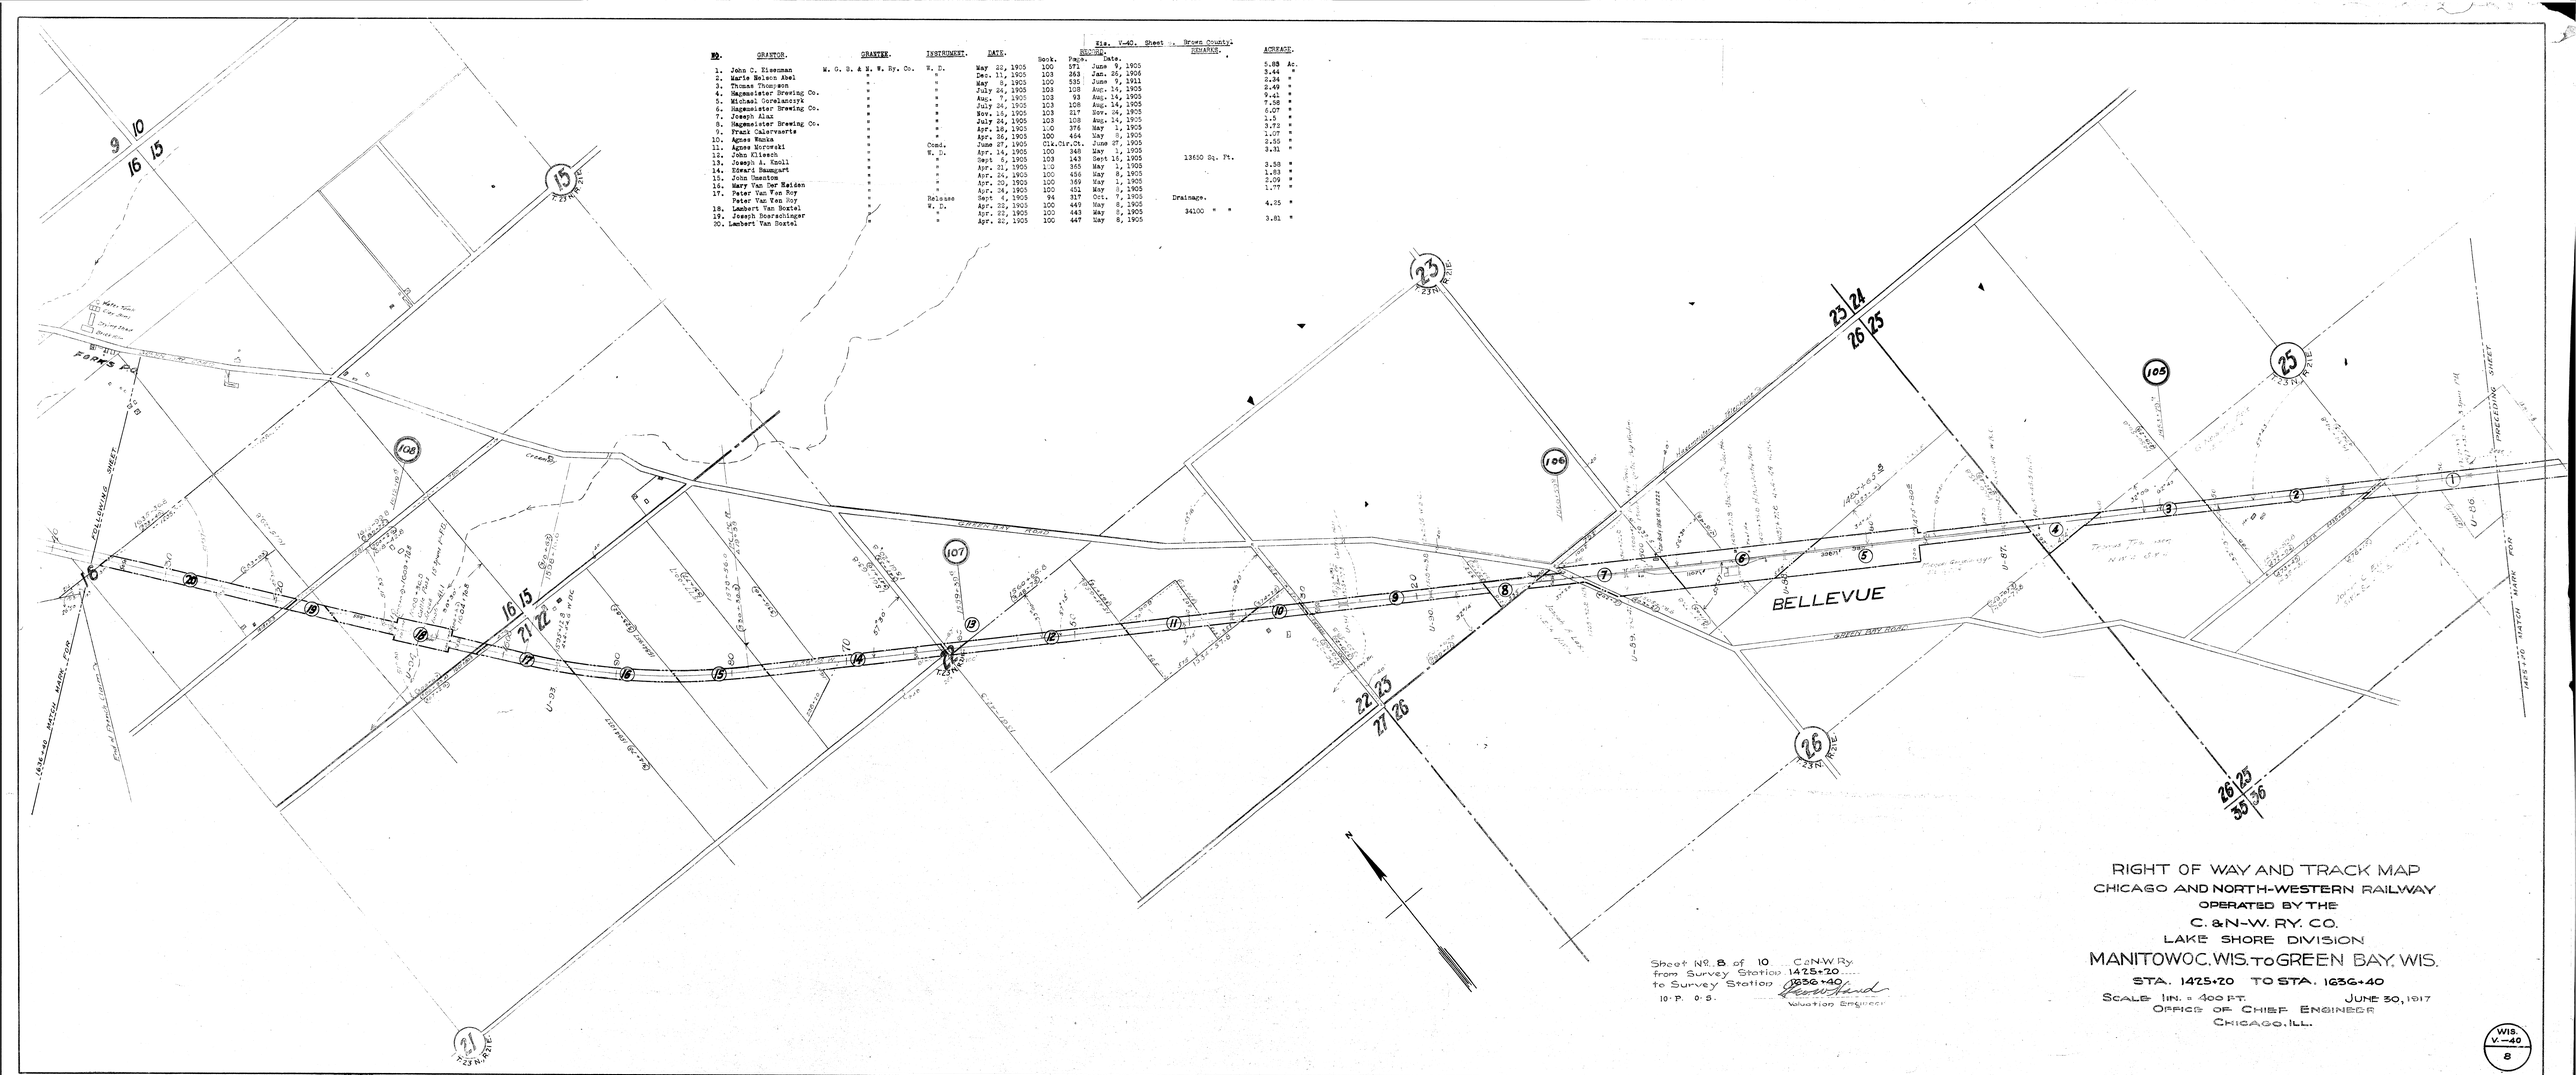

Sheet No. 8 of 10 Sheets
C. & N-W. Ry.
from Survey Station 1425+20
to Survey Station 1636+40
10-P. 0-S.

Valuation Engineer

RIGHT OF WAY AND TRACK MAP
CHICAGO AND NORTH-WESTERN RAILWAY
OPERATED BY THE
C. & N-W. RY. CO.
LAKE SHORE DIVISION
MANITOWOC, WIS. TO GREEN BAY, WIS.
STA. 1425+20 TO STA. 1636+40

SCALE 1 IN. = 400 FT. JUNE 30, 1917
OFFICE OF CHIEF ENGINEER
CHICAGO, ILL.

WIS. V.-40 8