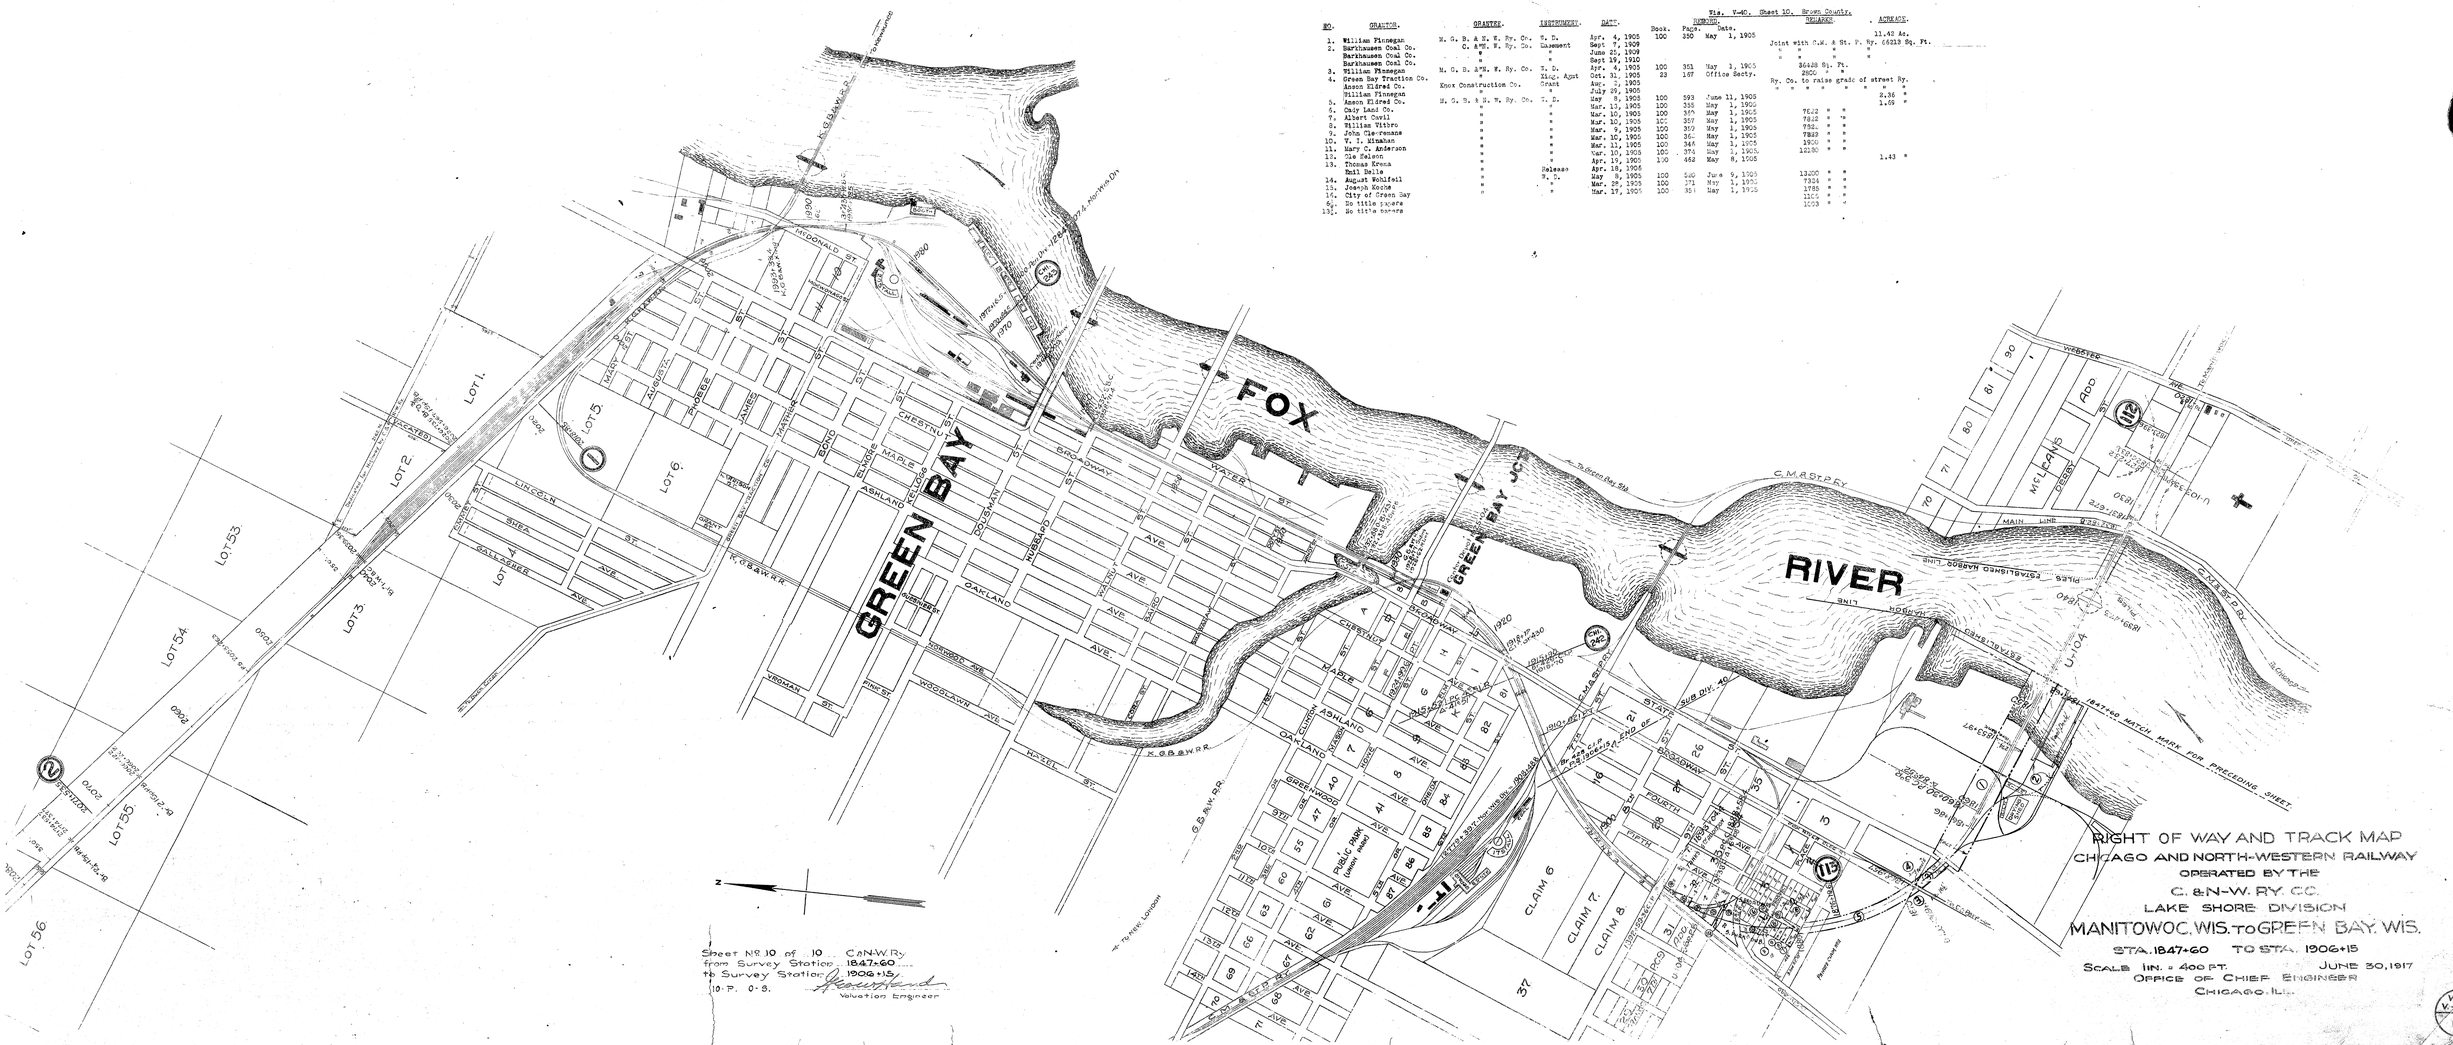
FOX
RIVER
GREEN BAY
GREEN BAY JCT.
K.G.B.&W.R.R.
C.M.&St.P.Ry.
C.&N.W.Ry.
To Green Bay
To Manitowoc
To New London
To Appleton
To Oconto
To Menominee
Lot 1.
Lot 2.
Lot 3.
Lot 4.
Lot 5.
Lot 6.
Lot 53
Lot 54
Lot 55
Lot 56
CLAIM 6
CLAIM 7.
CLAIM 8
Public Park
(Union Hall)
Broadway
Chestnut
Maple
Ashland
Oakland
Greenwood
Fourth
Fifth
Water
Main
Webster
Mc Leans Add
Sub Div. 10
Sub Div. 11
Sub Div. 90
Add
Sta. 1847+60 Match Mark for Preceding Sheet.
