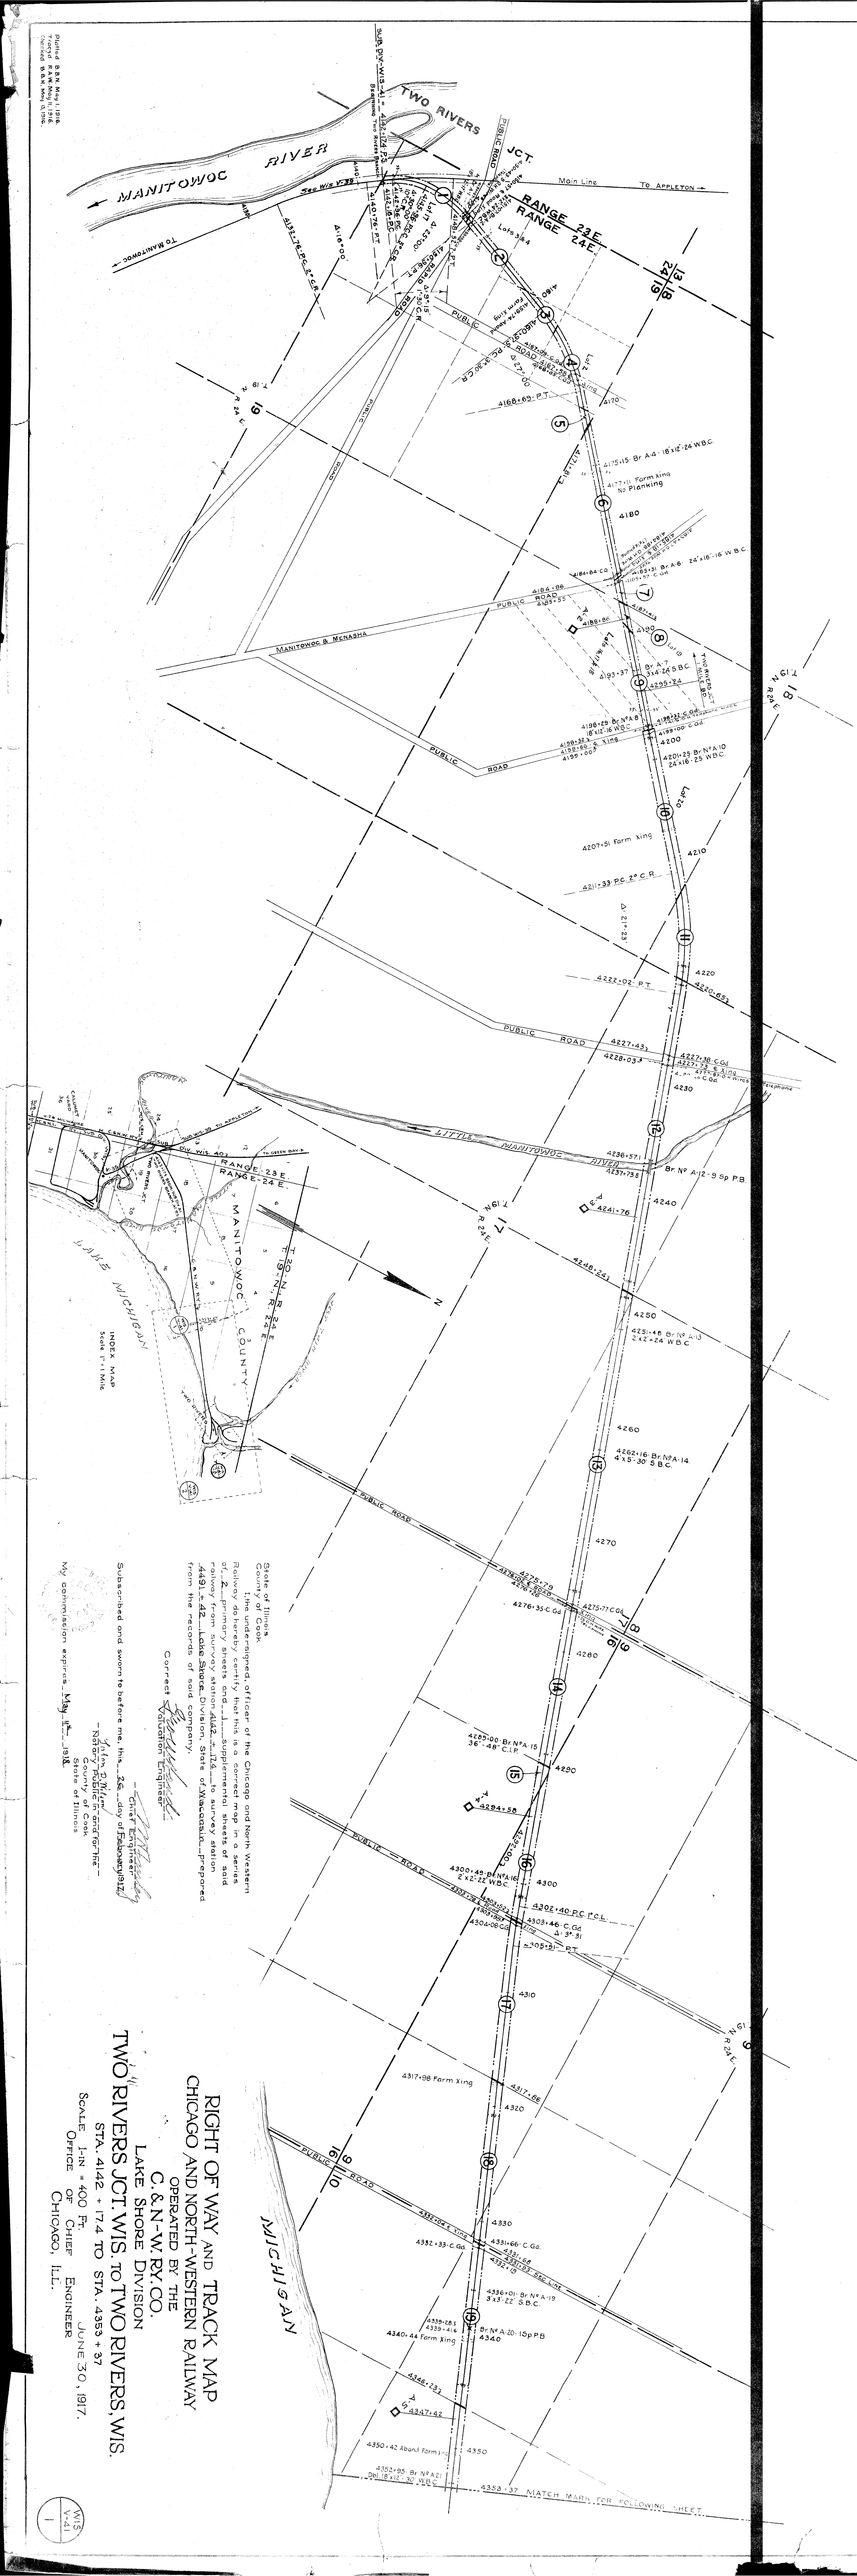

RIGHT OF WAY AND TRACK MAP
CHICAGO AND NORTH-WESTERN RAILWAY
OPERATED BY THE
C. & N.-W. RY. CO.
LAKE SHORE DIVISION
TWO RIVERS JCT. WIS. TO TWO RIVERS, WIS.
STA. 4142 + 17.4 TO STA. 4353 + 37
SCALE 1 IN = 400 FT.
OFFICE OF CHIEF ENGINEER
CHICAGO, ILL.
JUNE 30, 1917.

WIS V-41 1

State of Illinois
County of Cook

I the undersigned officer of the Chicago and North Western Railway do hereby certify that this is a correct map of the location of the railway from survey station 4142 + 17.4 to survey station 4491 + 42 Lake Shore Division, State of Wisconsin prepared from the records of said company.

Garrett [illegible]
Valuation Engineer

Subscribed and sworn to before me, this 26 day of February 1918.

[illegible]
Notary Public for the
State of Illinois.

My commission expires May 4th 1918.

Chief Engineer

Plotted B.B.N. May 1918
Traced B.A.W. May 1918
Checked B.A.W. May 1918

