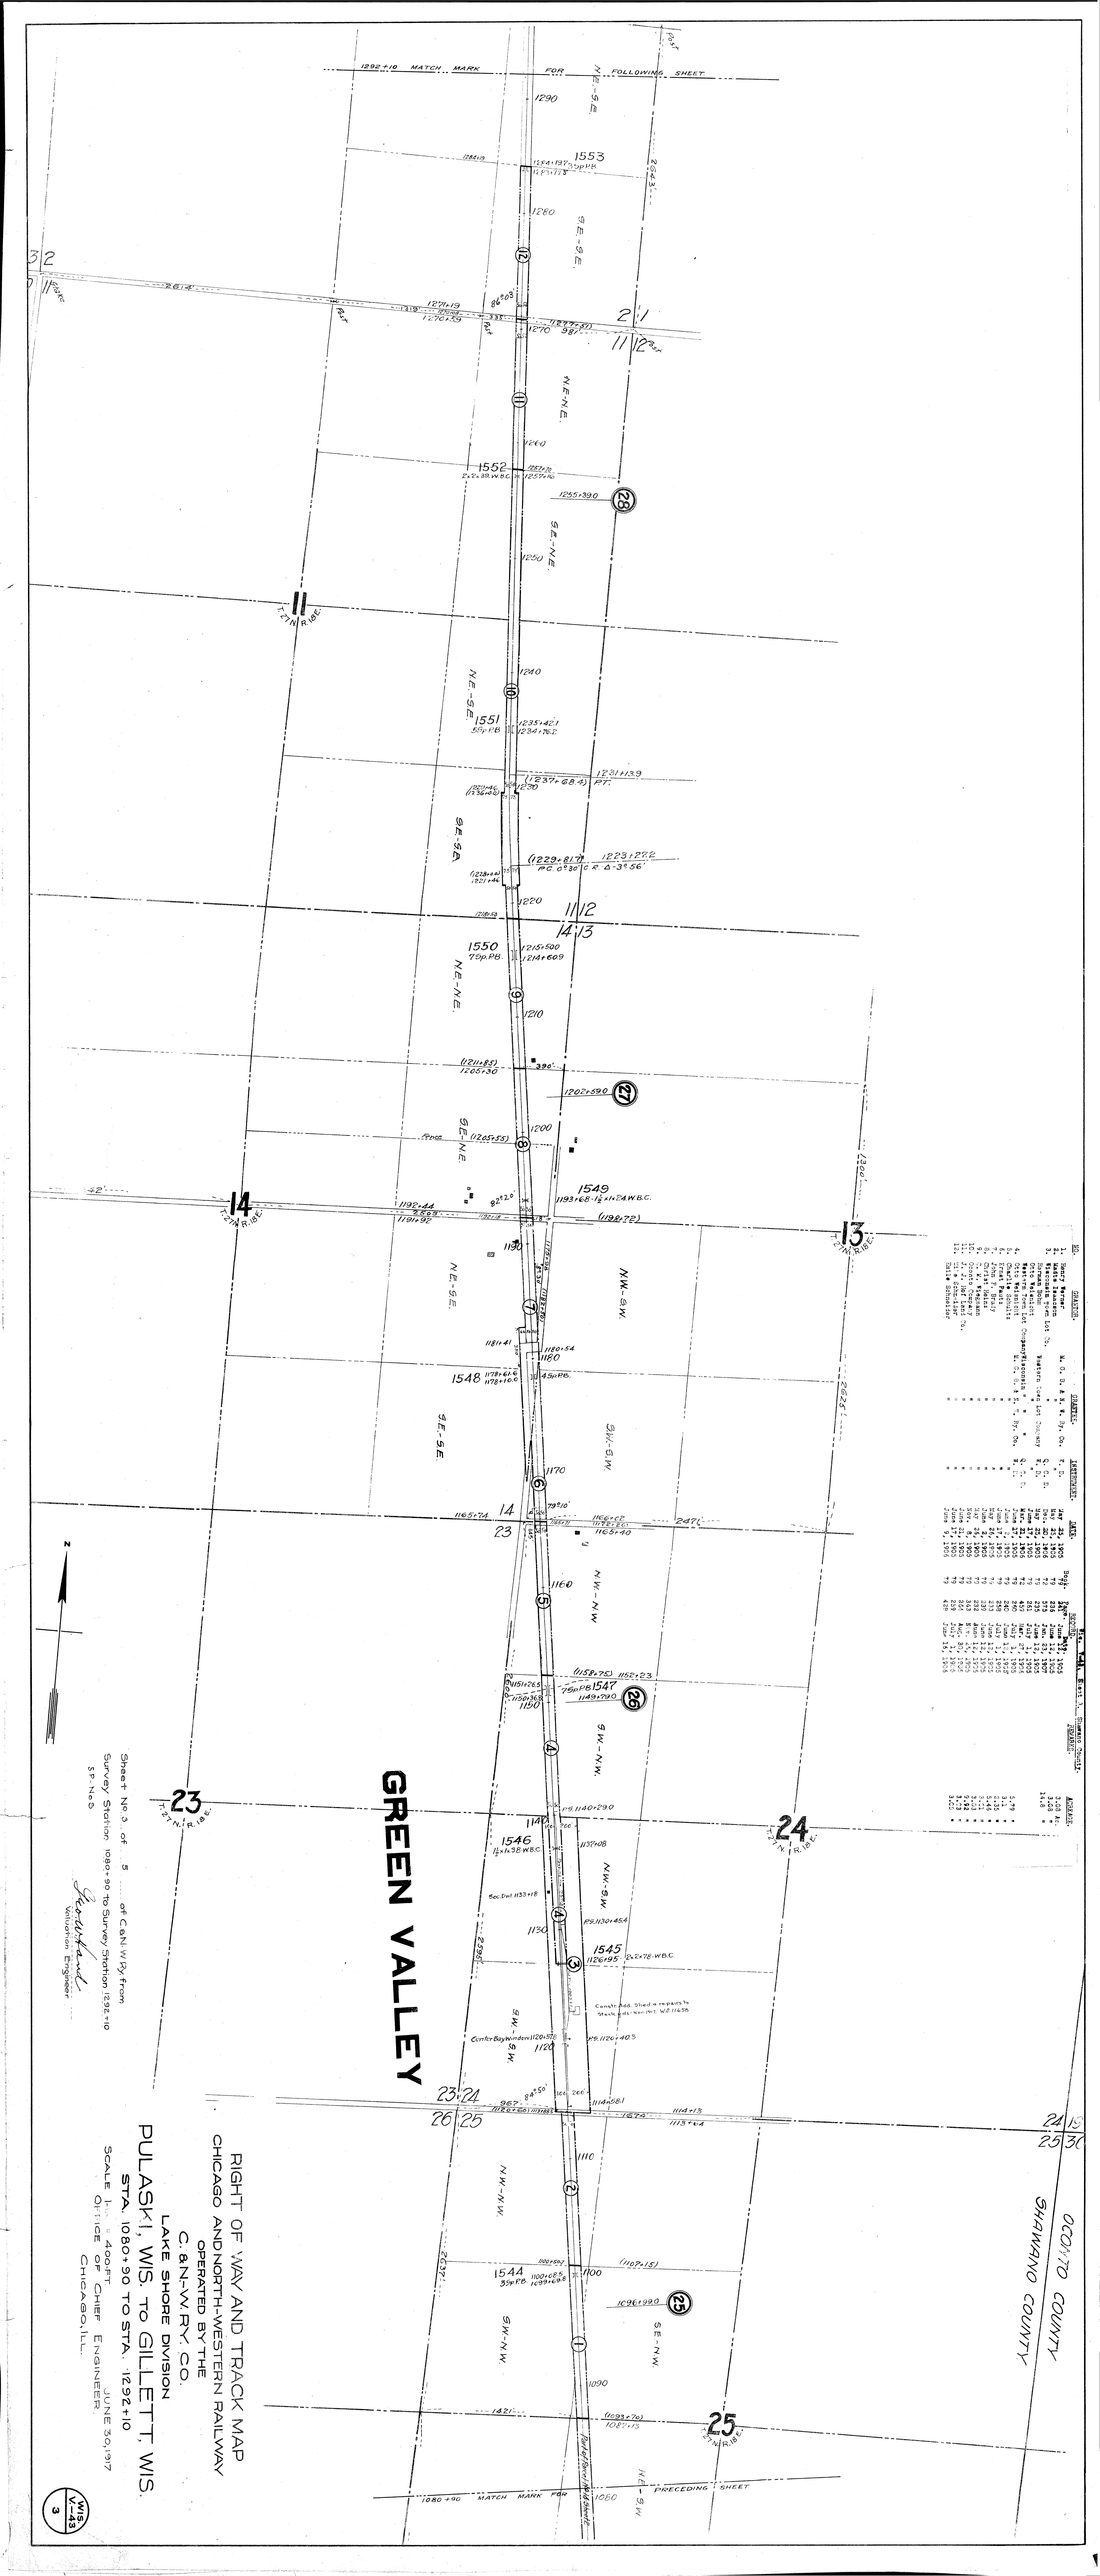
1292+10 MATCH MARK FOR FOLLOWING SHEET
1553
1552
1551
1550
1549
1548
1547
1546
1545
1544
GREEN VALLEY
SHAWANO COUNTY
OCONTO COUNTY
1080+90 MATCH MARK FOR PRECEDING SHEET
RIGHT OF WAY AND TRACK MAP
CHICAGO AND NORTH-WESTERN RAILWAY
OPERATED BY THE
C. & N.-W. RY. CO.
LAKE SHORE DIVISION
PULASKI, WIS. TO GILLETT, WIS.
STA. 1080+90 TO STA. 1292+10
SCALE 1" = 400 FT.
OFFICE OF CHIEF ENGINEER
CHICAGO, ILL.
JUNE 30, 1917
Sheet No. 3 of 5 of C&NW Ry. From
Survey Station 1080+90 To Survey Station 1292+10
SF. No. 9
Valuation Engineer
WIS 23 V 3
3