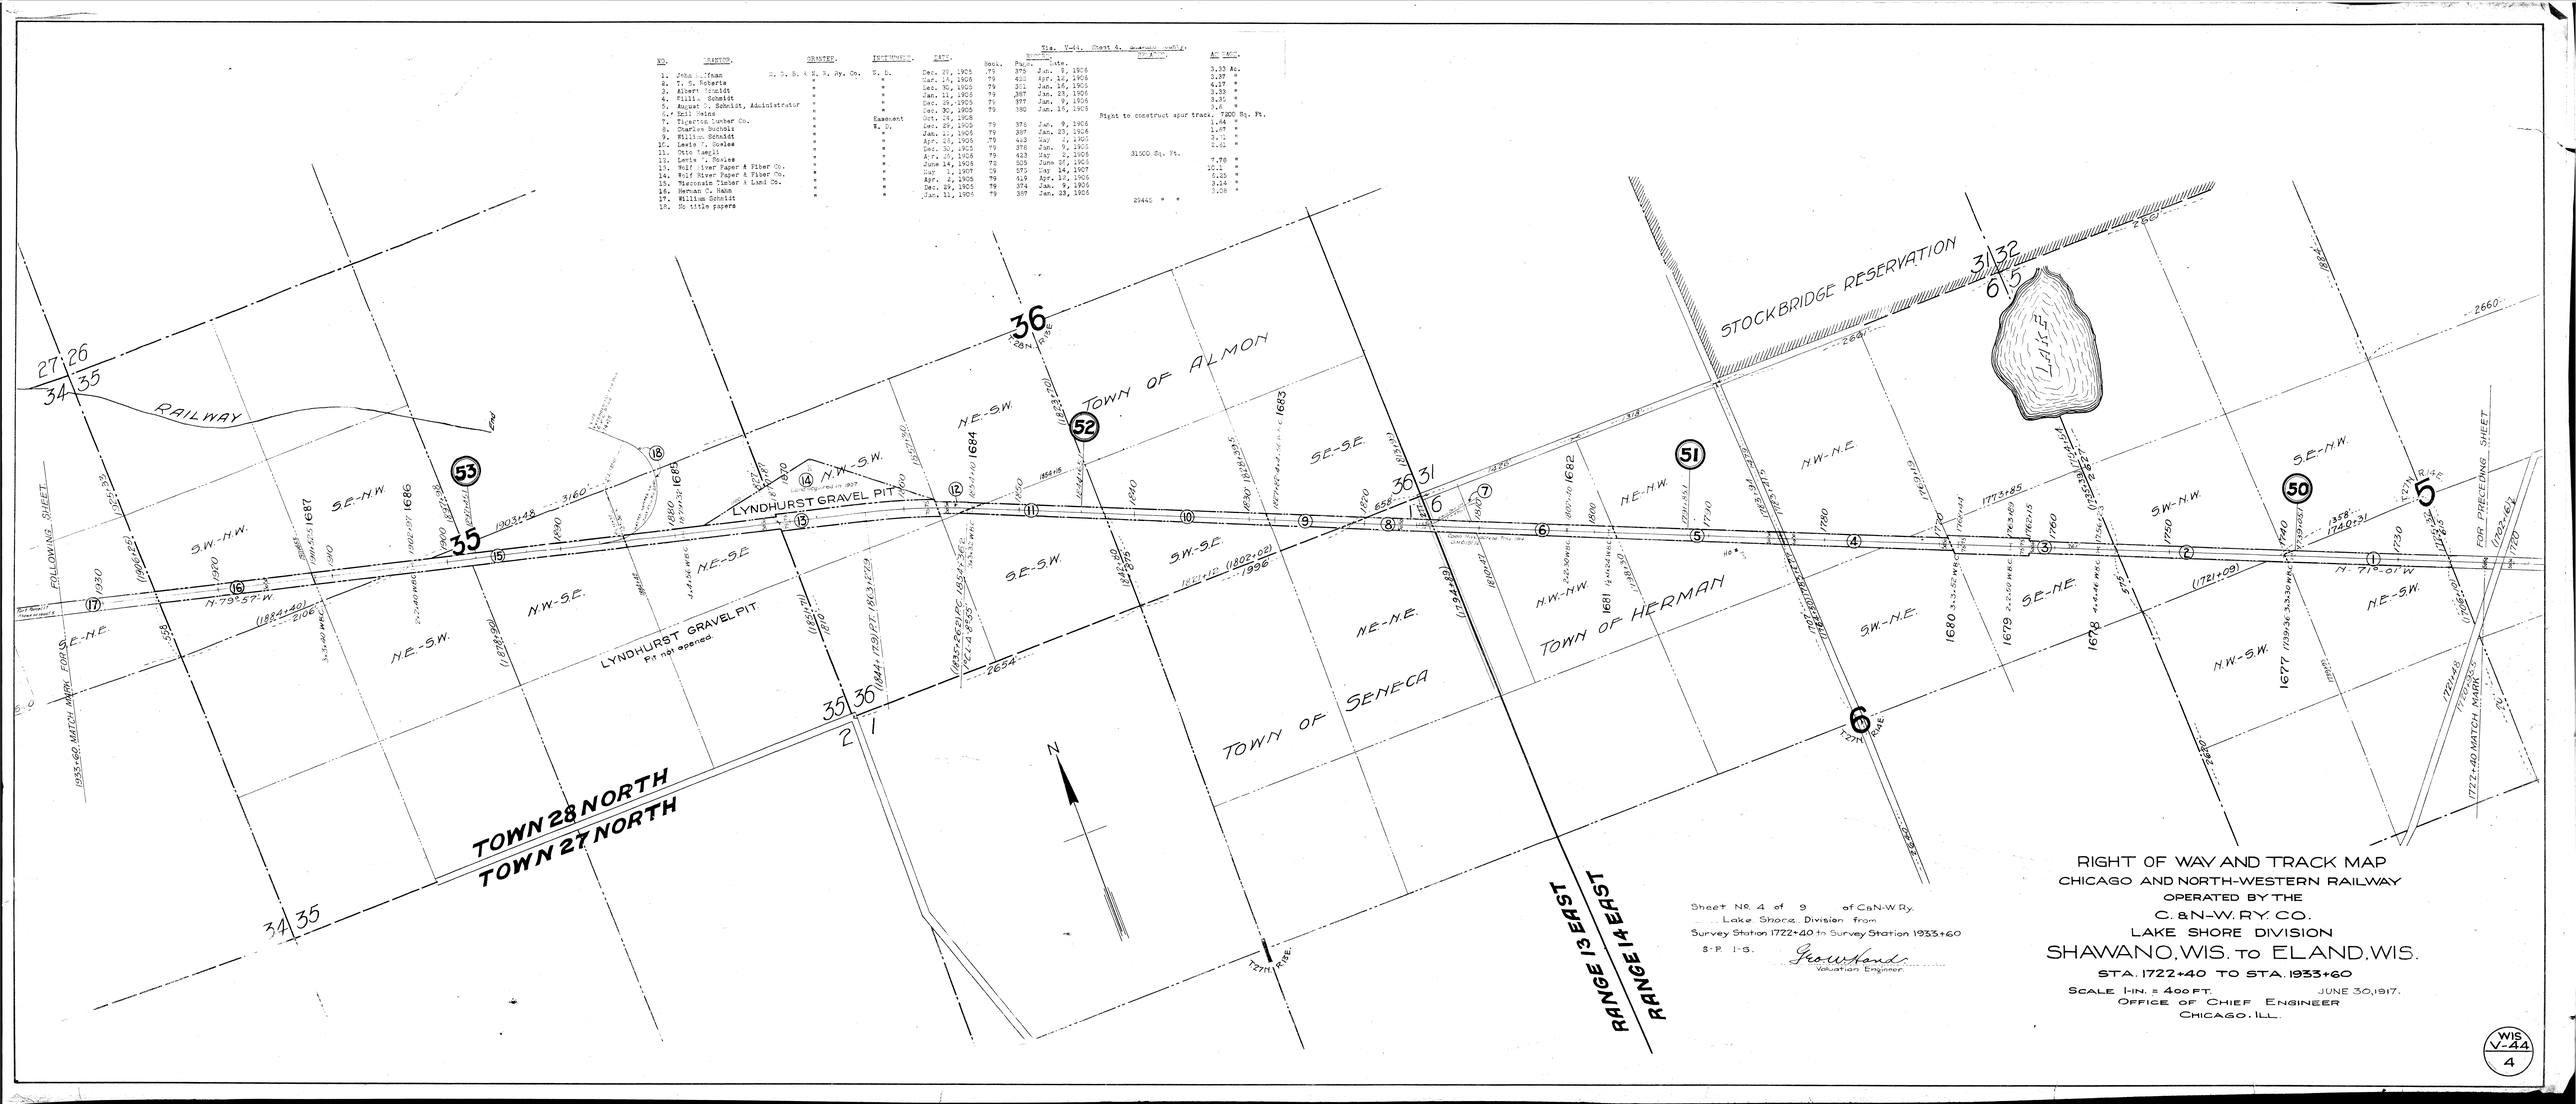
NO. GRANTOR. GRANTEE. INSTRUMENT. DATE. Book. Page. Date. No. Acres. AC. Acc.
1. John A. Dean N. S. R. & R. S. Ry. Co. W. D. Dec. 20, 1905 79 375 Jan. 9, 1906 3.33 Ac.
2. T. S. Roberts " " Mar. 14, 1906 79 411 Apr. 14, 1906 2.97 "
3. Albert Schmidt " " Dec. 30, 1905 79 351 Jan. 16, 1906 4.17 "
4. Wilh. Schmidt " " Jan. 11, 1905 79 387 Jan. 23, 1906 3.38 "
5. August C. Schmidt, Administrator " " Dec. 29, 1905 79 377 Jan. 9, 1906 3.35 "
6. Neil Heins " " Jan. 30, 1905 79 390 Jan. 16, 1906 3.6 "
Right to construct spur track. 7200 Sq. Ft.
7. Tigerton Lumber Co. " Easement Oct. 24, 1908
8. Charles Buchalz " W. D. Dec. 29, 1905 79 376 Jan. 9, 1906 1.64 "
9. Wilhelm Schmidt " " Jan. 11, 1905 79 387 Jan. 23, 1906 1.67 "
10. Lewis T. Bowles " " Apr. 10, 1905 79 403 Jan. 9, 1906 3.71 "
11. Otto Tampli " " Dec. 30, 1905 79 378 Jan. 9, 1906 2.61 "
31500 Sq. Ft.
12. Lewis T. Bowles " " Apr. 10, 1906 79 423 May 2, 1906 7.78 "
13. Wolf River Paper & Fiber Co. " " June 14, 1906 72 505 June 27, 1906 10.1 "
14. Wolf River Paper & Fiber Co. " " May 1, 1907 79 575 May 14, 1907 0.25 "
15. Wisconsin Timber & Land Co. " " Apr. 2, 1906 79 419 Apr. 17, 1906 3.14 "
16. Herman C. Hahn " " Dec. 29, 1905 79 374 Jan. 9, 1906 3.08 "
17. William Schmidt " " Jan. 11, 1906 79 389 Jan. 23, 1906
18. No title papers
29440 " "
RAILWAY
LYNDHURST GRAVEL PIT
Pit not opened
LYNDHURST GRAVEL PIT
STOCKBRIDGE RESERVATION
LAKE
TOWN OF ALMON
TOWN OF SENECA
TOWN OF HERMAN
TOWN 28 NORTH
TOWN 27 NORTH
RANGE 13 EAST
RANGE 14 EAST
FOLLOWING SHEET
FOR PRECEDING SHEET
N. 79°37' W.
N. 71°-07' W.
1935+60 MATCH MARK FOR
1722+40 MATCH MARK
Sheet No. 4 of 9 of C&N-W Ry.
Lake Shore Division from
Survey Station 1722+40 to Survey Station 1933+60
S-P. 1-5.
Valuation Engineer.
RIGHT OF WAY AND TRACK MAP
CHICAGO AND NORTH-WESTERN RAILWAY
OPERATED BY THE
C. & N-W. RY. CO.
LAKE SHORE DIVISION
SHAWANO, WIS. to ELAND, WIS.
STA. 1722+40 TO STA. 1933+60
SCALE 1-IN. = 400 FT. JUNE 30, 1917.
OFFICE OF CHIEF ENGINEER
CHICAGO, ILL.
WIS V-44 4