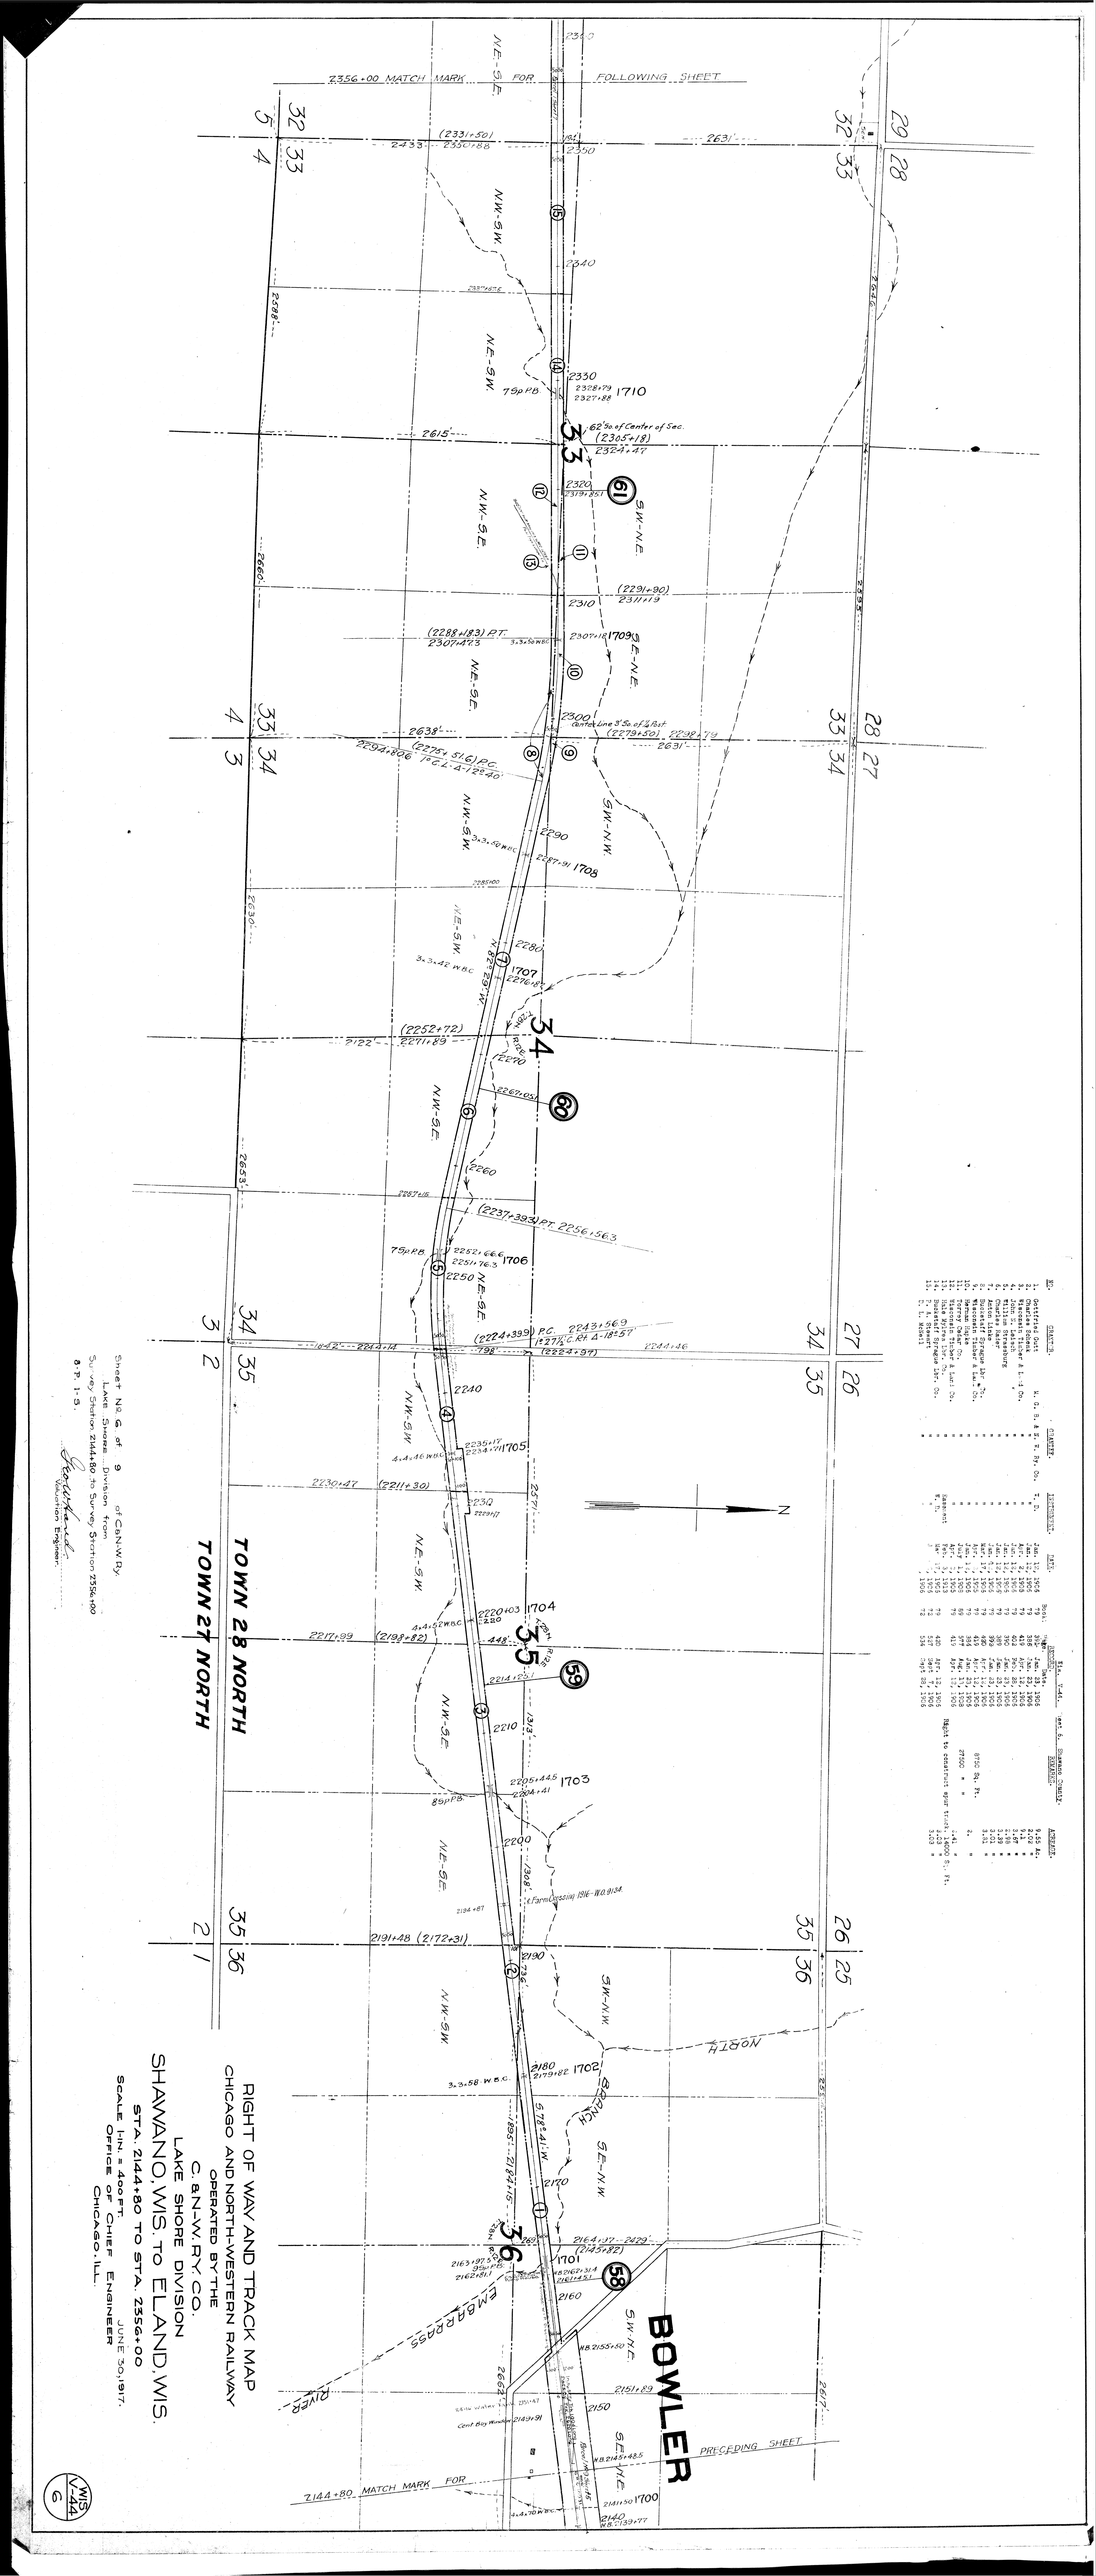
2356+00 MATCH MARK FOR FOLLOWING SHEET
RIGHT OF WAY AND TRACK MAP
CHICAGO AND NORTH-WESTERN RAILWAY
OPERATED BY THE
C. & N.-W. RY. CO.
LAKE SHORE DIVISION
SHAWANO, WIS. to ELAND, WIS.
SCALE 1 IN. = 400 FT.
JUNE 30, 1917.
OFFICE OF CHIEF ENGINEER
CHICAGO, ILL.
TOWN 28 NORTH
TOWN 27 NORTH
BOWLER
EMBARRASS RIVER
NORTH BRANCH
PRECEDING SHEET
2144+80 MATCH MARK FOR
Sheet No. 6 of 9 of C. & N.-W. Ry.
Lake Shore Division from
B.P. 1-5.
Division Engineer.
N
Right to construct spur tracks 14600 Sq. Ft.
WIS 144
6