Wis. V-45. Shawano County, Sheet 4.

NO	GRANTOR	GRANTEE	INSTRUMENT	DATE	RECORD Book	RECORD Page	RECORD Date	REMARKS	AREA Sq.Ft.	AREA Ac.
1	J. D. McGee	St. P. E. G. T. Ry.	W. D.	Sept. 1, 1884	23	316	Sept. 23, 1884	Same Deed as #17 Sheet 3.	4428	
2	Sophrona Perry	"	"	Feb. 17, 1893	38	156	June 22, 1893		2050	
3	Henry Cole	"	"	Sept. 16, 1884	23	316	Sept. 23, 1884			3.20
4	Gottfried Beyer	"	"	Oct. 20, 1884	21	389	Dec. 27, 1884			3.54
	"	"	"	Feb. 17, 1893	38	156	June 22, 1893			
5	C. Maschkovitz	"	"	Oct. 17, 1884	21	388	Dec. 27, 1884			4.05
6	Ira O. Fuller	"	"	Sept. 16, 1884	23	316	Sept. 23, 1884		5600	
7	Michael Devlin	"	"	Nov. 29, 1884	27	328	May 21, 1886			8.06
	"	"	Q. C. D.	Feb. 17, 1893	38	155	June 22, 1893			
	The Upham & Russell Co.	"	"	Feb. 17, 1893	38	155	June 22, 1893			
8	R. W. Lambert	"	W. D.	Sept. 16, 1884	23	319	Sept. 23, 1884			4.01
9	Jane Lambert	"	"	Mar. 16, 1895	46	5	Mar. 28, 1895		1595	
10	K. M. Phillips	"	"	Jan. 9, 1885	27	327	May 21, 1886		4320	
11	John H. Loan	"	"	Aug. 15, 1884	21	285	Aug. 22, 1884			4.17
12	Albert Johnson	"	"	May 15, 1886	27	337	June 9, 1886			5.62

Note- St.P.E.G.T.Ry. = St. Paul Eastern Grand Trunk Ry.

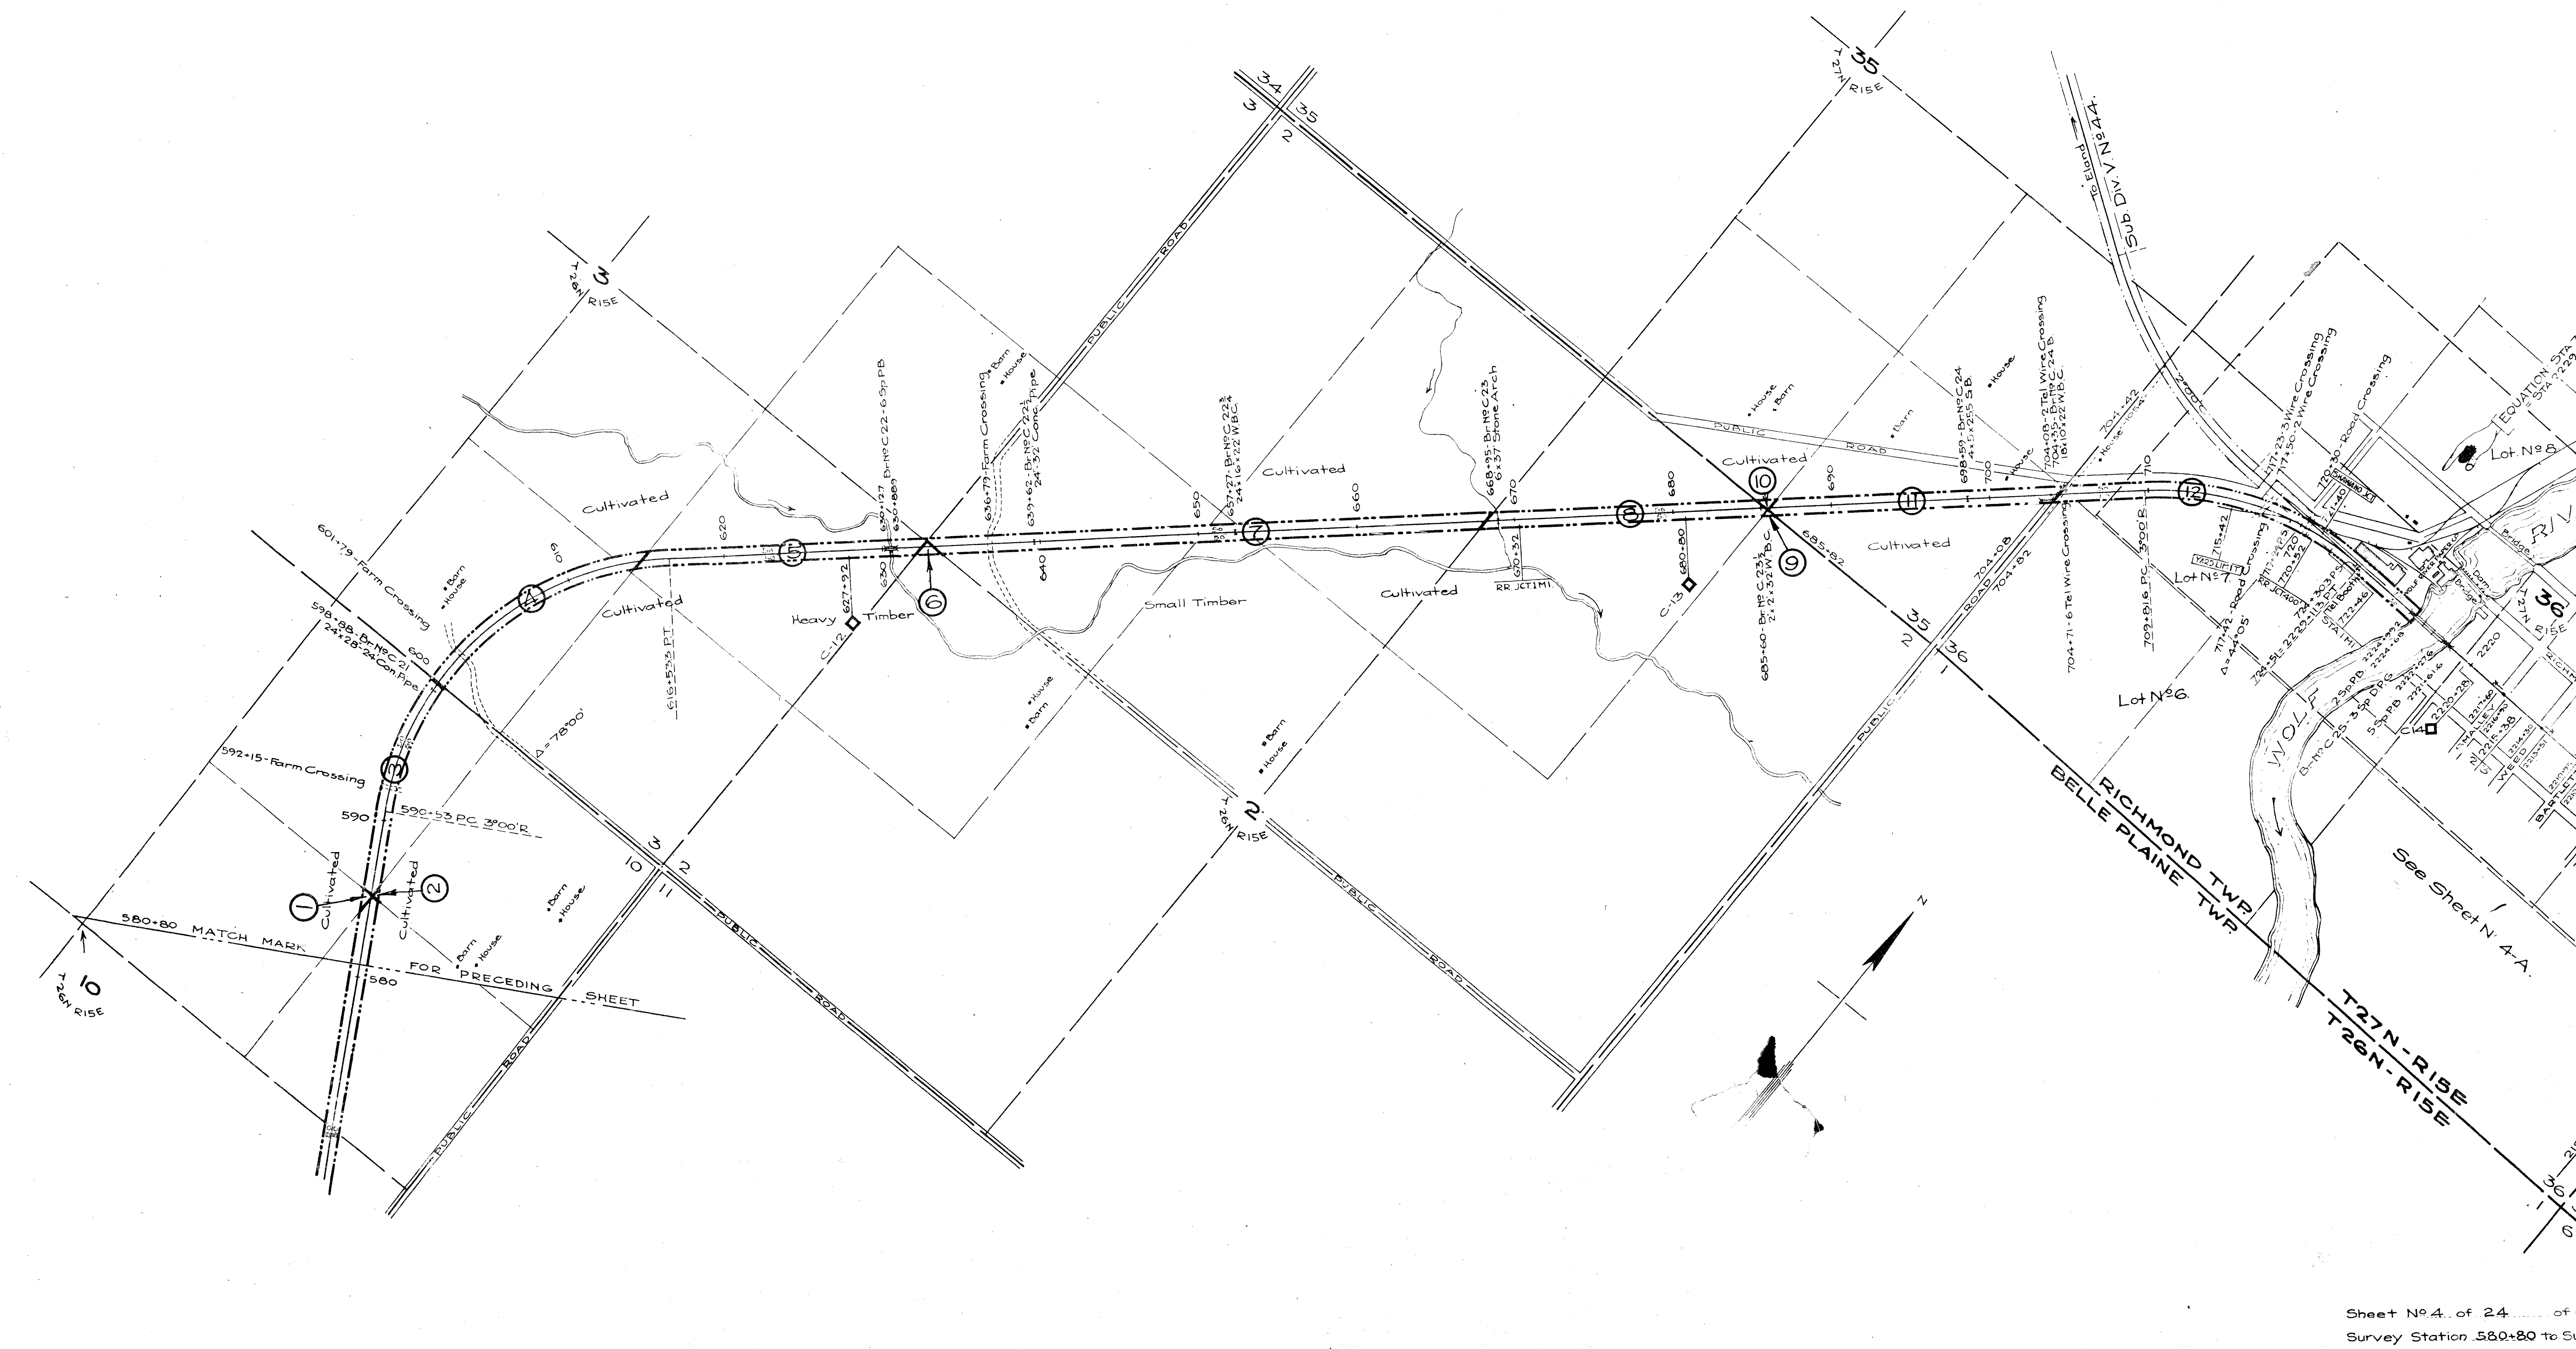

RIGHT OF WAY AND TRACK MAP
CHICAGO AND NORTH-WESTERN RAILWAY
OPERATED BY THE
C. & N-W. RY. CO.
LAKE SHORE DIVISION
CLINTONVILLE, WIS. TO OCONTO, WIS.
STA. 580+80. TO STA. 2195+00
SCALE 1-IN. = 400 FT. JUNE 30, 1917.
OFFICE OF CHIEF ENGINEER
CHICAGO, ILL.

Sheet No 4. of 24 ...... of C&N-W Ry. from
Survey Station 580+80 to Survey Station 2195+00

15-P. 9-S.

Geo. W. Hand
Valuation Engineer

PLATTED-S.K.Y.-1-28-16
TRACED-G.E.K.-2-11-16
CHECKED-S.K.Y.-2-29-16

WIS V-45 4