


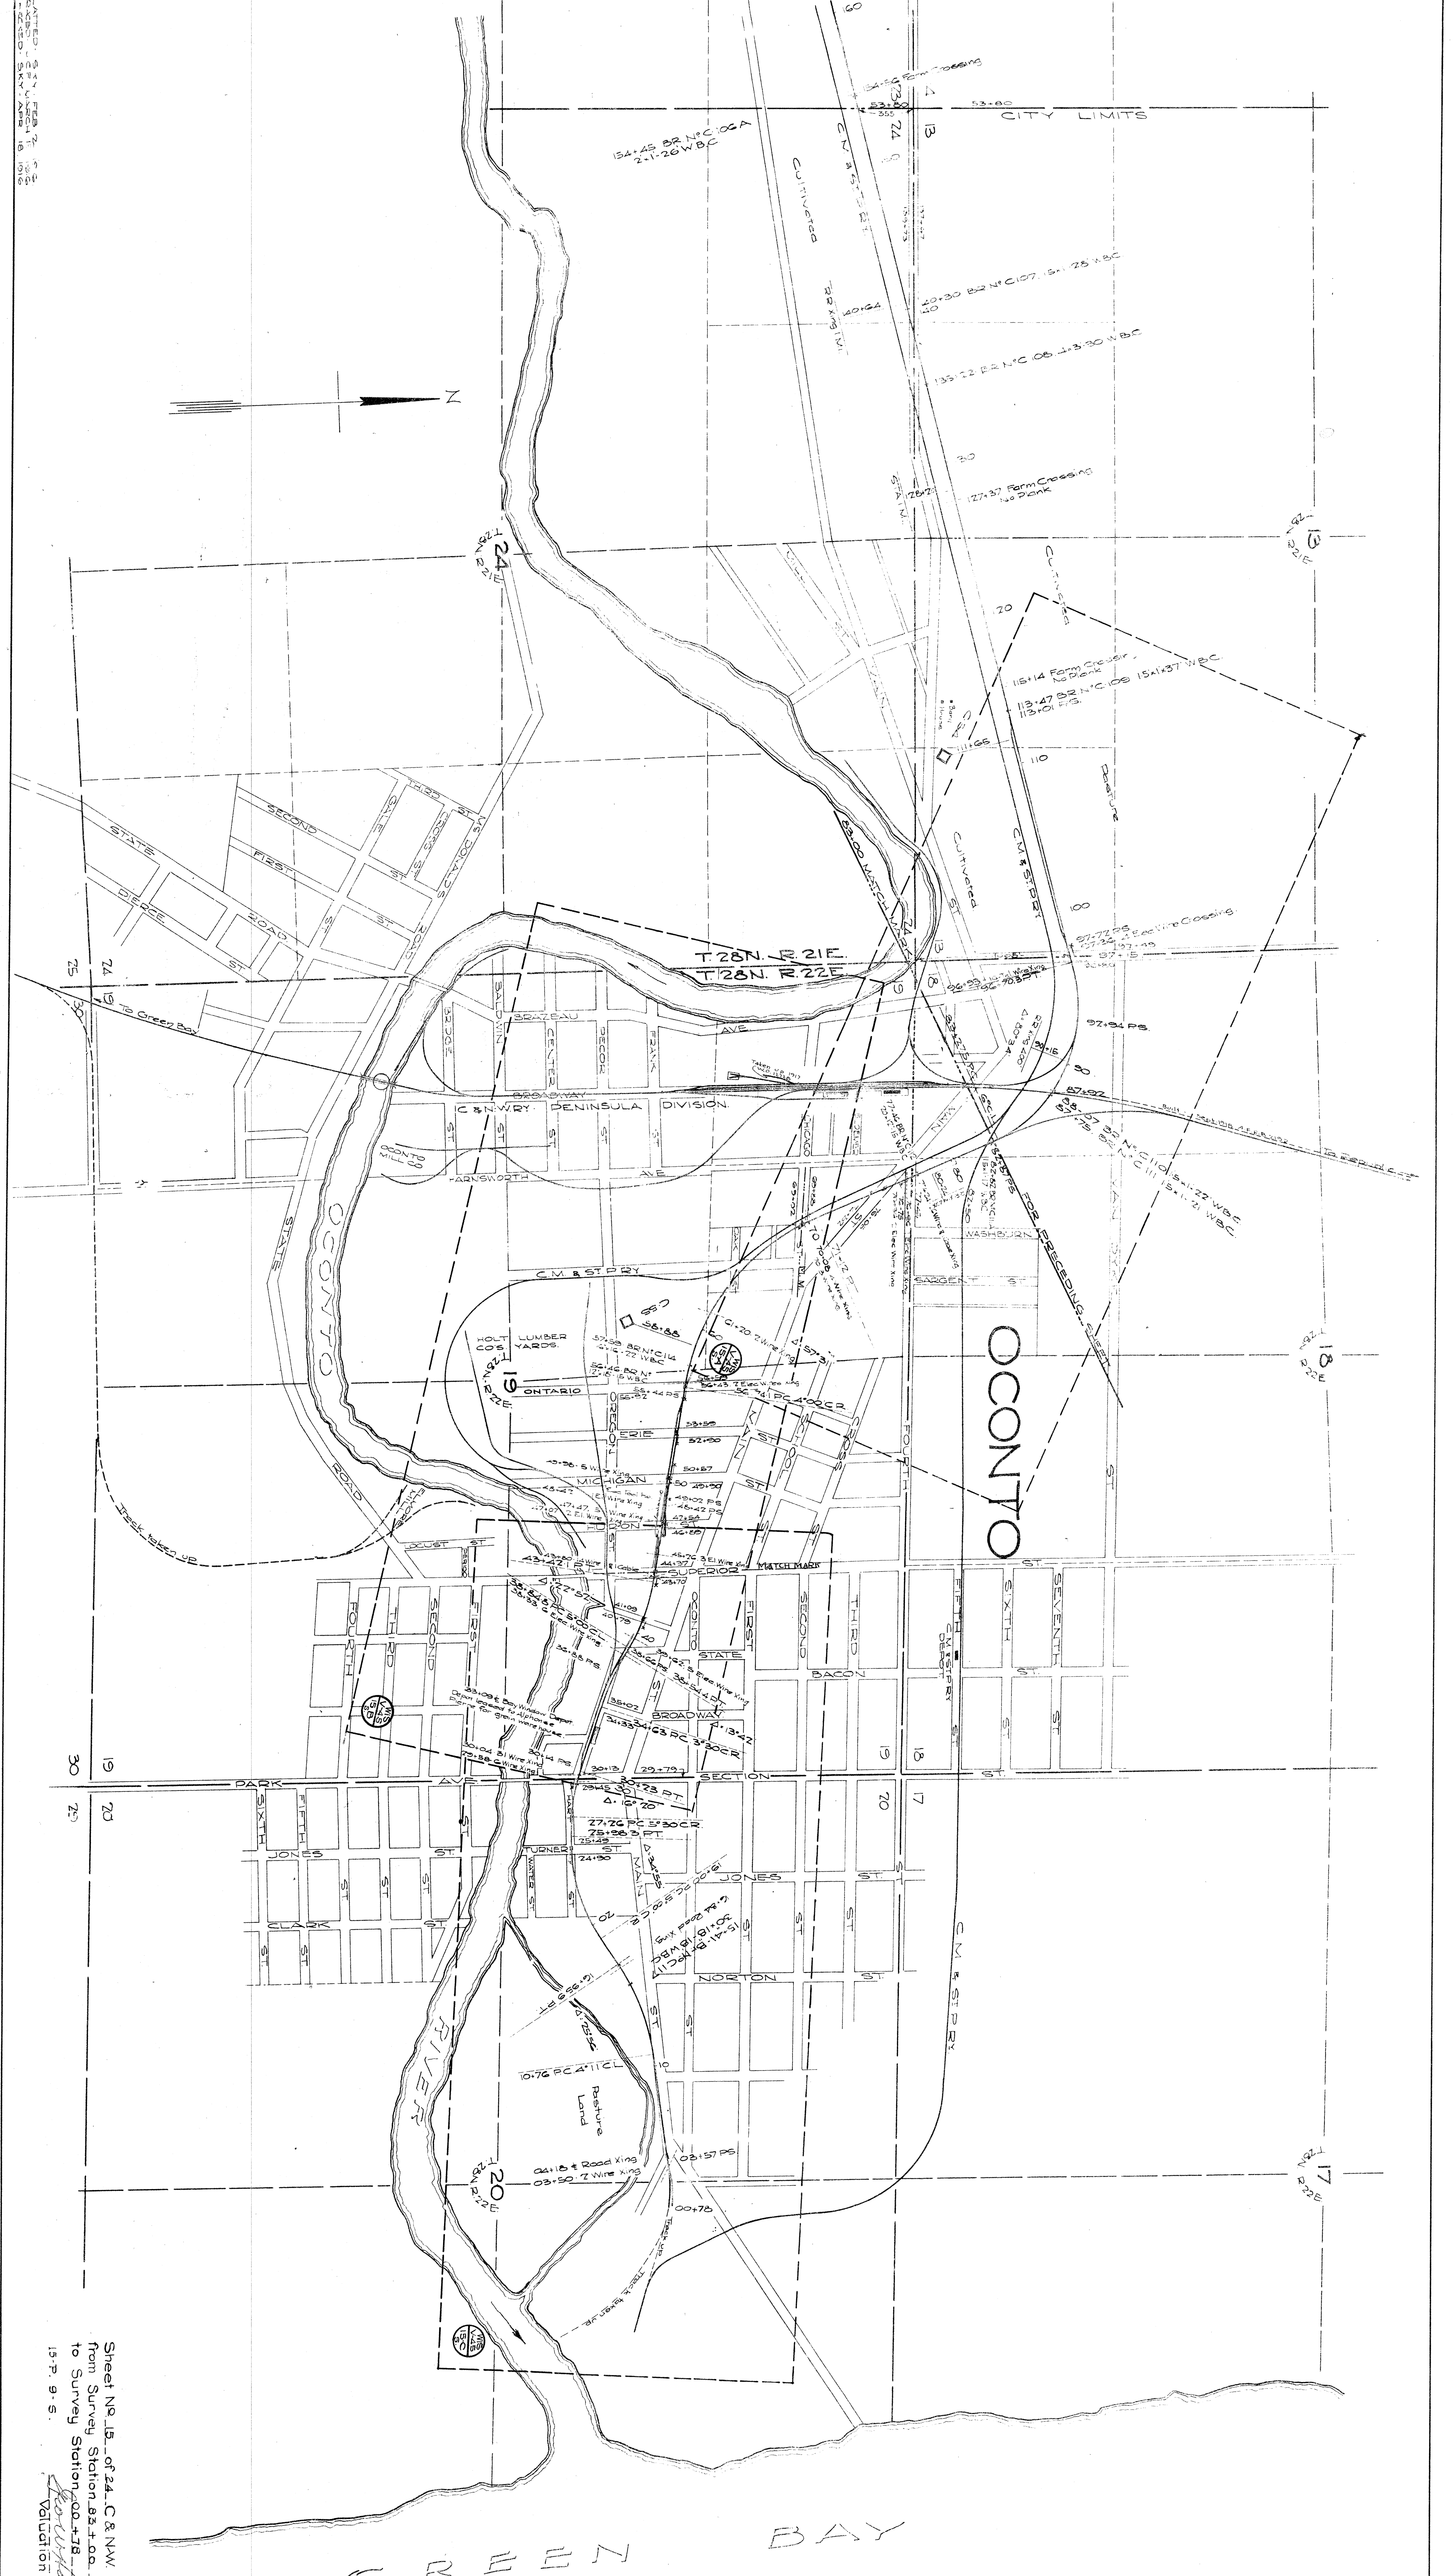

Sheet No. 15, of 24, C. & N.W. Ry
from Survey Station 83+00 to
to Survey Station 100+78
15-P. 9-5.
Valuation Engineer

RIGHT OF WAY AND TRACK MAP
CHICAGO AND NORTH-WESTERN RAILWAY
OPERATED BY THE
C. & N.-W. RY. CO.
LAKE SHORE DIVISION
CLINTONVILLE, WIS. TO OCONTO, WIS.
STA. 83 + 00 TO STA. 100 + 78
SCALE 1-IN = 400 FT.
JUNE 30 1917.
OF CHIEF ENGINEER
CHICAGO, ILL.

WIS
V-45
15