


CHICAGO
DIVISION
JUNE 7, 1916

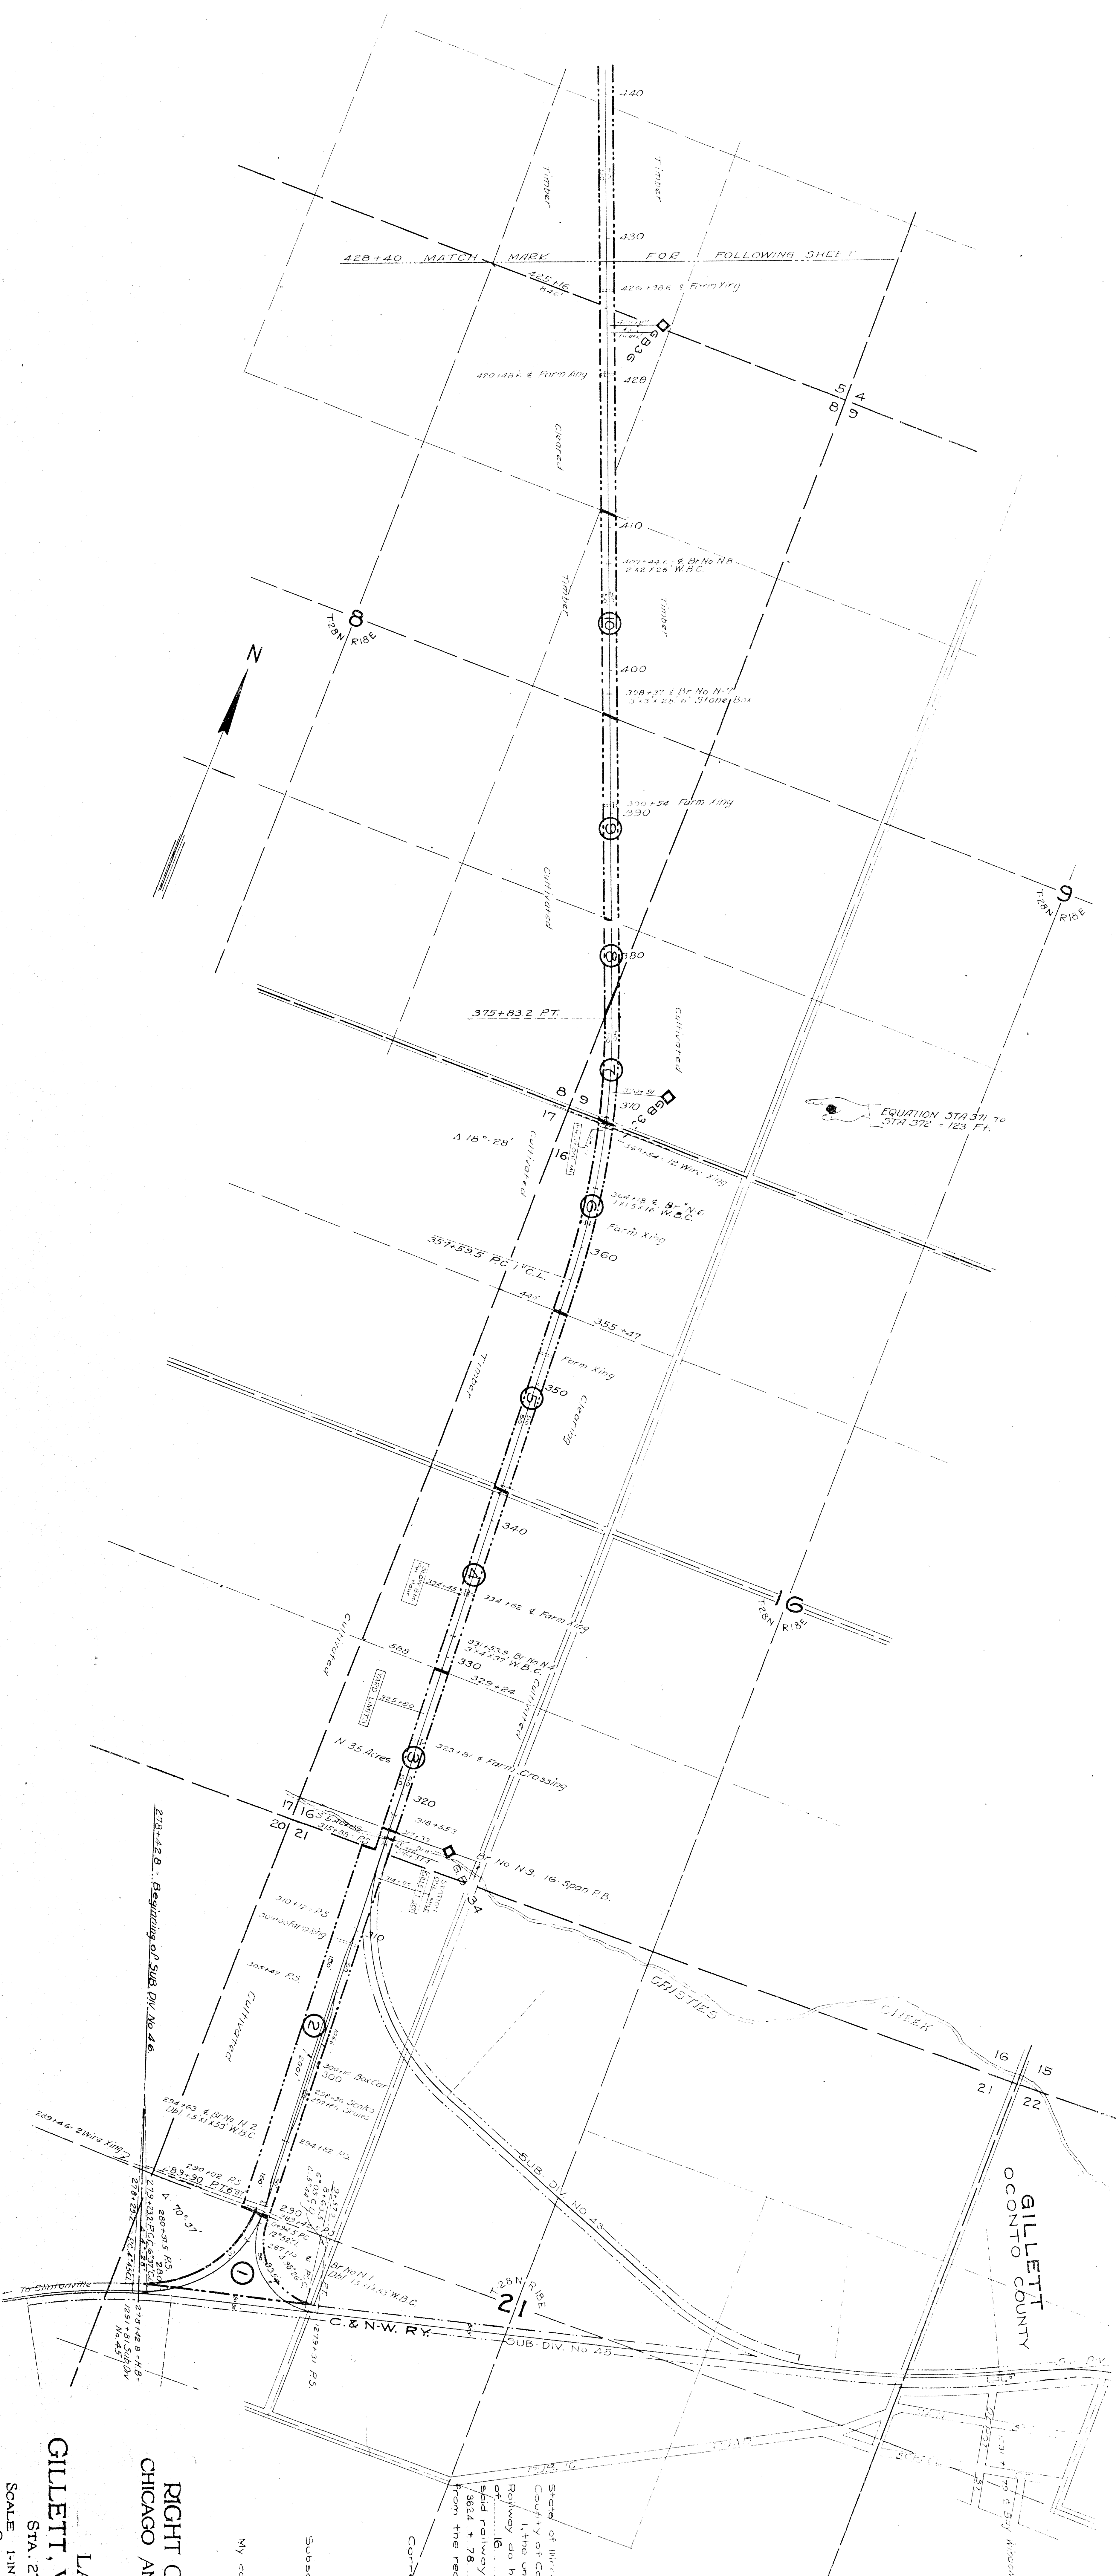

NO.	NAME	DATE	RECORD	FILE	DATE	RECORD	FILE
1	Joseph H. Hulse	Mar. 12, 1892	72	228	June 5, 1896	72	228
2	Frank Hulse	May 8, 1896	70	97	June 12, 1896	70	97
3	Frank Hulse	July 6, 1896	70	117	July 20, 1896	70	117
4	Frank Hulse	Aug. 1, 1896	70	59	June 12, 1896	70	59
5	Frank Hulse	May 9, 1896	70	59	June 12, 1896	70	59
6	Frank Hulse	June 20, 1896	70	59	June 12, 1896	70	59

RIGHT OF WAY AND TRACK MAP
CHICAGO AND NORTH-WESTERN RAILWAY
OPERATED BY THE
C. & N. W. RY. CO.
LAKE SHORE DIVISION
GILLET, WIS. TO LAONA, WIS.
STA. 278 + 428 TO STA. 428 + 40
SCALE 1-IN = 400 FT.
JUNE 30, 1917
CHICAGO, ILL.

Subscribed and sworn to before me this 6th day of Nov., 1916.
My commission expires May 11th, 1918.
Notary Public in and for the
County of Cook,
State of Illinois.

Correct: *Valuation Engineer*
Chief Engineer

Send of Illinois
County of Cook
I, the undersigned, certify that this is a correct map in a series
of 16 primary sheets and 6 supplemental sheets of
said railway from survey station 278 + 42.8 to survey station
428 + 40, Lake Shore Division, State of Wisconsin, prepared
from the records of said company.