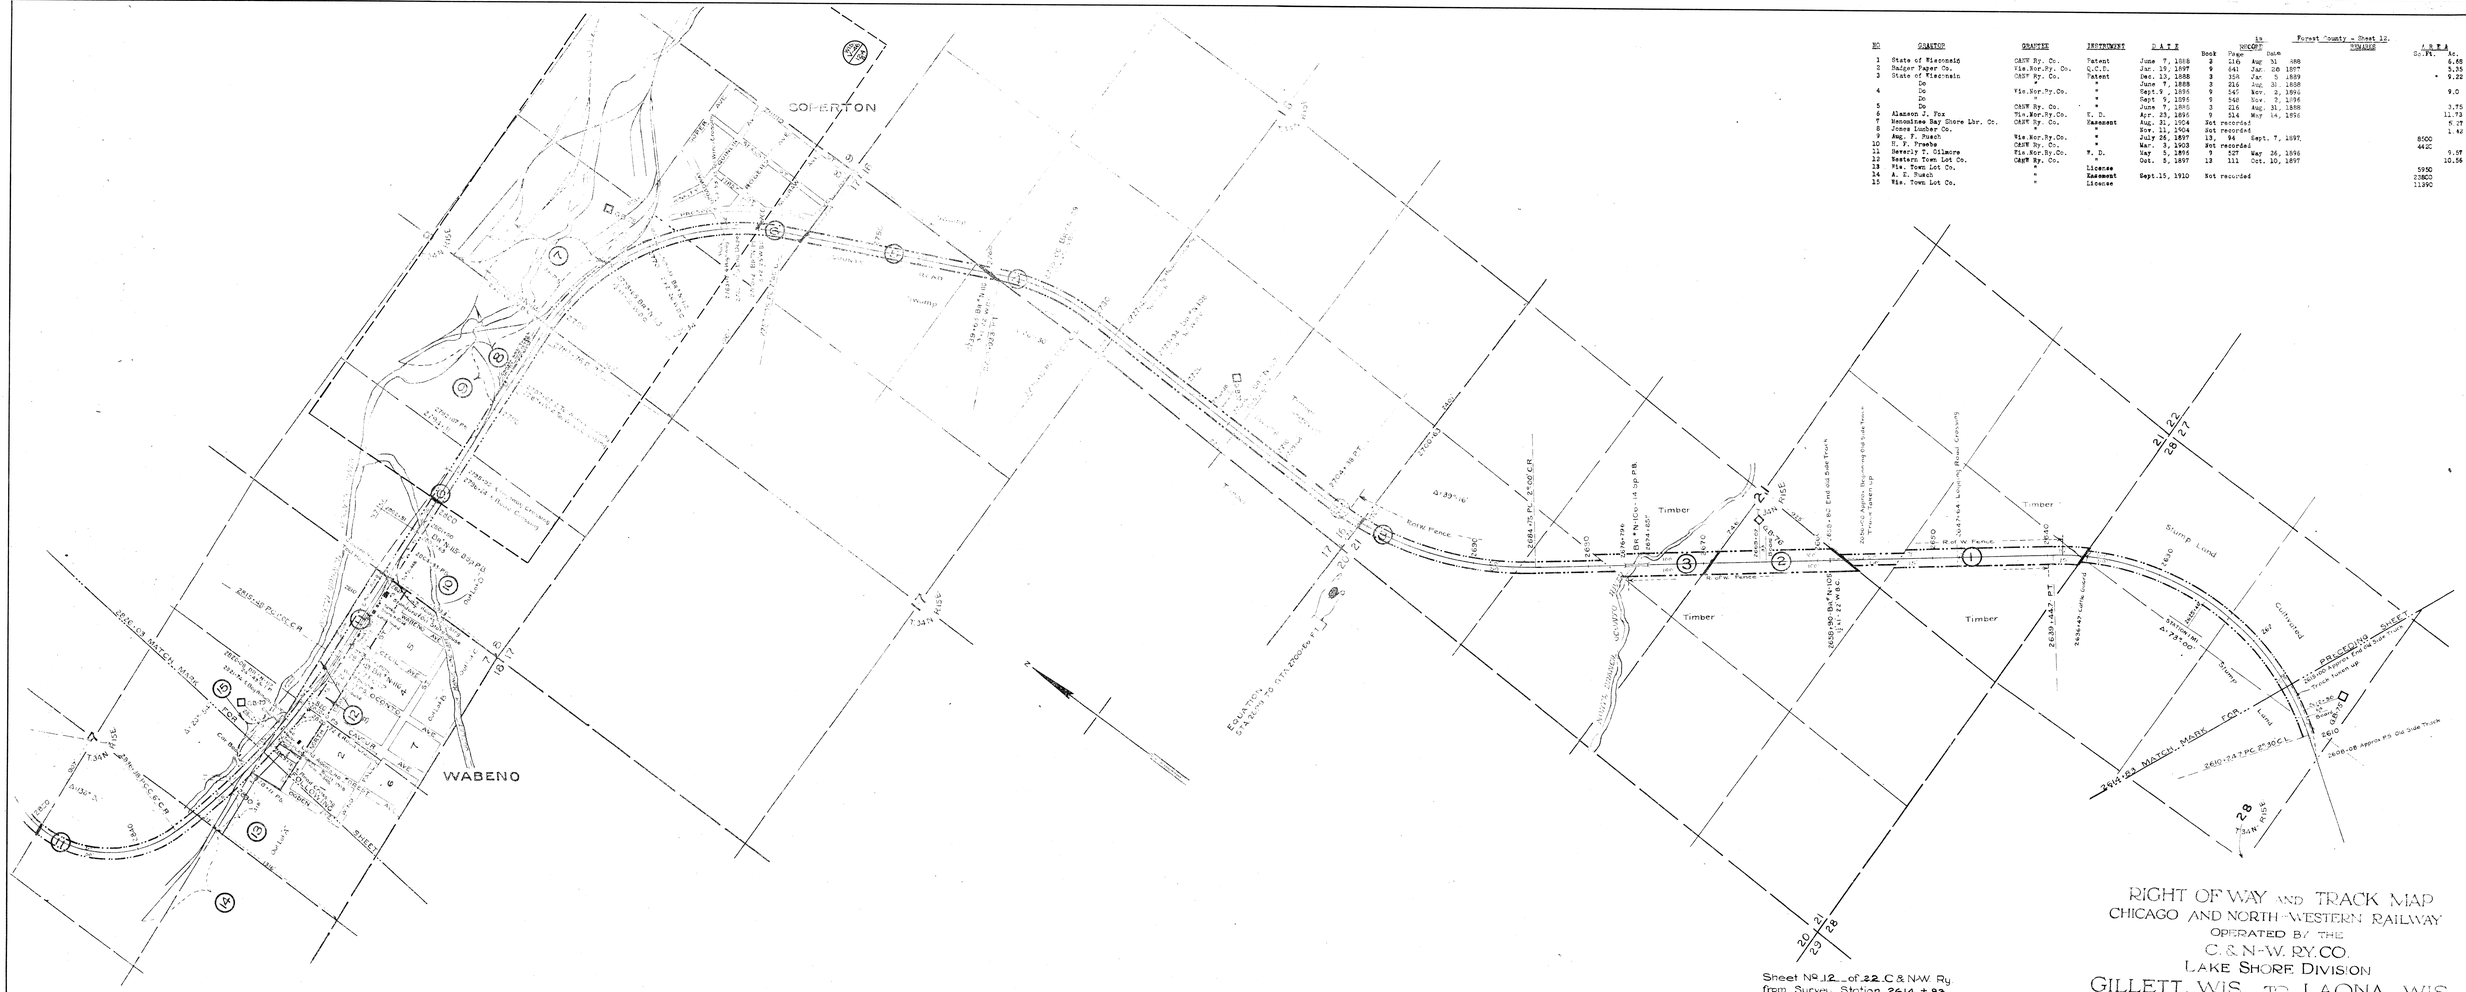
COLERTON
WABENO
Timber
Timber
Timber
Stump Land
Cultivated
Stump
Swamp
Timber
Timber
Timber