


NO.	SECTION	DATE	REMARKS	DATE	BOOK	PAGE	REMARKS	DATE	BOOK	PAGE	REMARKS

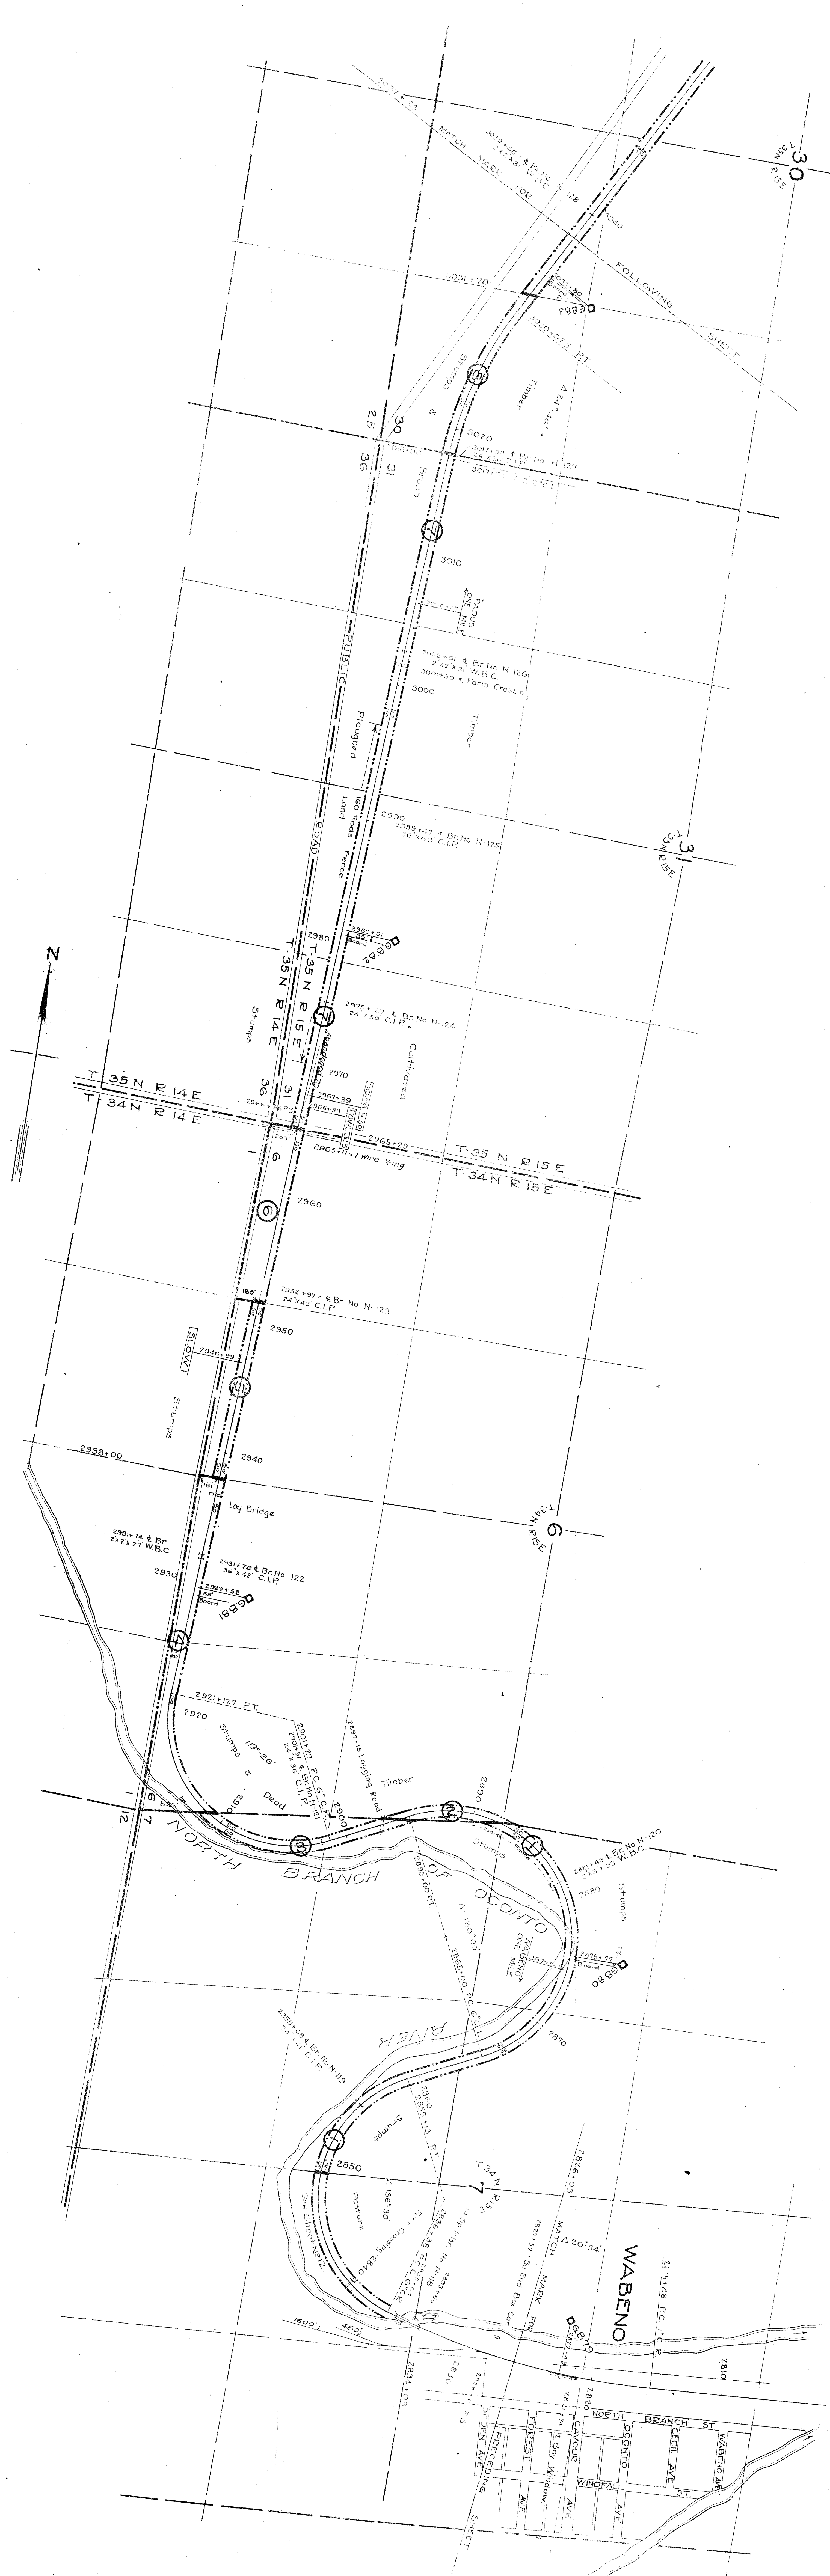

RIGHT OF WAY AND TRACK MAP
CHIC. O AND NORTH-WESTERN RAILWAY
OPERATED BY THE
C. & N.-W. RY. CO.

Sheet No. 13, of 22 C. & N.-W. Ry.
from Survey Station 2026 + 03.
to Survey Station 2032 + 23.
10-P. 6-S.
Valuation Engineer

LAKE SHORE DIVISION
GILLET, WIS. TO LAONA, WIS.
SCALE: 1 IN. = 400 FT.
OFFICE OF CHIEF ENGINEER
JUNE 30, 1917.
CHICAGO, ILL.

PLATED MAY 31, 1916
TRACED MAY 31, 1916
CHECKED MAY 31, 1916

