


NO.	DATE	REMARKS	DATE	RECORD	DATE	RECORD	DATE	RECORD

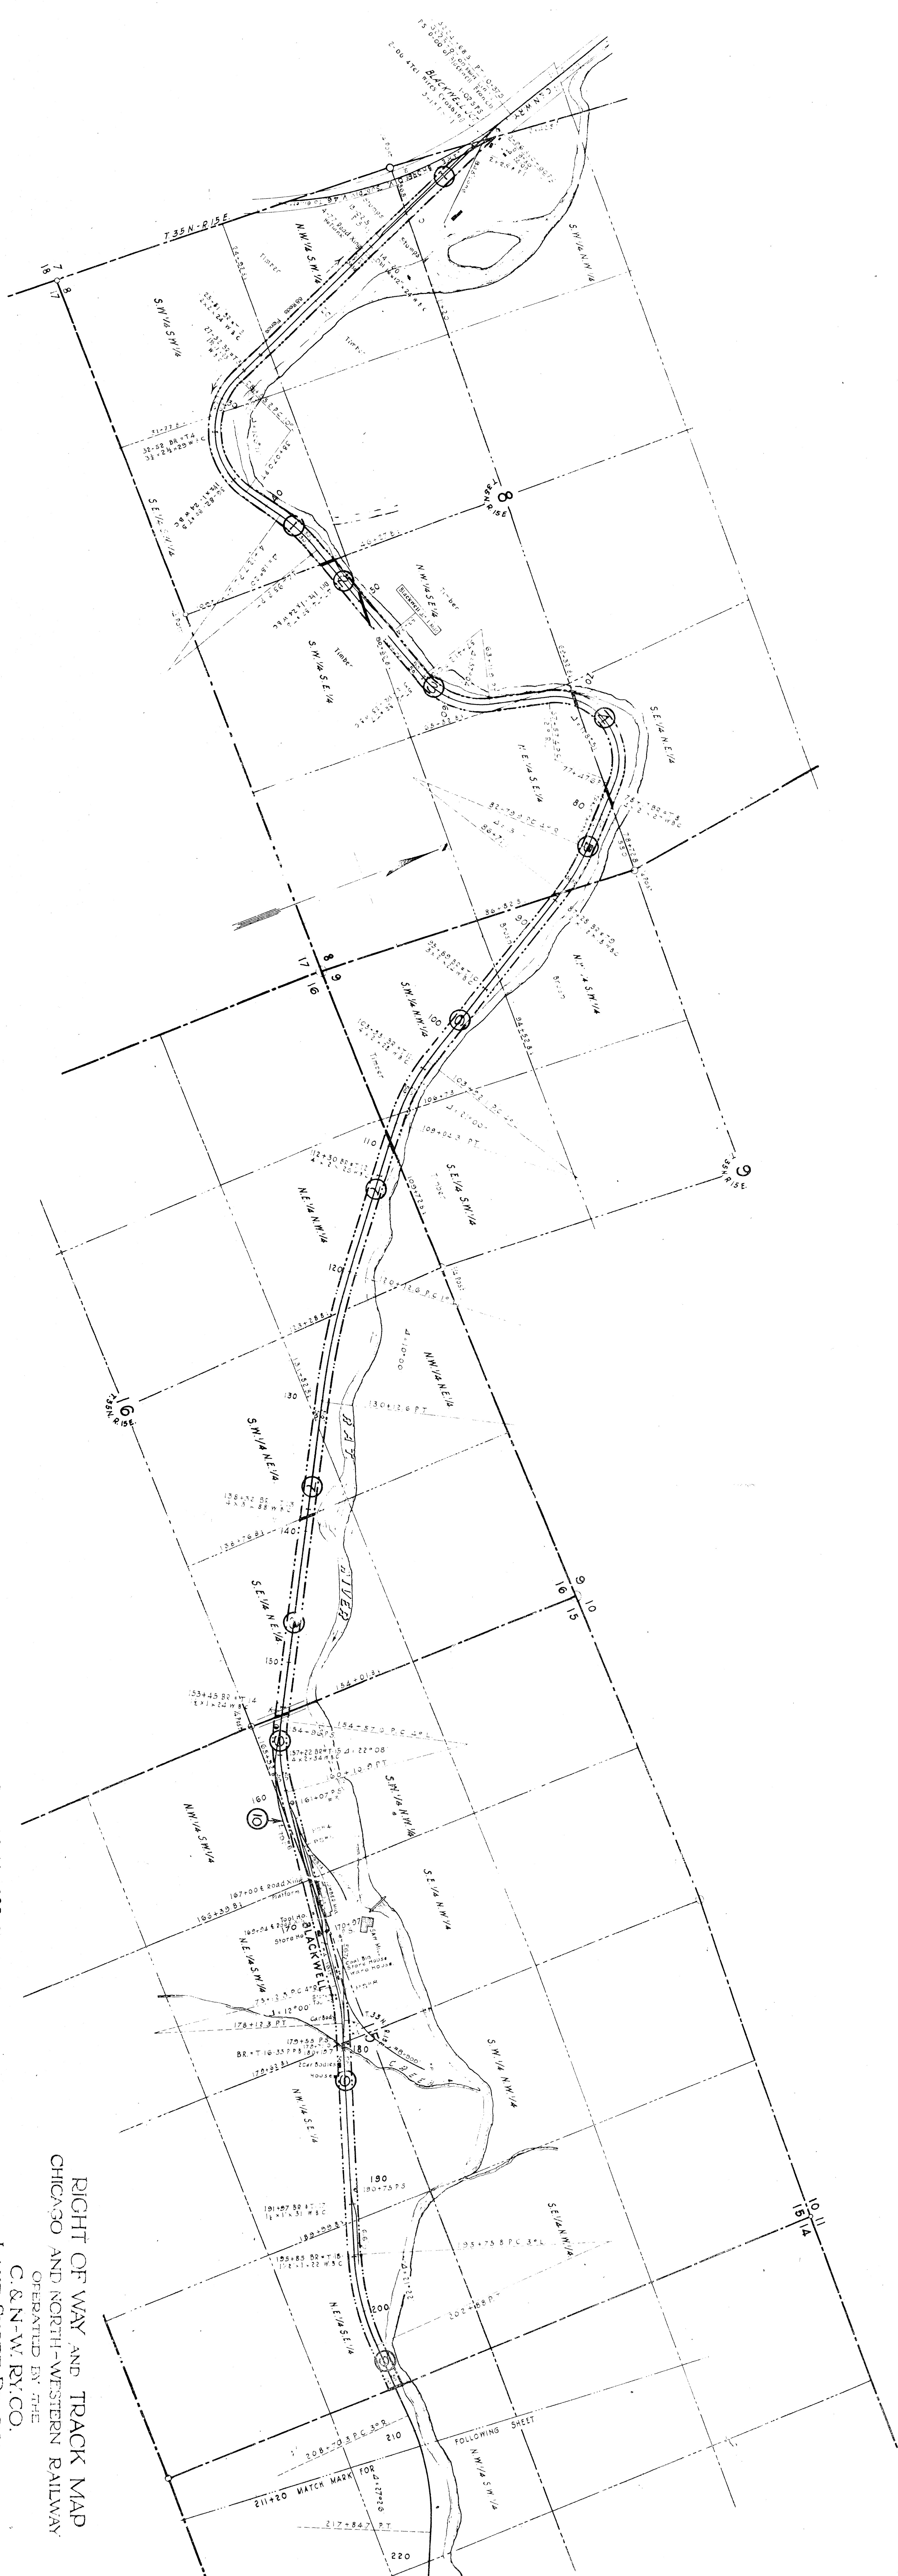

RIGHT OF WAY AND TRACK MAP
CHICAGO AND NORTH-WESTERN RAILWAY

C. & N. W. RY. CO.

LAKE SHORE DIVISION

GILLET, WIS. TO LAONA, WIS.

RAV RIVER SPUR

SCALE 1"=400 FT.

OFFICE OF CHIEF ENGINEER

CHICAGO, ILL.

WIS. V-46 14A

PLATTED BY
TRACED BY BAO
CHECKED BY