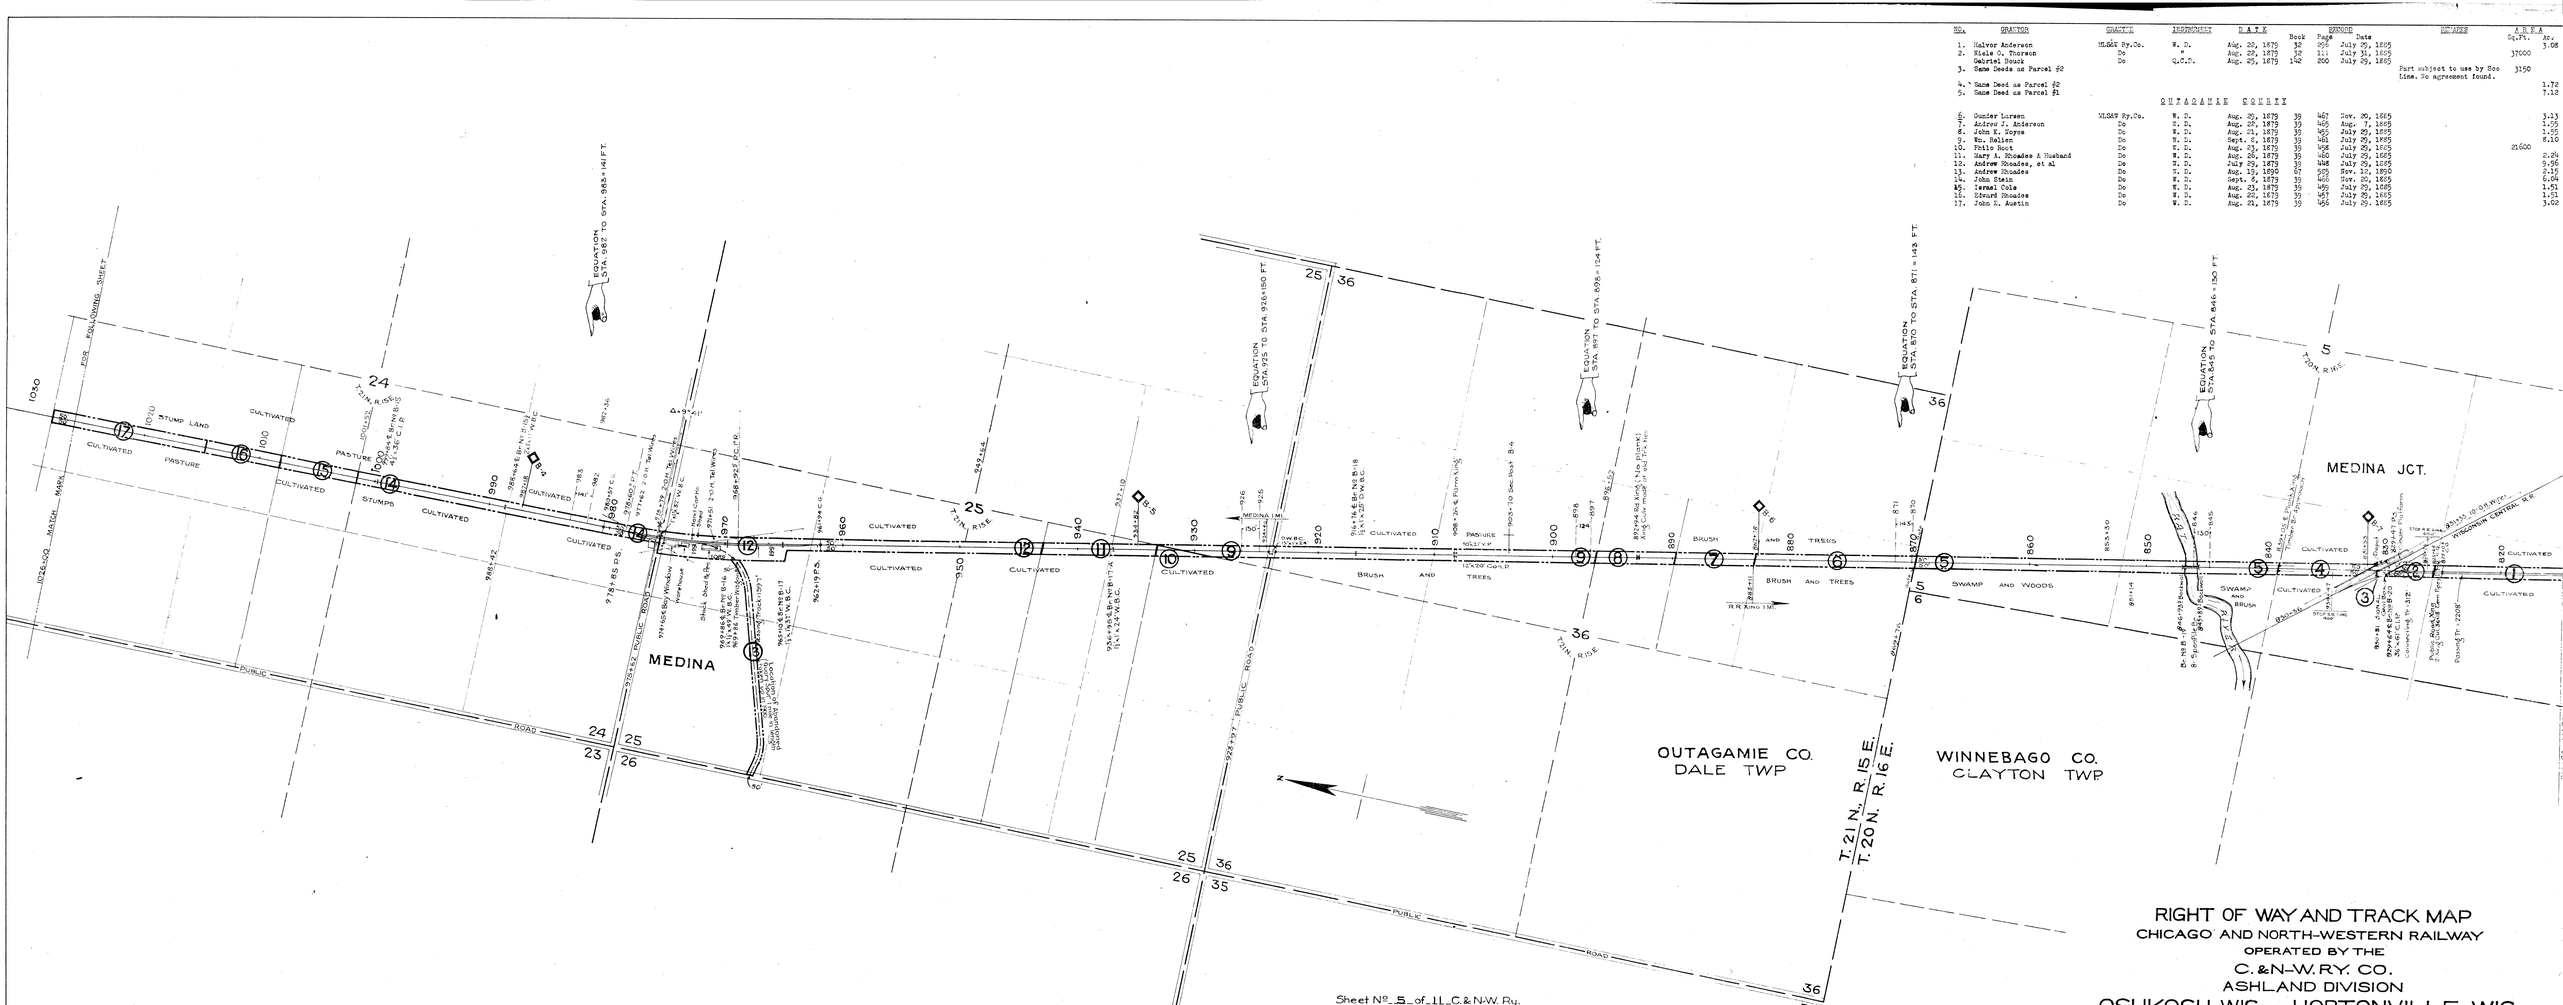


No.	GRANTOR	GRANTEE	INSTRUMENT	DATE	BOOK	RECORD PAGE	RECORD DATE	REMARKS	AREA Sq.Ft.	AREA Ac.
1.	Halvor Anderson	M.L&W. Ry.Co.	W. D.	Aug. 22, 1879	32	296	July 25, 1885			3.08
2.	Elsie O. Thoreen	Do	"	Aug. 22, 1879	32	111	July 31, 1885		37000	
	Gabriel Bouck	Do	Q.C.D.	Aug. 25, 1879	142	200	July 29, 1885			
3.	Same Deeds as Parcel #2							Part subject to use by Soo Line. No agreement found.	3150	
4.	Same Deed as Parcel #2									1.72
5.	Same Deed as Parcel #1									7.12
				OUTAGAMIE COUNTY						
6.	Gunder Larsen	M.L&W. Ry.Co.	W. D.	Aug. 20, 1879	39	467	Nov. 20, 1885			3.13
7.	Andrew J. Anderson	Do	W. D.	Aug. 22, 1879	39	465	Aug. 7, 1885			1.75
8.	John K. Noyes	Do	W. D.	Aug. 21, 1879	39	455	July 29, 1885			1.55
9.	Wm. Ballen	Do	W. D.	Sept. 2, 1879	39	461	July 29, 1885			8.16
10.	Pablo Bouck	Do	W. D.	Aug. 23, 1879	39	458	July 29, 1885		21600	
11.	Mary A. Rhoades & Husband	Do	W. D.	Aug. 26, 1879	39	460	July 29, 1885			2.84
12.	Andrew Rhoades, et al	Do	W. D.	July 29, 1879	39	448	July 29, 1885			9.36
13.	Andrew Rhoades	Do	W. D.	Aug. 19, 1890	67	505	Nov. 12, 1890			2.15
14.	John Stein	Do	W. D.	Sept. 6, 1879	39	468	Nov. 20, 1885			6.04
15.	Israel Cole	Do	W. D.	Aug. 23, 1879	39	459	July 29, 1885			1.51
16.	Edward Rhoades	Do	W. D.	Aug. 22, 1879	39	457	July 29, 1885			1.51
17.	John L. Austin	Do	W. D.	Aug. 21, 1879	39	456	July 29, 1885			3.02

PLATTED - R.G.C. - JULY 26, 1916.
TRACED - V.W.C. - AUG. 14, 1916.
CHECKED - R.G.C. - AUG. 16, 1916.

Sheet No. 5 of 11 C.& N.W. Ry.
from Survey Station 814+80
to Survey Station 1026+00
C.P. 5-5.
Valuation Engineer

RIGHT OF WAY AND TRACK MAP
CHICAGO AND NORTH-WESTERN RAILWAY
OPERATED BY THE
C. & N.-W. RY. CO.
ASHLAND DIVISION
OSHKOSH, WIS. TO HORTONVILLE, WIS.
STA. 814+80 TO STA. 1026+00
SCALE 1 IN. = 400 FT. JUNE 30, 1917.
OFFICE OF CHIEF ENGINEER
CHICAGO, ILL.

WIS V-49 5