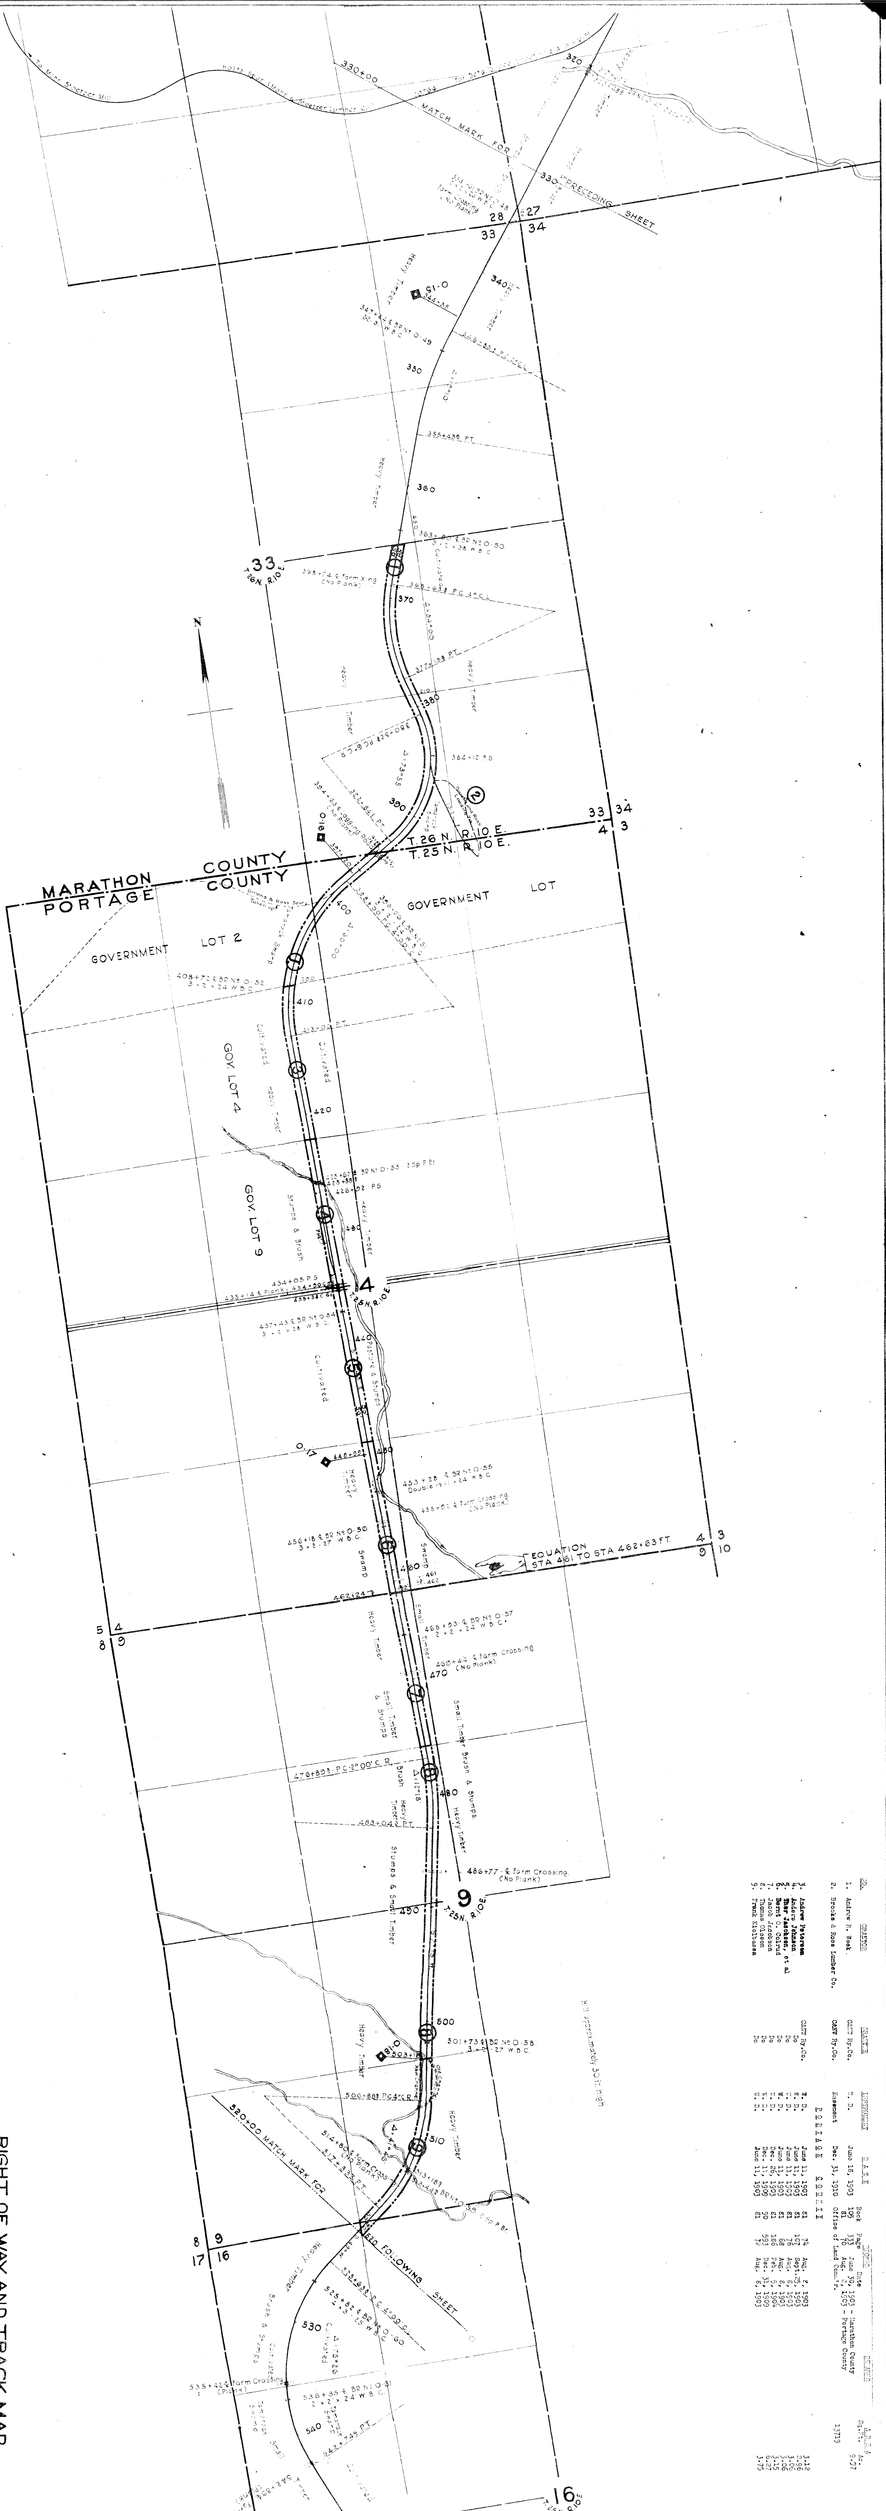

RIGHT OF WAY AND TRACK MAP
CHICAGO AND NORTH-WESTERN RAILWAY
OPERATED BY THE
C. & N-W. RY. CO.
ASHLAND DIVISION
ELAND, WIS. TO ROSHOLT, WIS.
STA. 330+00 TO STA. 520+00
SCALE ONE INCH = 400 FEET
JUNE 30, 1917.
CHIEF ENGINEER
CHICAGO, ILL.

5