


Platted - S.K.Y. Aug. 28 1916
Traced - C.M.C. Sept 23 1916
Checked - S.K.Y. Nov. 3, 1916

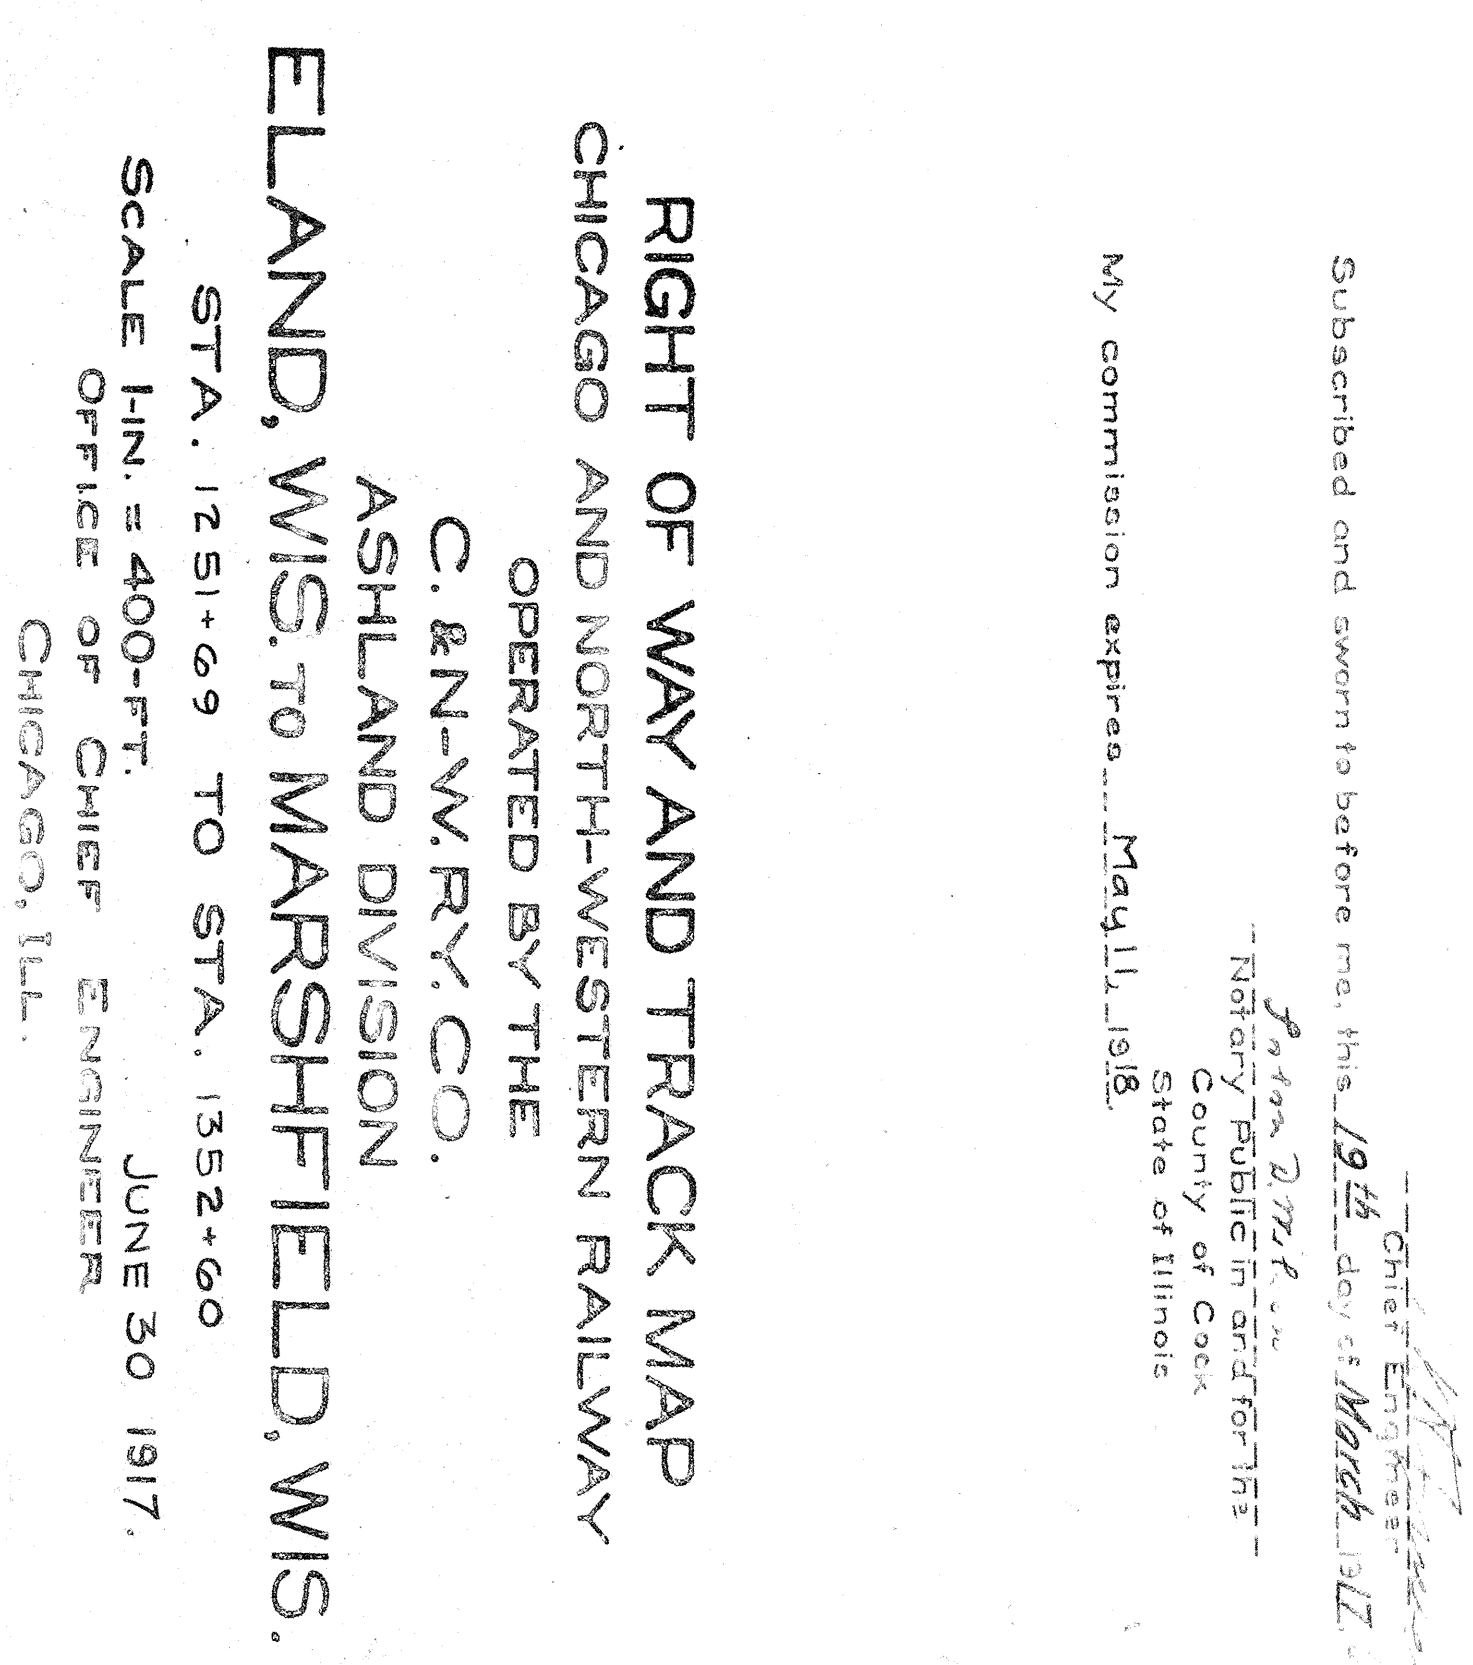

RIGHT OF WAY AND TRACK MAP
CHICAGO AND NORTH-WESTERN RAILWAY
OPERATED BY THE
C. & N.W. RY. CO.
ASHLAND DIVISION
ELAND, WIS. TO MARSHFIELD, WIS.
STA. 1251+69 TO STA. 1352+60
SCALE 1 in. = 400-FT.
OFFICE OF CHIEF ENGINEER
CHICAGO, ILL.
JUNE 30 1917.

155