


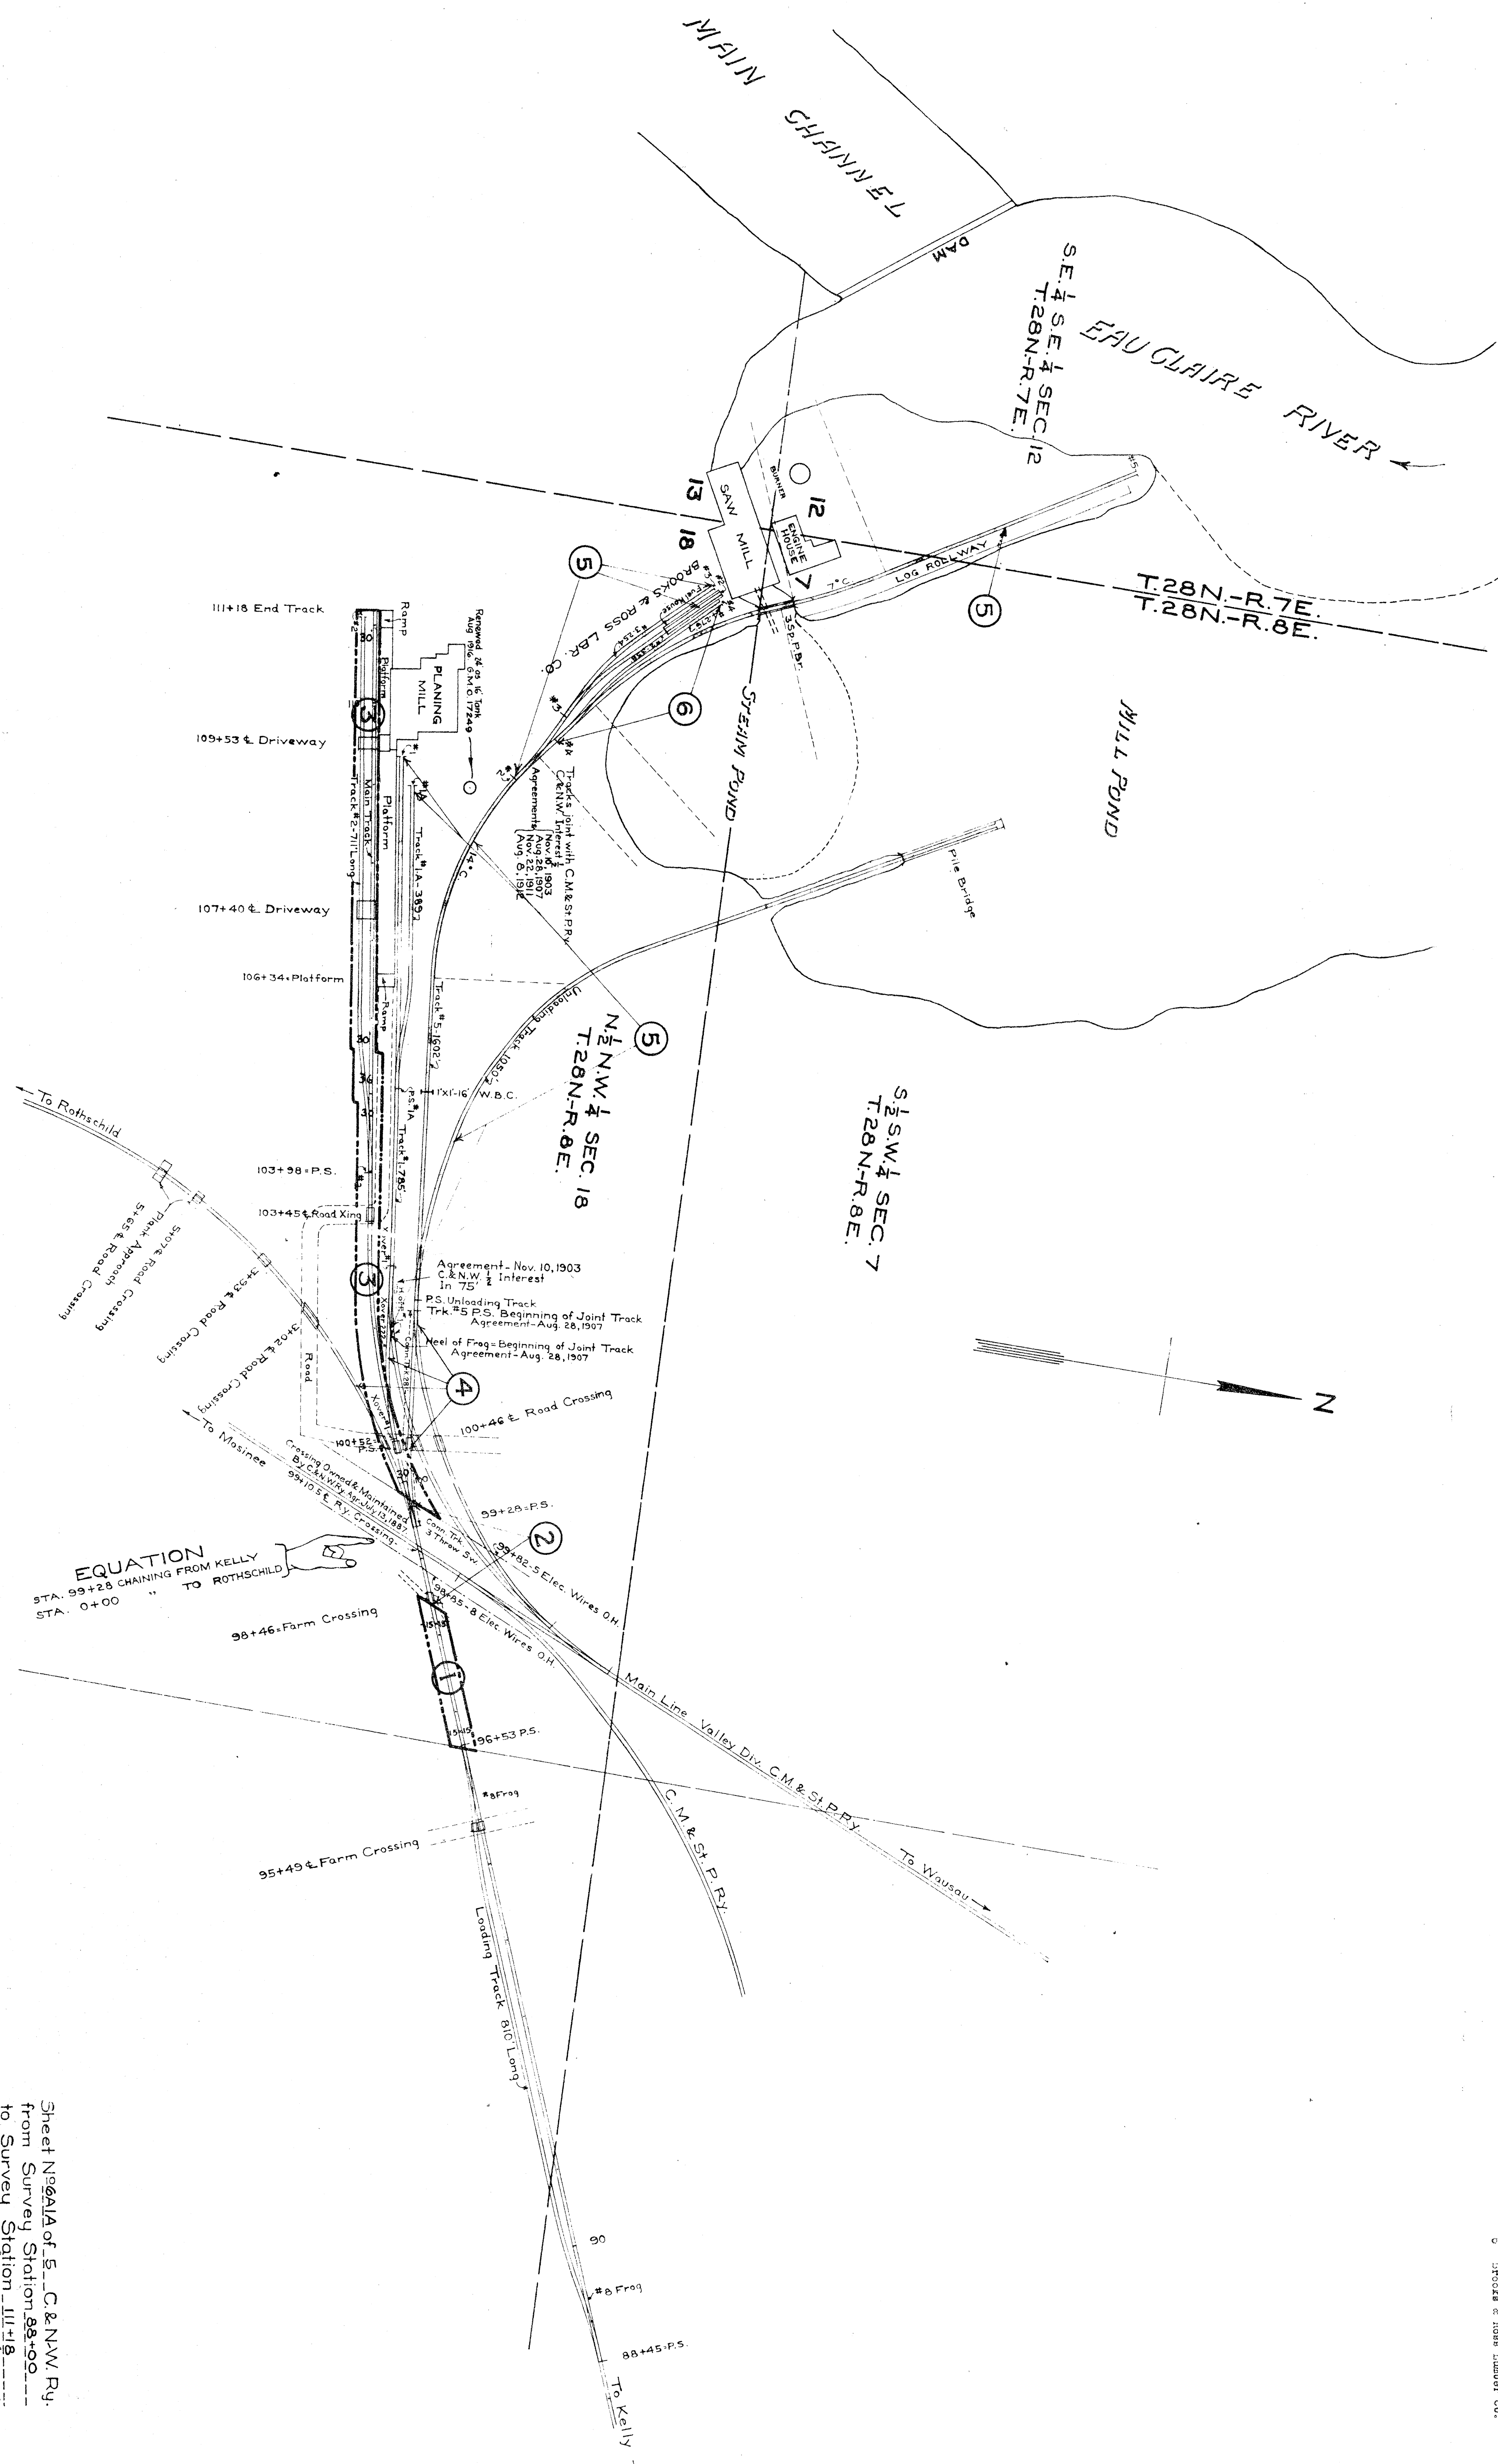


STATION MAP
LANDS, TRACKS AND STRUCTURES
CHICAGO AND NORTH-WESTERN RAILWAY
OPERATED BY THE
C. & N. W. RY. CO.
ASHLAND DIVISION
SCHOFIELD, WIS.
STA. 88+00 TO STA. 111+18
SCALE 1 IN. = 100 FT.
JUNE 30, 1917
OFFICE OF CHIEF ENGINEER
CHICAGO, ILL.

