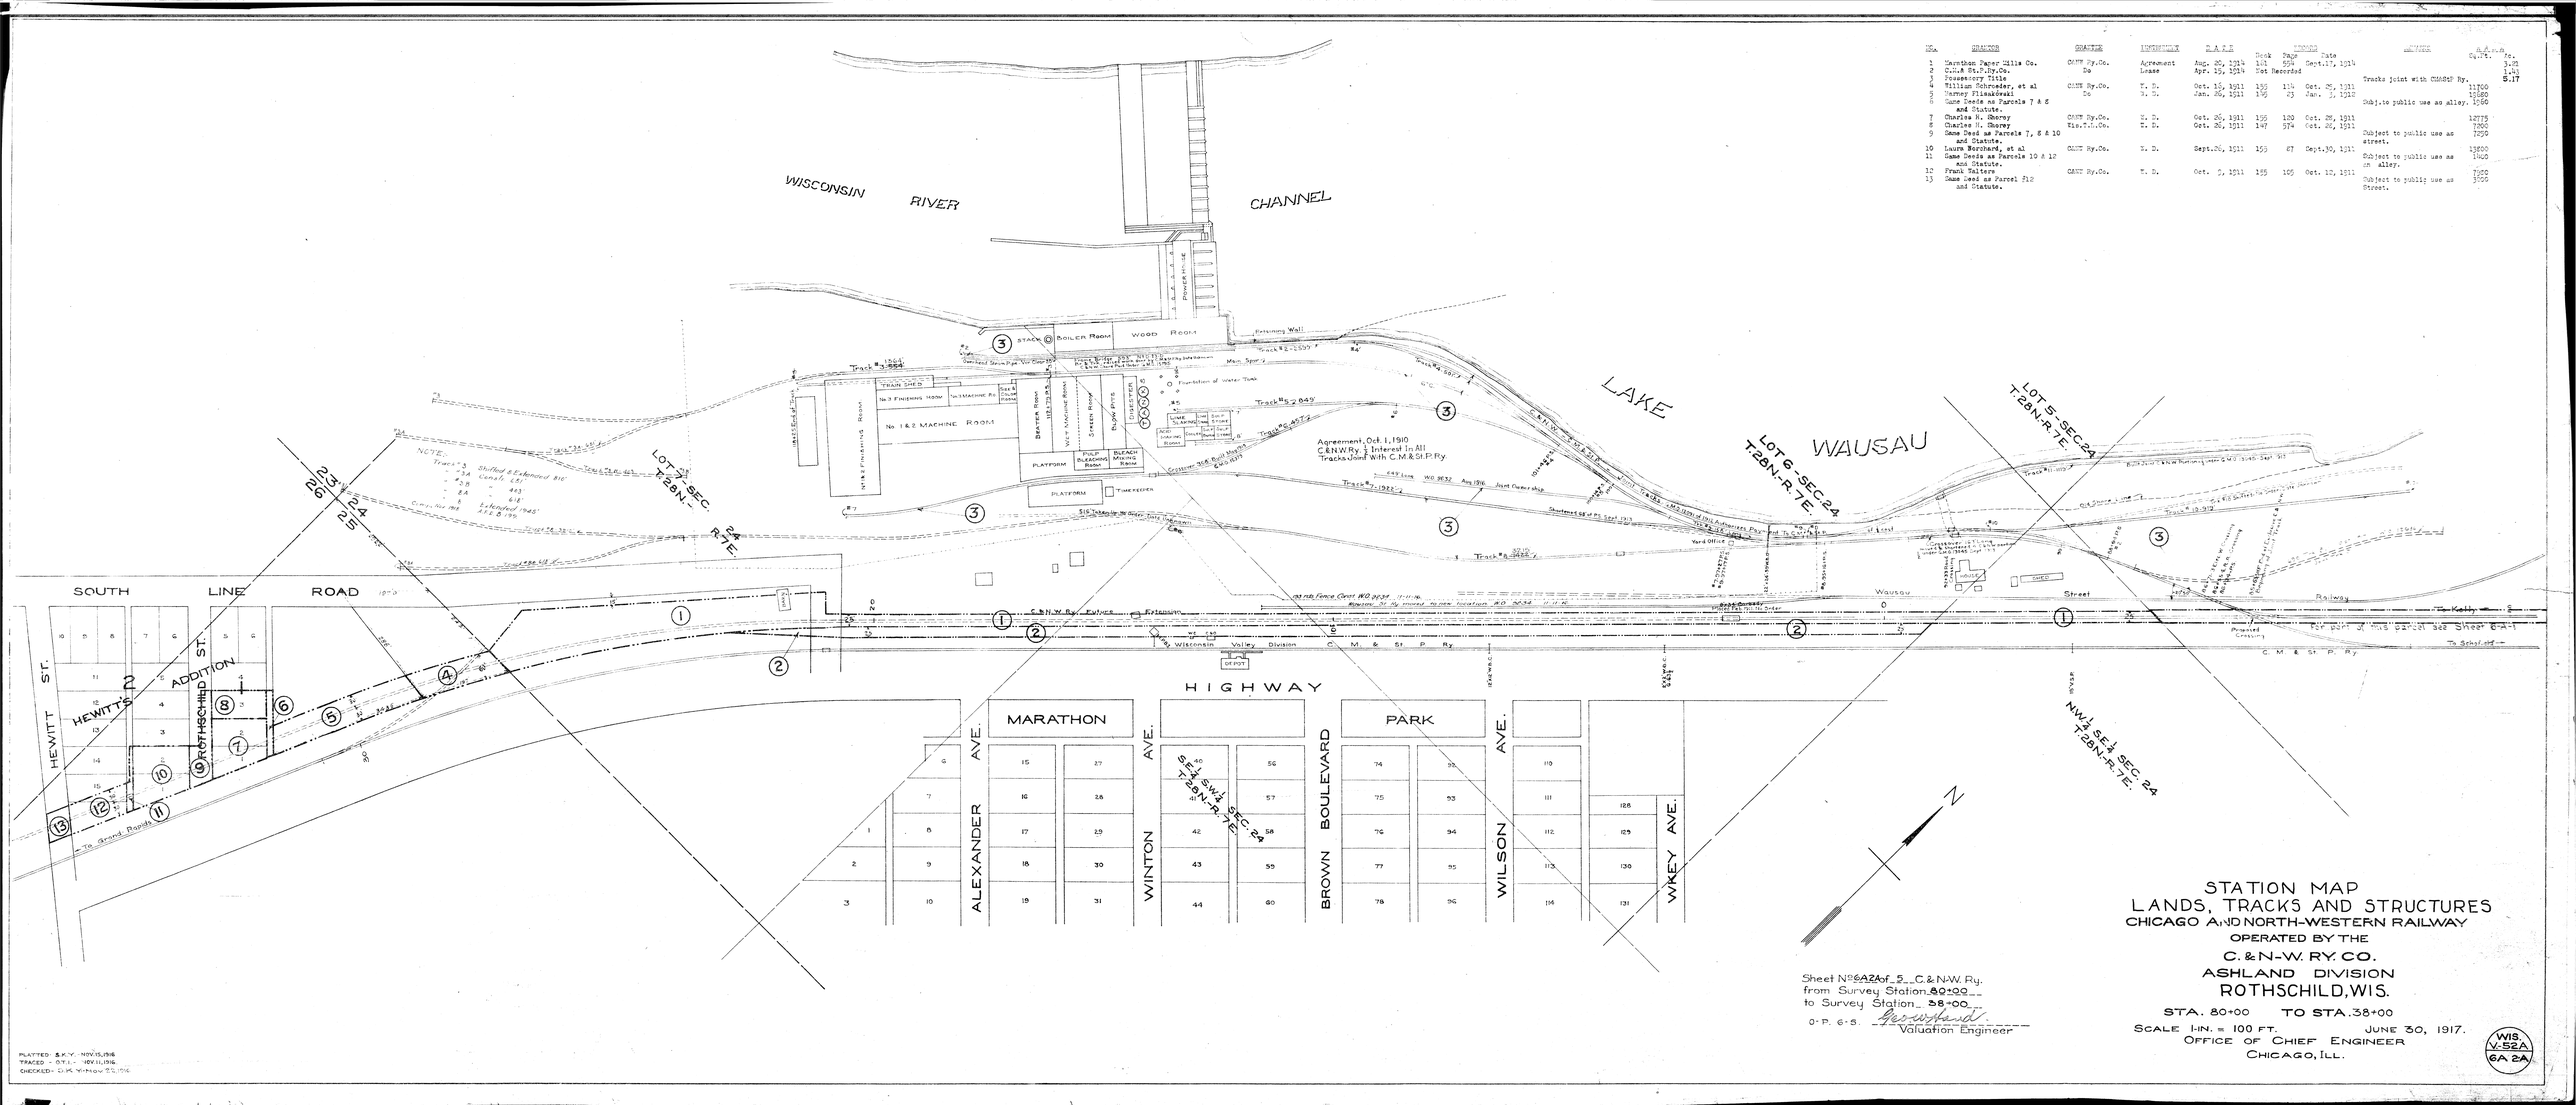

No.	Grantor	Grantee	Instrument	D A T E		Recorded		Date	Remarks	R.of.W. Sq.Ft.	Sq.Ft. Ac.
1	Marathon Paper Mills Co.	C&NW Ry.Co.	Agreement	Aug. 30, 1911		161	554	Sept.17, 1914			3.81
2	C.M.& St.P.Ry.Co.	Do	Lease	Apr. 15, 1914		Not Recorded					1.40
3	Possessory Title								Tracks Joint with CM&StP Ry.		5.17
4	William Schroeder, et al	C&NW Ry.Co.	W. D.	Oct. 15, 1911		135	114	Oct. 25, 1911		11700	
5	Tarmey Flimsdewai	Do	W. D.	Jan. 26, 1911		136	43	Jan. 3, 1912		12580	
6	Same Deeds as Parcels 7 & 8 and Statute.								Subj.to public use as alley.	1596	
7	Charles H. Sherry	C&NT Ry.Co.	W. D.	Oct. 26, 1911		135	100	Oct. 26, 1911			12775
8	Charles H. Sherry	Wis.T.T.Co.	W. D.	Oct. 26, 1911		147	574	Oct. 26, 1911			7260
9	Same Deed as Parcels 7, 8 & 10 and Statute.								Subject to public use as street.		7200
10	Laura Borchard, et al	C&NT Ry.Co.	W. D.	Sept.26, 1911		153	67	Sept.30, 1911			13200
11	Same Deeds as Parcels 10 & 12 and Statute.								Subject to public use as an alley.		1440
12	Frank Walters	C&NT Ry.Co.	W. D.	Oct. 2, 1911		135	105	Oct. 12, 1911			7260
13	Same Deed as Parcel #12 and Statute.								Subject to public use as Street.		3700

PLATTED - S.K.Y. NOV.15,1916
TRACED - O.P.L. NOV.11,1916
CHECKED - G.M.K. NOV.22,1916

Sheet No. 6A2A of 5 C.&N.W.Ry.
from Survey Station 80+00
to Survey Station 38+00
O.P. 6-5. _____
Valuation Engineer

STATION MAP
LANDS, TRACKS AND STRUCTURES
CHICAGO AND NORTH-WESTERN RAILWAY
OPERATED BY THE
C. & N-W. RY. CO.
ASHLAND DIVISION
ROTHSCHILD, WIS.

STA. 80+00 TO STA. 38+00
SCALE 1-IN. = 100 FT. JUNE 30, 1917.
OFFICE OF CHIEF ENGINEER
CHICAGO, ILL.

WIS V-52A 6A 2A