


PLATTED - S.K.V. - OCT. 13, 1916.
REVIEWED - S.K.V. - OCT. 13, 1916.
CHECKED - S.K.V. - NOV. 2, 1916.

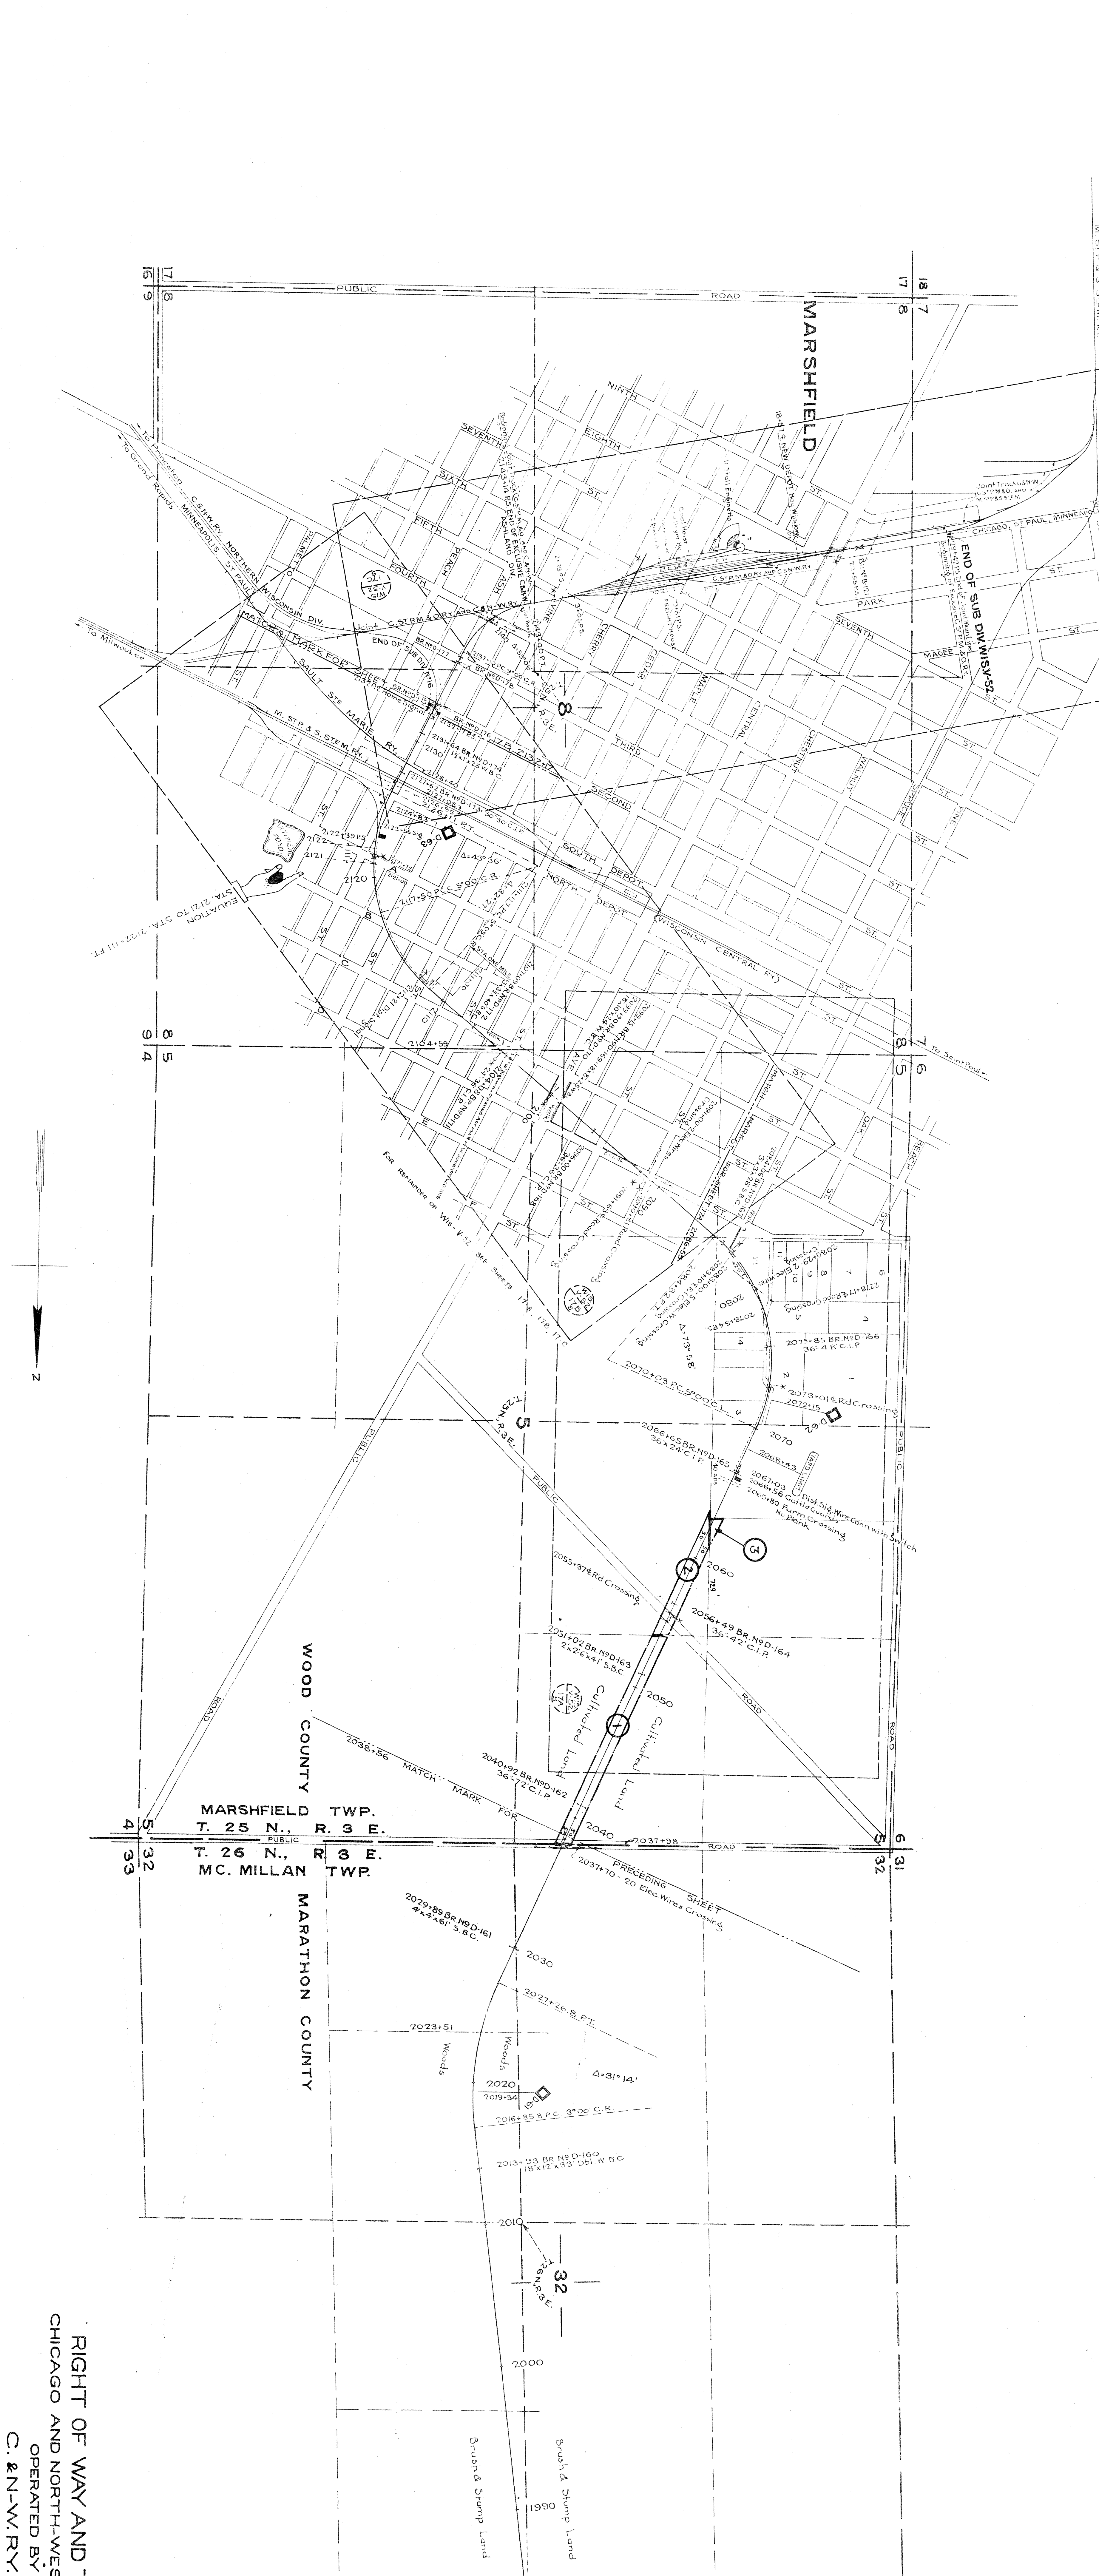

RIGHT OF WAY AND TRACK MAP
CHICAGO AND NORTH-WESTERN RAILWAY
OPERATED BY THE
C. & N.W. RY. CO.
ASHLAND DIVISION
ELAND, WIS. TO MARSHFIELD, WIS.
STA. 2038+56 TO STA. 2143+00
SCALE 1 IN. = 400-FT. JUNE 30, 1917.
OFFICE OF CHIEF ENGINEER
CHICAGO, ILL.

Sheet No. 17, of
from Survey Station 2038+56
to Survey Station 2143+00
17-P 16-5.
Valuation Engineer

1. All data taken, etc., at
2. Name of Engineer
3. Date
4. Date
