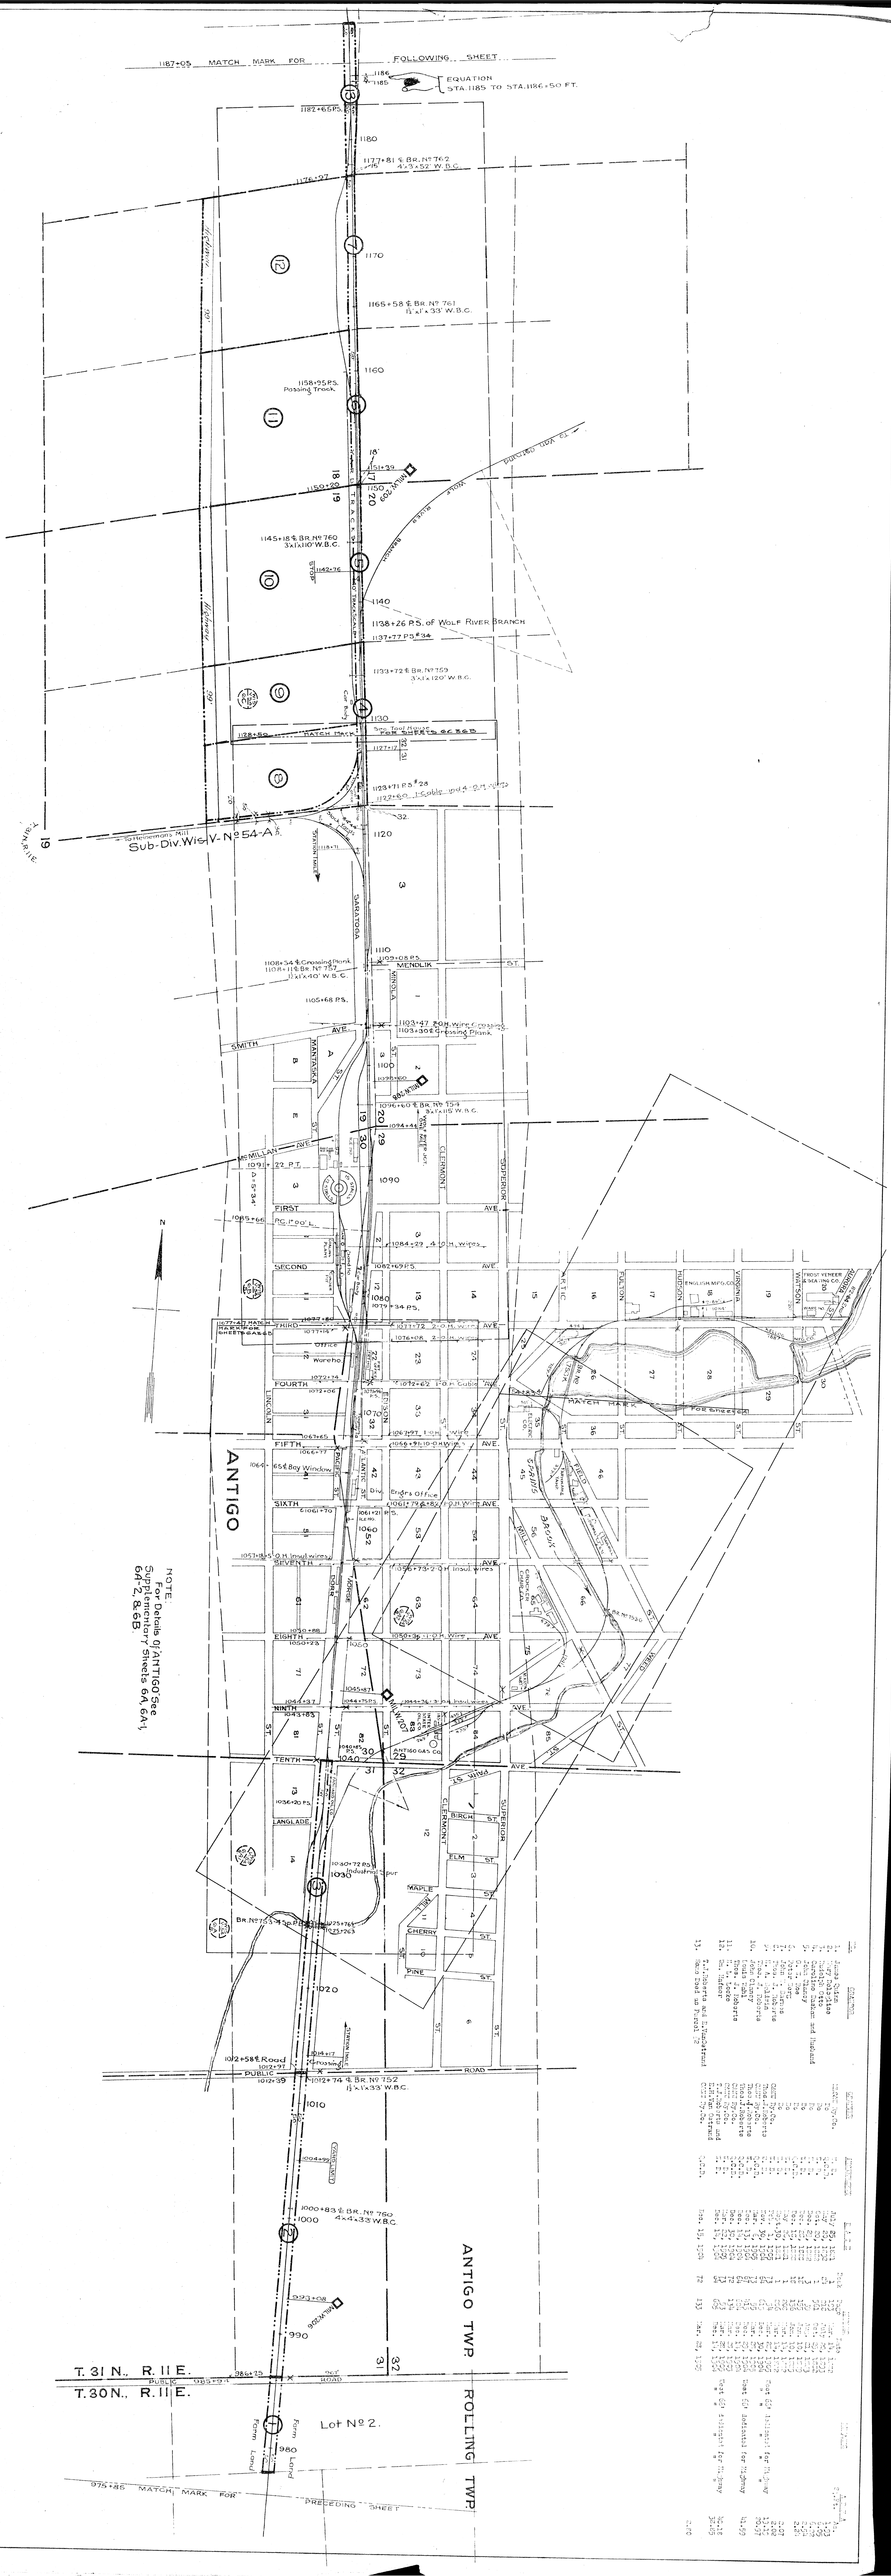

NOTE. For Details of ANTIGO See Supplementary Sheets 6A, 6A1, 6A2, & 6B

Street Nº 6 on C.&N.W.Ry. from Survey Station 375+85 to Survey Station 1187+05 25-P 14-S.

Valuation Engineer.

RIGHT OF WAY AND TRACK MAP
CHICAGO AND NORTH-WESTERN RAILWAY
OPERATED BY THE
C. & N.W. RY. CO.
ASHLAND DIVISION
ELAND, WIS. TO STATE LINE, MICH.
STA. 375+85 TO STA. 1187+05
SCALE: 1 IN. = 400 FT.
JUNE 30, 1917.
OFFICE OF CHIEF ENGINEER
CHICAGO, ILL.

WIS V-54 6