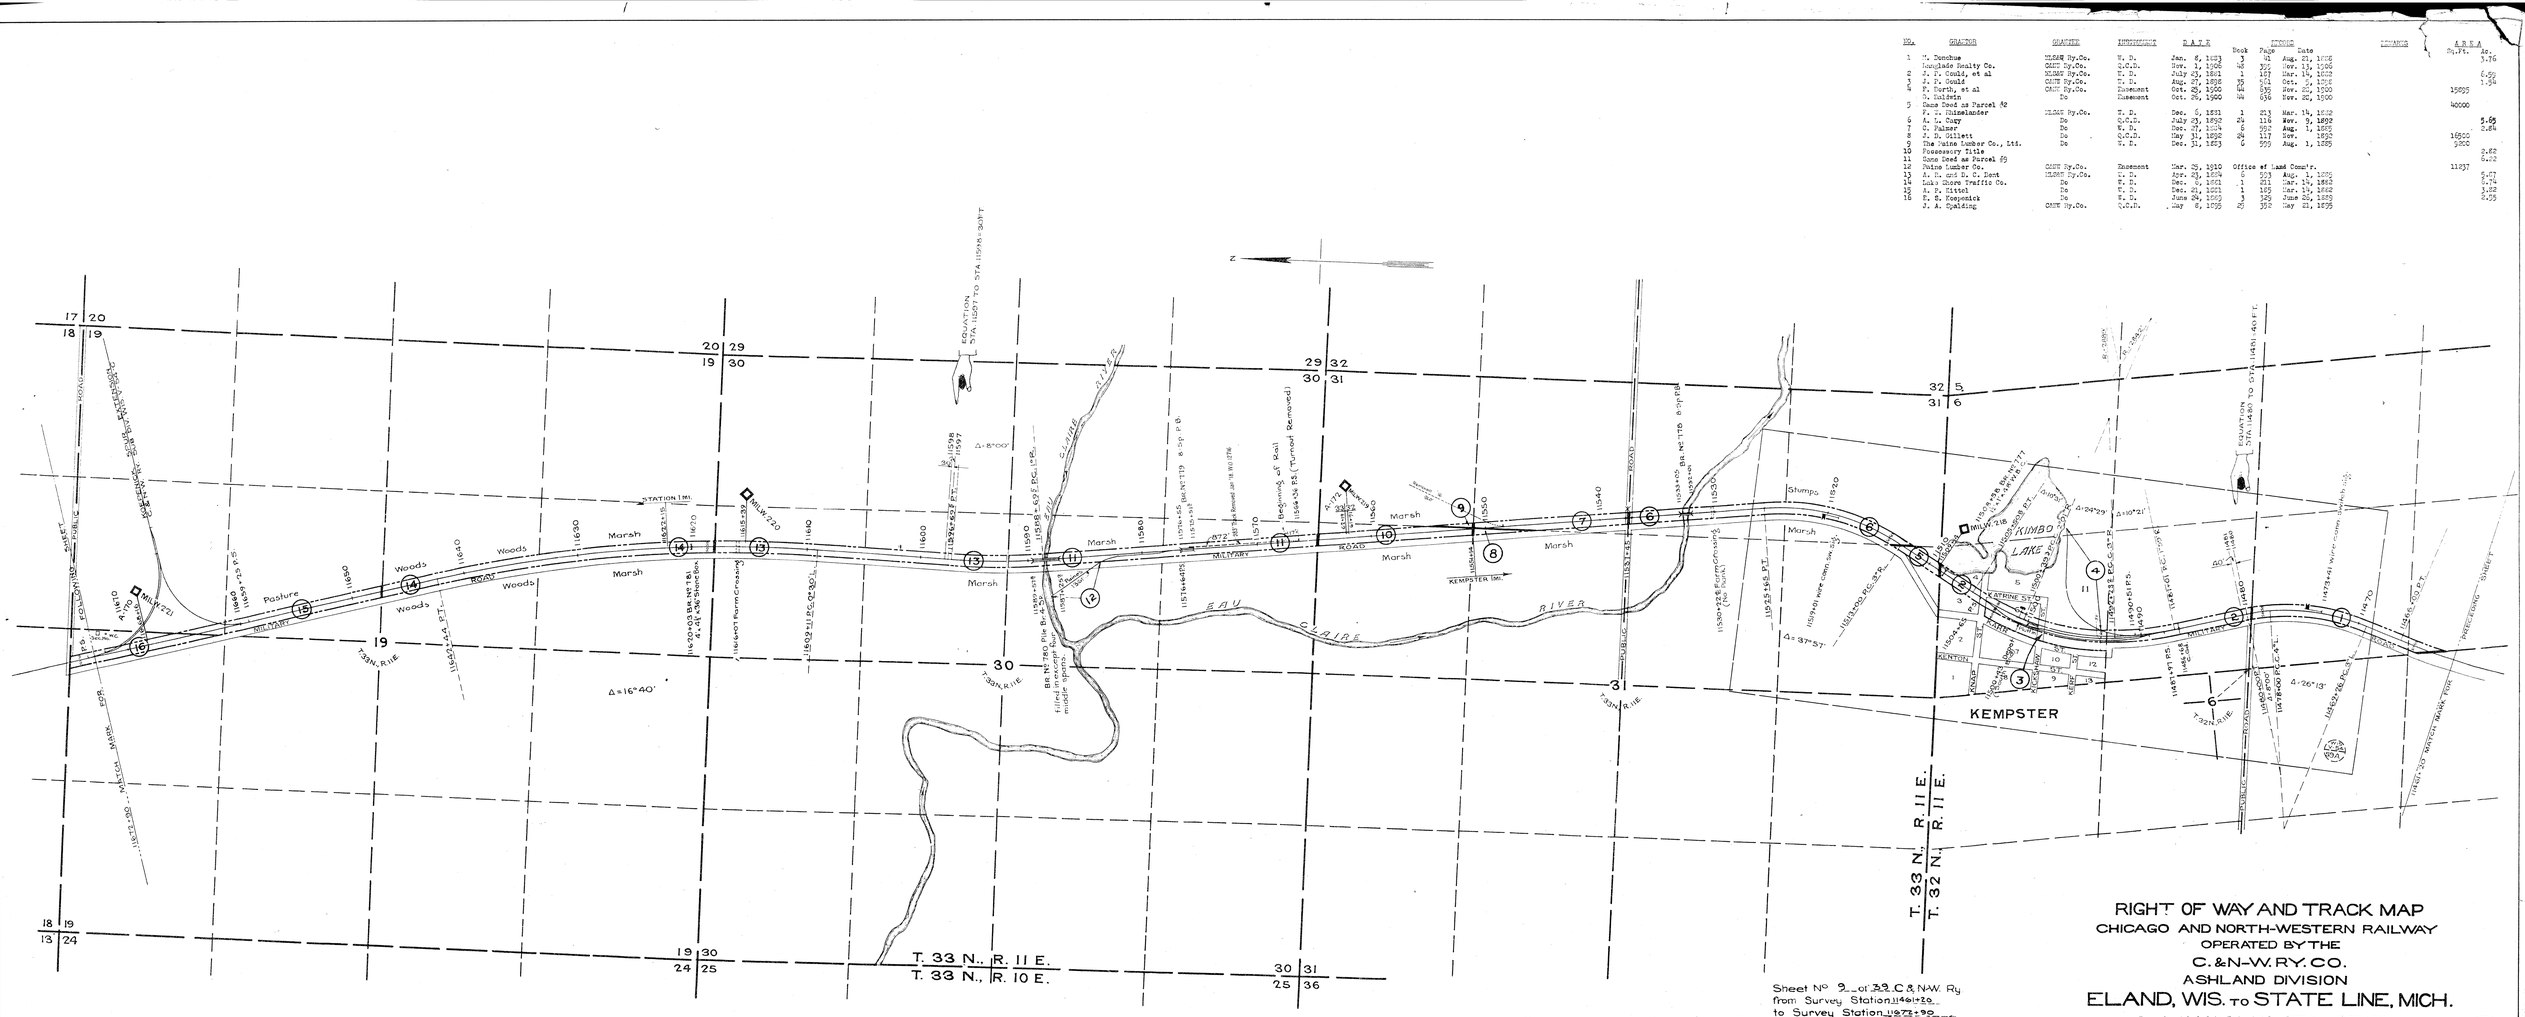

NO.	GRANTOR	GRANTEE	INSTRUMENT	DATE	RECORD Book	Page	Date	REMARKS	AREA Sq.Ft.	Ac.
1	T. Donohue	MLSAR Ry.Co.	W. D.	Jan. 6, 1883	3	41	Aug. 23, 1916			3.76
	Douglade Realty Co.	CANT Ry.Co.	Q.C.D.	Nov. 1, 1906	40	355	Nov. 13, 1906			
2	J. P. Could, et al	MLSAR Ry.Co.	W. D.	July 23, 1881	1	167	Mar. 14, 1882			6.99
3	J. P. Could	CANT Ry.Co.	W. D.	Aug. 27, 1898	55	401	Oct. 5, 1916			1.34
4	F. Porth, et al	CANT Ry.Co.	Easement	Oct. 25, 1900	44	635	Nov. 22, 1900		15625	
	T. Baldwin	Do	Easement	Oct. 29, 1900	44	636	Nov. 22, 1900			
5	Same Deed as Parcel #2								40000	
	F. C. Rhinelander	MLSAR Ry.Co.	W. D.	Dec. 6, 1881	1	213	Mar. 14, 1882			
6	A. L. Carp	Do	Q.C.D.	July 23, 1892	29	116	Nov. 5, 1892			5.66
7	C. Palmer	Do	W. D.	Dec. 27, 1884	6	597	Aug. 1, 1885			2.84
8	J. D. Gillett	Do	Q.C.D.	May 31, 1892	28	117	Nov. 1892		16500	
9	The Paine Lumber Co., Ltd.	Do	W. D.	Dec. 31, 1883	6	599	Aug. 1, 1885		9800	
10	Possessory Title									2.82
11	Same Deed as Parcel #9									6.02
12	Paine Lumber Co.	CANT Ry.Co.	Easement	Mar. 25, 1910	Office of Land Comm'r.				11237	
13	A. M. and E. C. Dent	MLSAR Ry.Co.	W. D.	Apr. 23, 1884	6	593	Aug. 1, 1885			5.47
14	Lake Shore Traffic Co.	Do	W. D.	Dec. 6, 1901	1	201	Mar. 14, 1913			3.74
15	A. P. Tittel	Do	W. D.	Dec. 21, 1901	1	185	Mar. 14, 1902			1.82
16	F. H. Koepnick	Do	W. D.	June 24, 1899	3	345	June 28, 1899			0.55
	J. A. Spalding	CANT Ry.Co.	Q.C.D.	May 8, 1895	20	310	May 23, 1895			

PLATTED - R.G.C. - SEPT. 1, 1916.
TRACED - V.W.C. - SEPT. 22, 1916.
CHECKED - R.P.L. - MARCH 5, 1917.

Sheet No 9 of 32 C & N-W. Ry
from Survey Station 11461+20
to Survey Station 11672+90
25-P. 14-S.

Valuation Engineer

RIGHT OF WAY AND TRACK MAP
CHICAGO AND NORTH-WESTERN RAILWAY
OPERATED BY THE
C. & N-W. RY. CO.
ASHLAND DIVISION
ELAND, WIS. TO STATE LINE, MICH.
STA. 11461+20 TO STA. 11672+90
SCALE: 1 IN. = 400 FT. JUNE 30, 1917.
OFFICE OF CHIEF ENGINEER
CHICAGO, ILL.

WIS V-54 9