



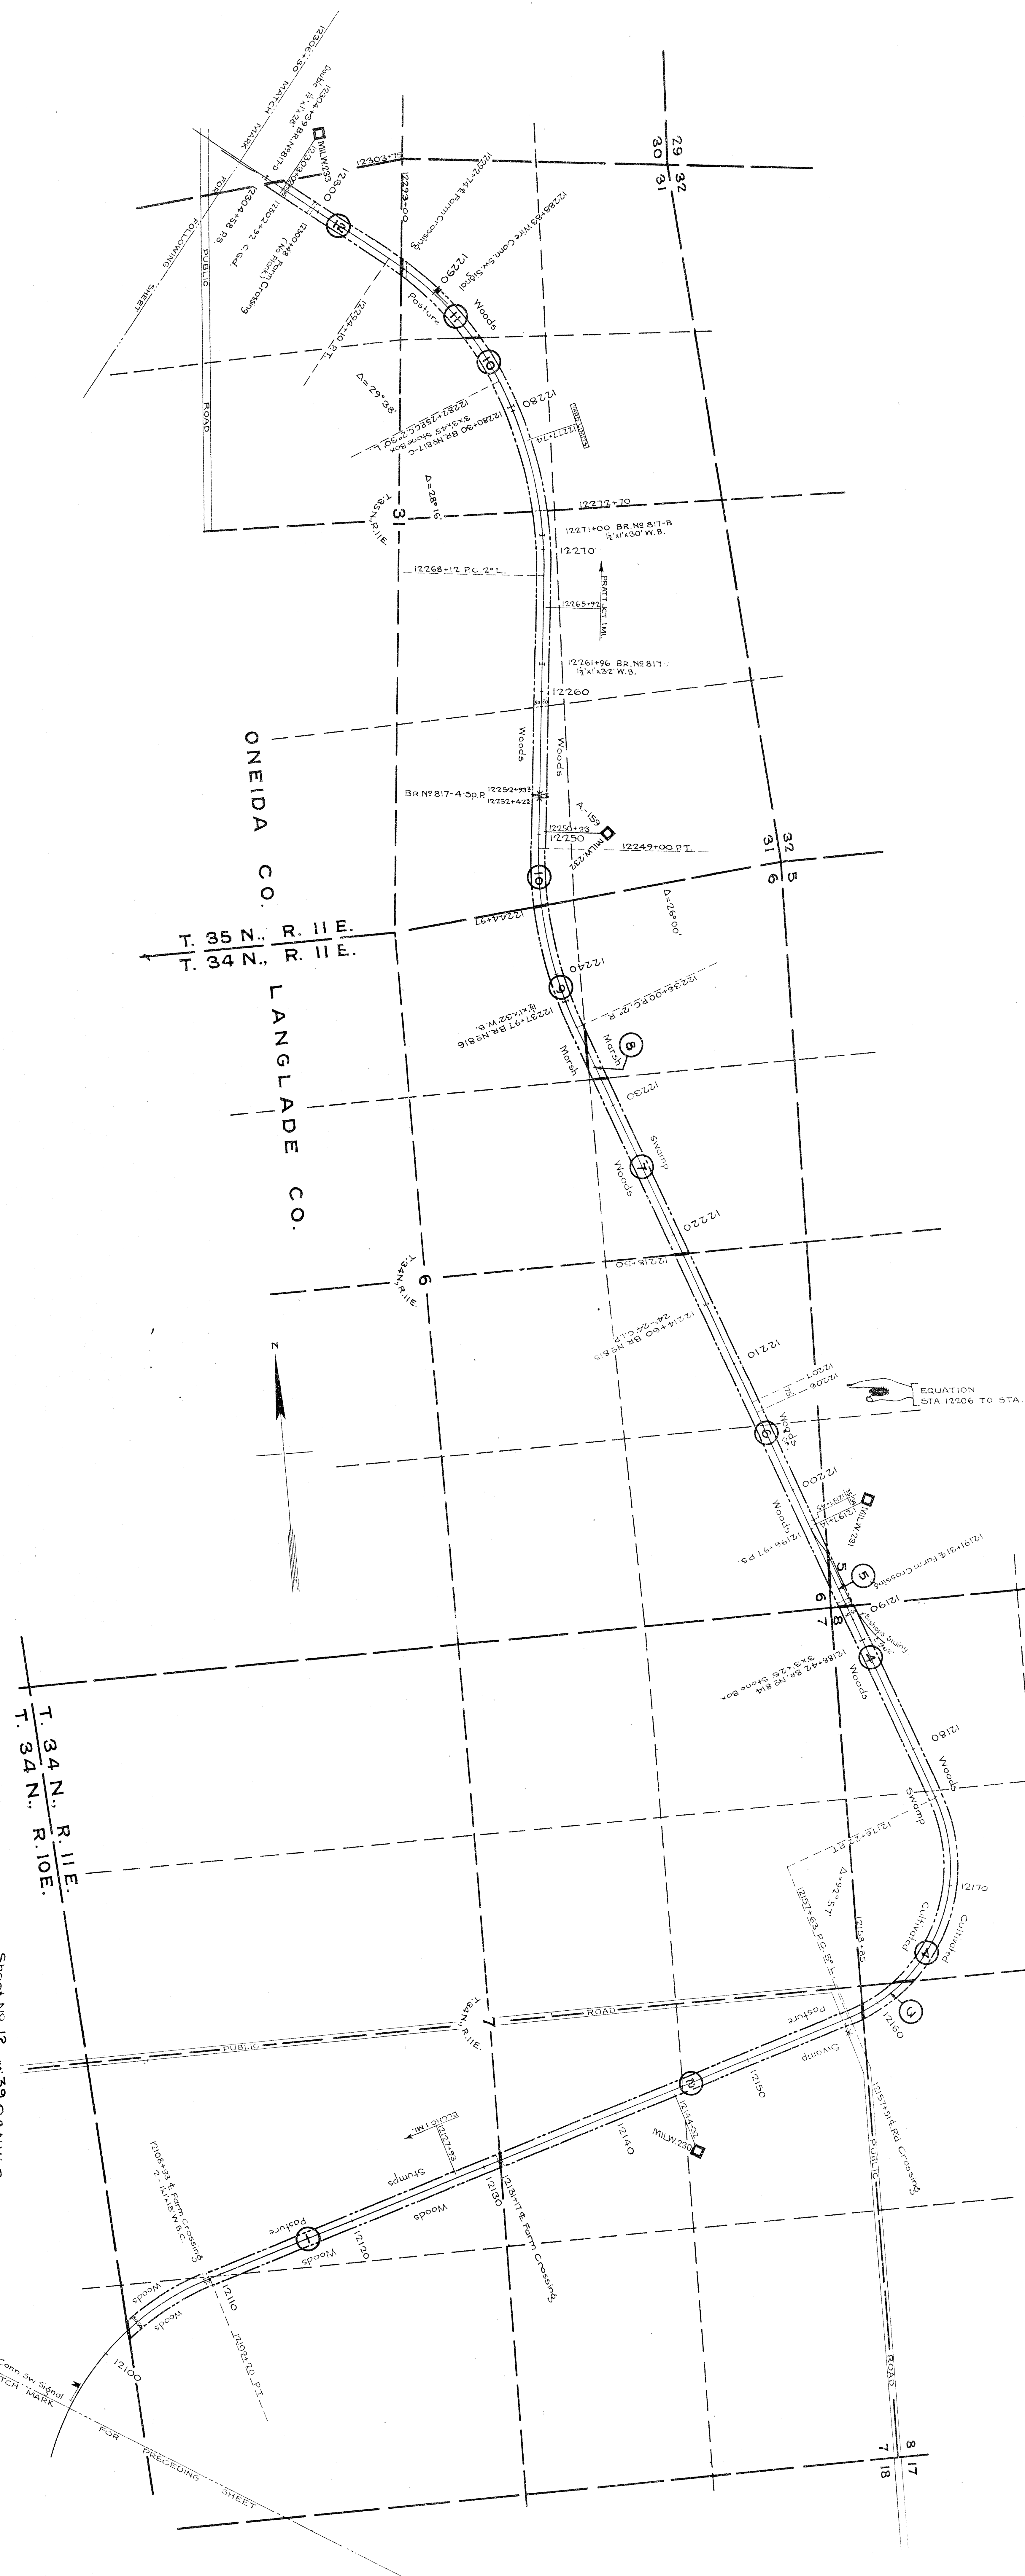

PLATTED - B.G.C. - SEPT. 5, 1916
 TRACED - W.V.C. - SEPT. 21, 1916
 CHECKED - R.R.L. - MARCH 5, 1917

Sheet No. 12, of 39 C.R.N.W. Ry.
 from Survey Station 12095+30
 to Survey Station 12306+50
 25-P. 14-S.
 Valuation Engineer

RIGHT OF WAY AND TRACK MAP
 CHICAGO AND NORTH-WESTERN RAILWAY
 OPERATED BY THE
 C. & N. W. RY. CO.
 ASHLAND DIVISION
 ELAND, WIS. TO STATE LINE, MICH.
 STA. 12095+30 TO STA. 12306+50
 SCALE: 1" = 400 FT. JUNE 30, 1917.
 OFFICE OF CHIEF ENGINEER
 ILL.