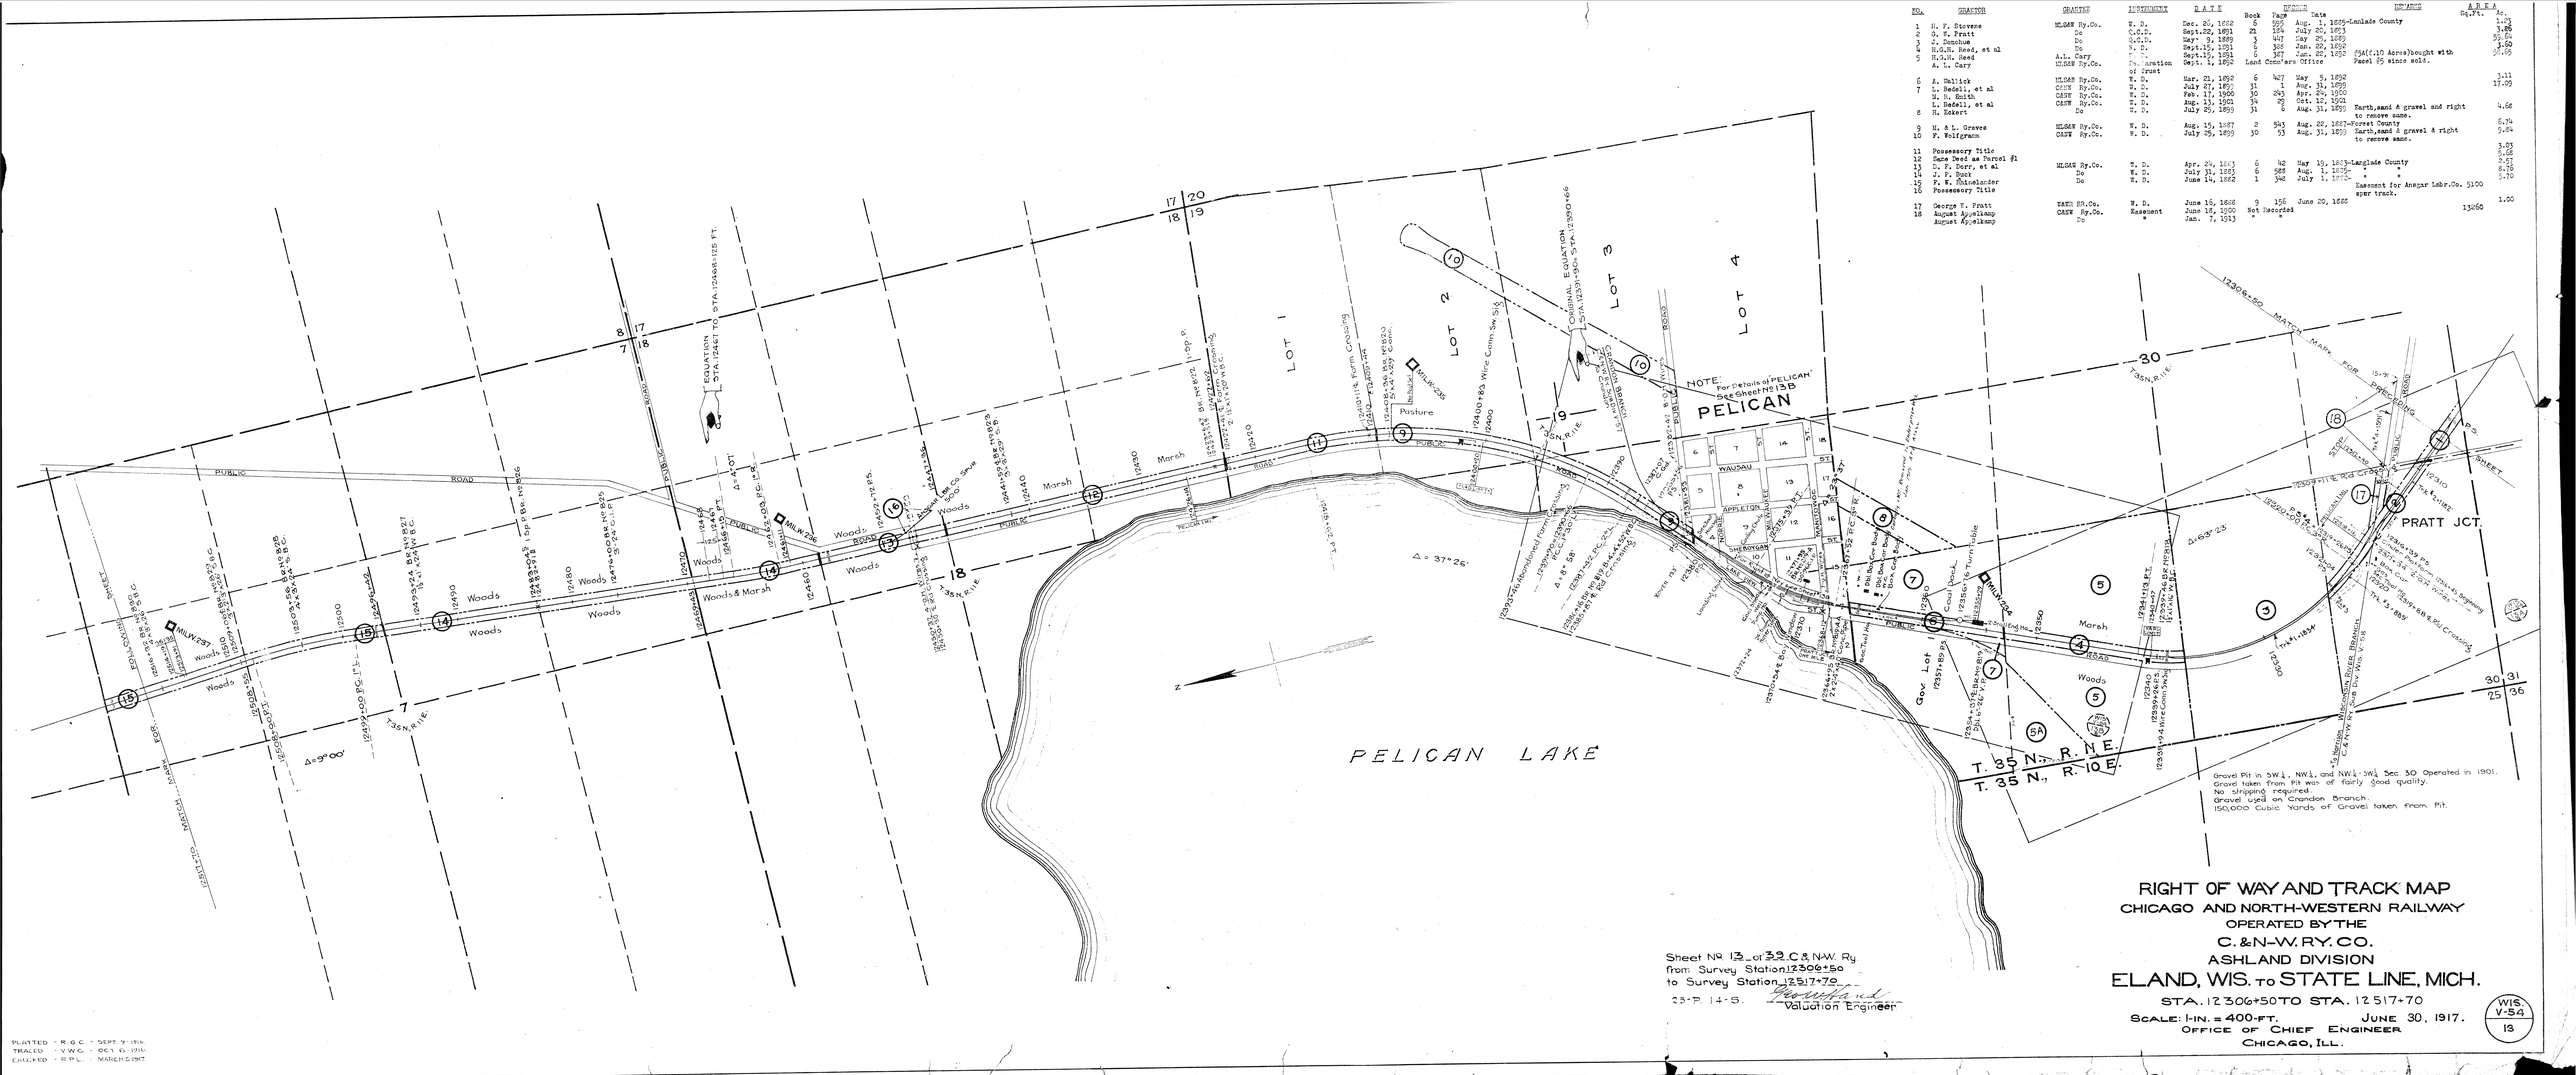

NO.	GRANTOR	GRANTEE	INSTRUMENT	RECORD Book	RECORD Page	RECORD Date	REMARKS	AREA Ac.
1	H. F. Stevens	MLS&M Ry.Co.	W. D.	Dec. 20, 1882	6	595	Aug. 1, 1885-Lenlade County	1.23
2	O. T. Pratt	Do	C.D.D.	Sept.22, 1891	24	184	July 20, 1893	3.88
3	J. Donohue	Do	C.D.D.	Sept. 3, 1889	3	447	May 29, 1893	39.54
4	H.D.H. Reed, et al	Do	W. D.	Sept.15, 1891	6	368	Jan. 22, 1892	3.60
5	H.D.H. Reed A. L. Carr	A.L. Carr MLS&M Ry.Co.	Declaration of Trust	Sept. 1, 1892	6	367	Jan. 22, 1892 Land Commers Office	39.76
6	A. Ballick	MLS&M Ry.Co.	W. D.	Mar. 21, 1892	6	427	May 5, 1892	3.11
7	L. Bedell, et al	CASW Ry.Co.	W. D.	July 27, 1892	31	1	Aug. 31, 1899	17.09
	H. H. Smith	CASW Ry.Co.	W. D.	Feb. 17, 1900	30	243	Apr. 24, 1900	
	L. Bedell, et al	CASW Ry.Co.	W. D.	Aug. 13, 1901	34	29	Oct. 12, 1901	
8	H. Eckert	Do	W. D.	July 25, 1899	31	6	Aug. 31, 1899	Earth,sand & gravel and right to remove same. 4.68
9	M. & L. Graves	MLS&M Ry.Co.	W. D.	Aug. 15, 1887	2	543	Aug. 22, 1887-Forest County	6.74
10	F. Holfgram	CASW Ry.Co.	W. D.	July 25, 1899	30	93	Aug. 31, 1899	Earth,sand & gravel & right to remove same. 9.84
11	Possessory Title							3.03
12	Same Deed as Parcel #1							5.58
13	D. F. Derr, et al	MLS&M Ry.Co.	W. D.	Apr. 24, 1883	6	42	May 15, 1883-Langlade County	2.57
14	J. P. Buck	Do	W. D.	July 31, 1883	6	588	Aug. 1, 1895 " "	8.76
15	F. W. Rhinelander	Do	W. D.	June 14, 1882	1	548	July 1, 1895 " "	5.70
16	Possessory Title						Easement for Anegar Lmbr.Co. 5100 spur track.	1.00
17	George T. Pratt	WASH RR.Co.	W. D.	June 16, 1888	9	156	June 20, 1888	13260
18	August Appelkamp August Appelkamp	CASW Ry.Co. Do	Easement "	June 18, 1900 Jan. 7, 1913	Not Recorded "	"		

PLATTED - R.G.C. - SEPT. 9- 1916.
TRACED - V.W.G. - OCT. 6- 1916.
CHECKED - R.P.L. - MARCH 5 1917.

Sheet No 13 of 32 Sheets C.& N-W. Ry
from Survey Station 12306+50
to Survey Station 12517+70
25-P. 14-S.

Valuation Engineer

RIGHT OF WAY AND TRACK MAP
CHICAGO AND NORTH-WESTERN RAILWAY
OPERATED BY THE
C. & N-W. RY. CO.
ASHLAND DIVISION
ELAND, WIS. TO STATE LINE, MICH.
STA. 12306+50 TO STA. 12517+70

SCALE: 1 IN. = 400 FT. JUNE 30, 1917.
OFFICE OF CHIEF ENGINEER
CHICAGO, ILL.

WIS. V-54 13