



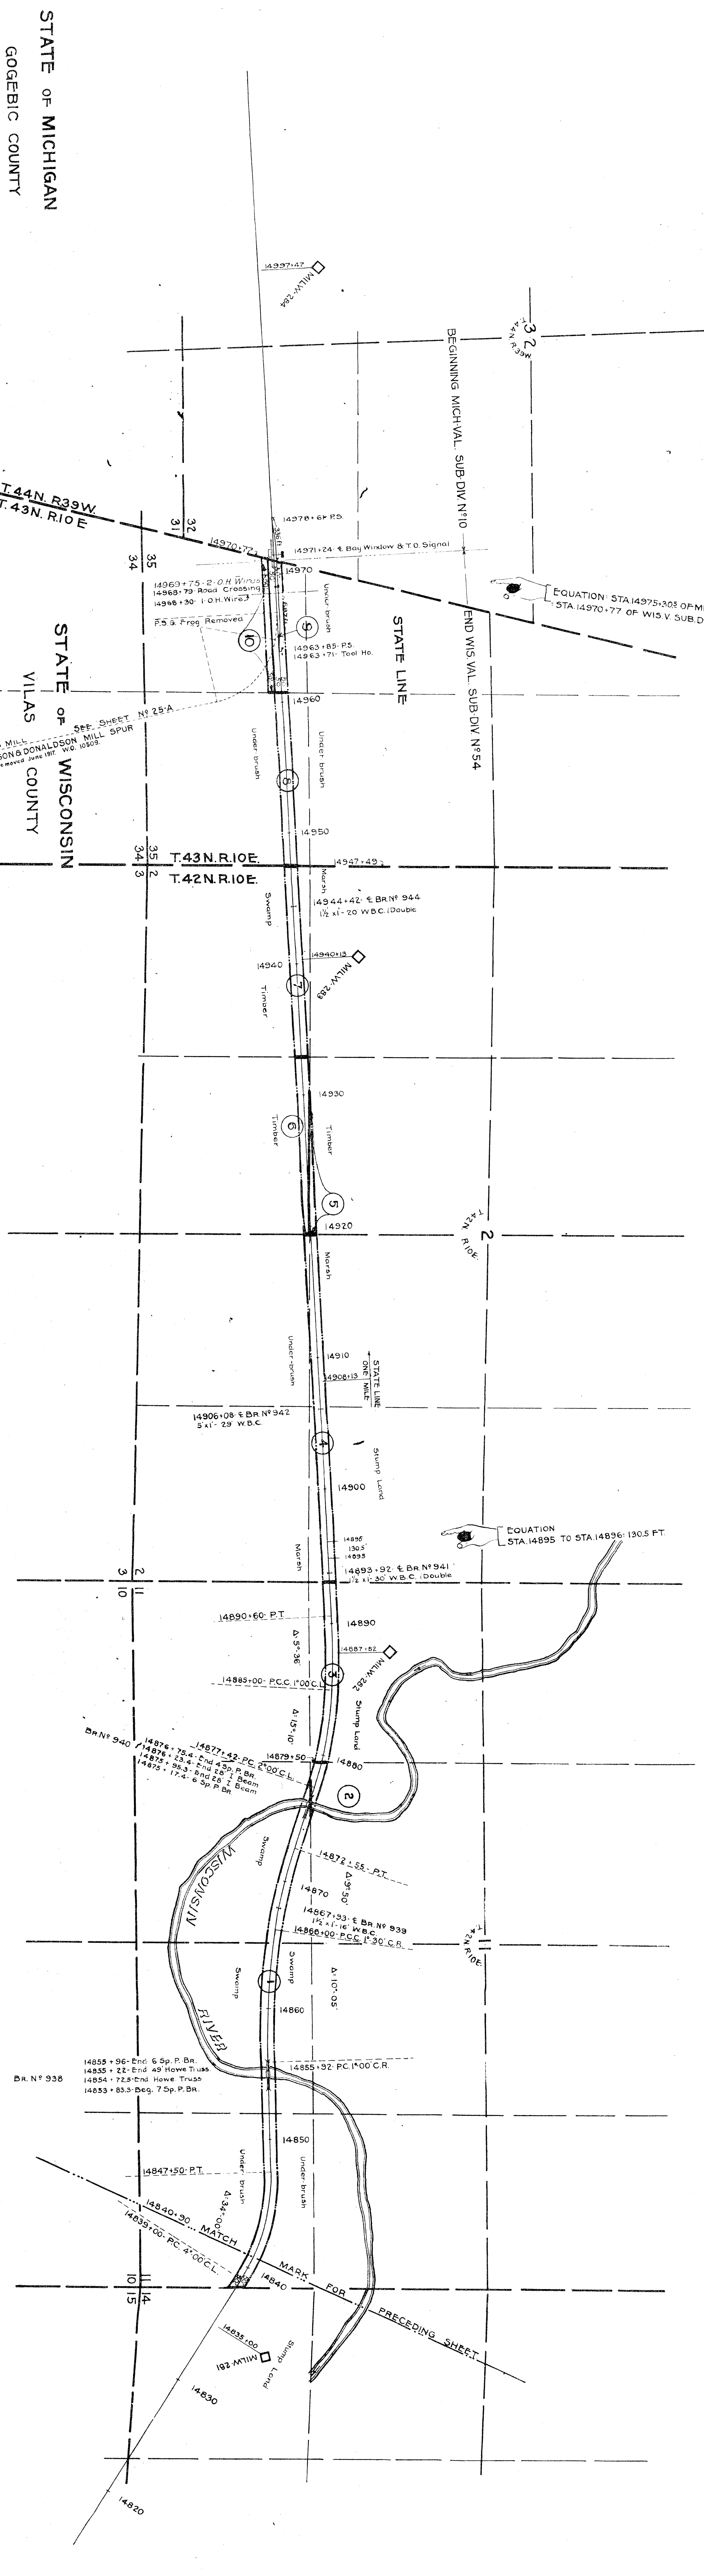

Sheet No. 25, of 39 C. & N.W. Ry.
from Survey Station 14840+90
to Survey Station 14970+77
25-P. 14-S.

RIGHT OF WAY AND TRACK MAP
CHICAGO AND NORTH-WESTERN RAILWAY
OPERATED BY THE
C. & N.W. RY. CO.
ASHLAND DIVISION
ELAND, WIS. TO STATE LINE, MICH.
STA. 14840+90 TO STA. 14970+77
SCALE: 1-IN. = 400-FT.
JUNE 30, 1917.
OFFICE OF CHIEF ENGINEER
CHICAGO, ILL.

WIS.
V.54
25

STATE OF MICHIGAN
GOOGEBIC COUNTY

STATE OF WISCONSIN
VILAS COUNTY

STATE LINE

WISCONSIN RIVER

PRECEDING SHEET







