



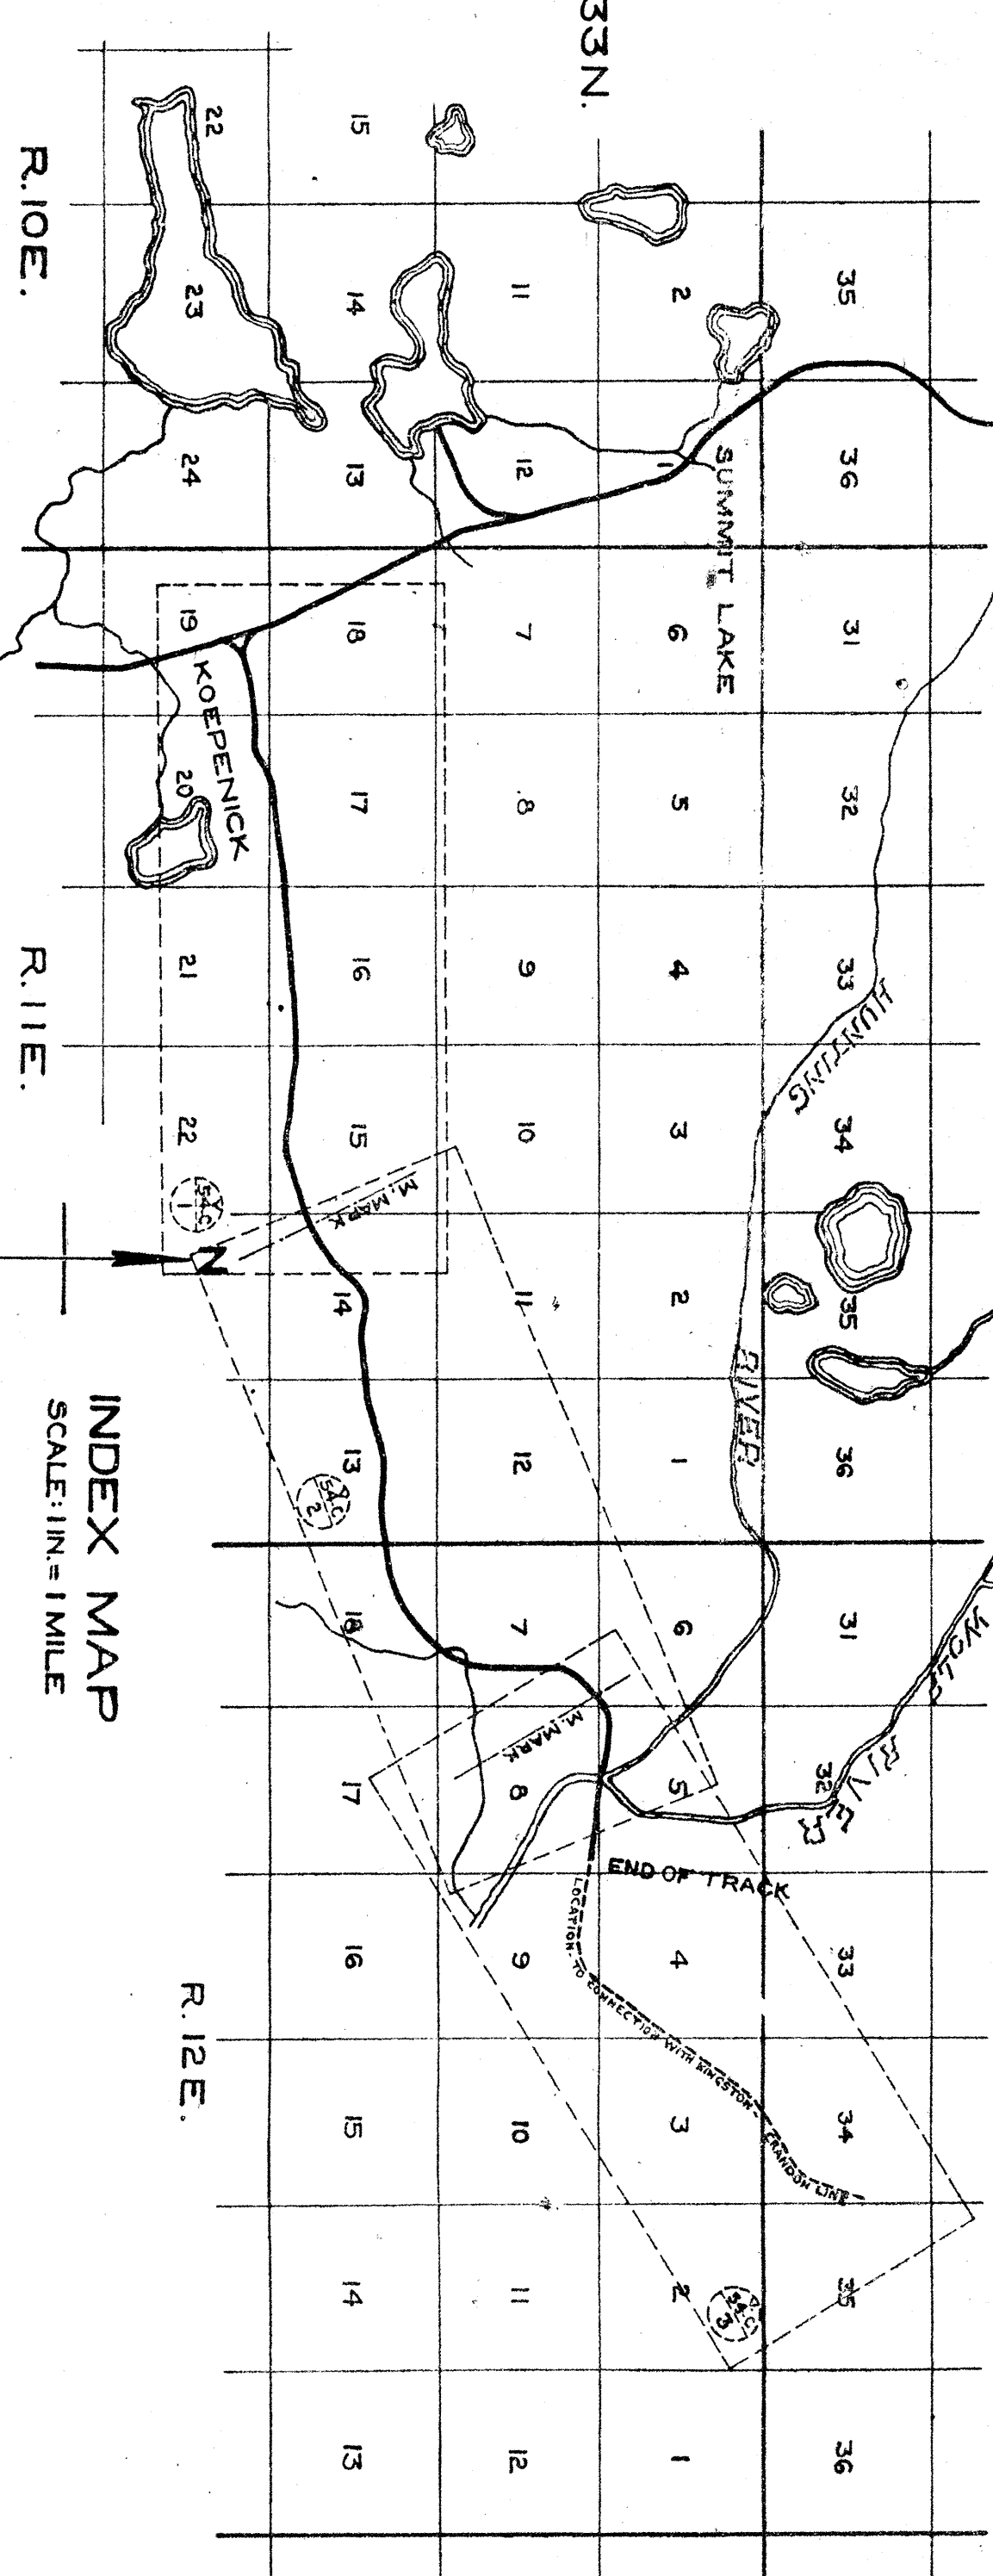

INDEX MAP
SCALE 1" = 1 MILE

 

RIGHT OF WAY AND TRACK MAP
CHICAGO AND NORTH-WESTERN RAILWAY
OPERATED BY THE
C. & N. W. RY. CO.
ASHLAND DIVISION

SCALE 1" = 400 FT.
TO STA. 148+00
JUNE 30, 1917
CHIEF ENGINEER
CHICAGO, ILL.

Correct
Valuation Engineer

Subscribed and sworn to before me, this 10th day of April, 1917
Notary Public in and for the
County of Cook
State of Illinois

My commission expires May 11, 1918