


NO.	GRANTOR	DATE	RECORD	DATE	RECORD	DATE	RECORD
1	State of Wisconsin	June 7, 1856	Book 21	Aug. 11, 1856	Sheet of Ray across land	2.21	
2	Isaac Asper	Oct. 27, 1893	17	1893	1.06		
3	George C. Swallow	Oct. 27, 1893	17	1893	1.40		
4	Isaac Asper	Oct. 27, 1893	17	1893	1.85		
5	Franklin P. Hiles	Oct. 27, 1904	Not recorded				
6	Isaac Asper	Oct. 27, 1904	Not recorded				
7	The Northwestern Lumber Co.	Dec. 24, 1909	Not recorded				

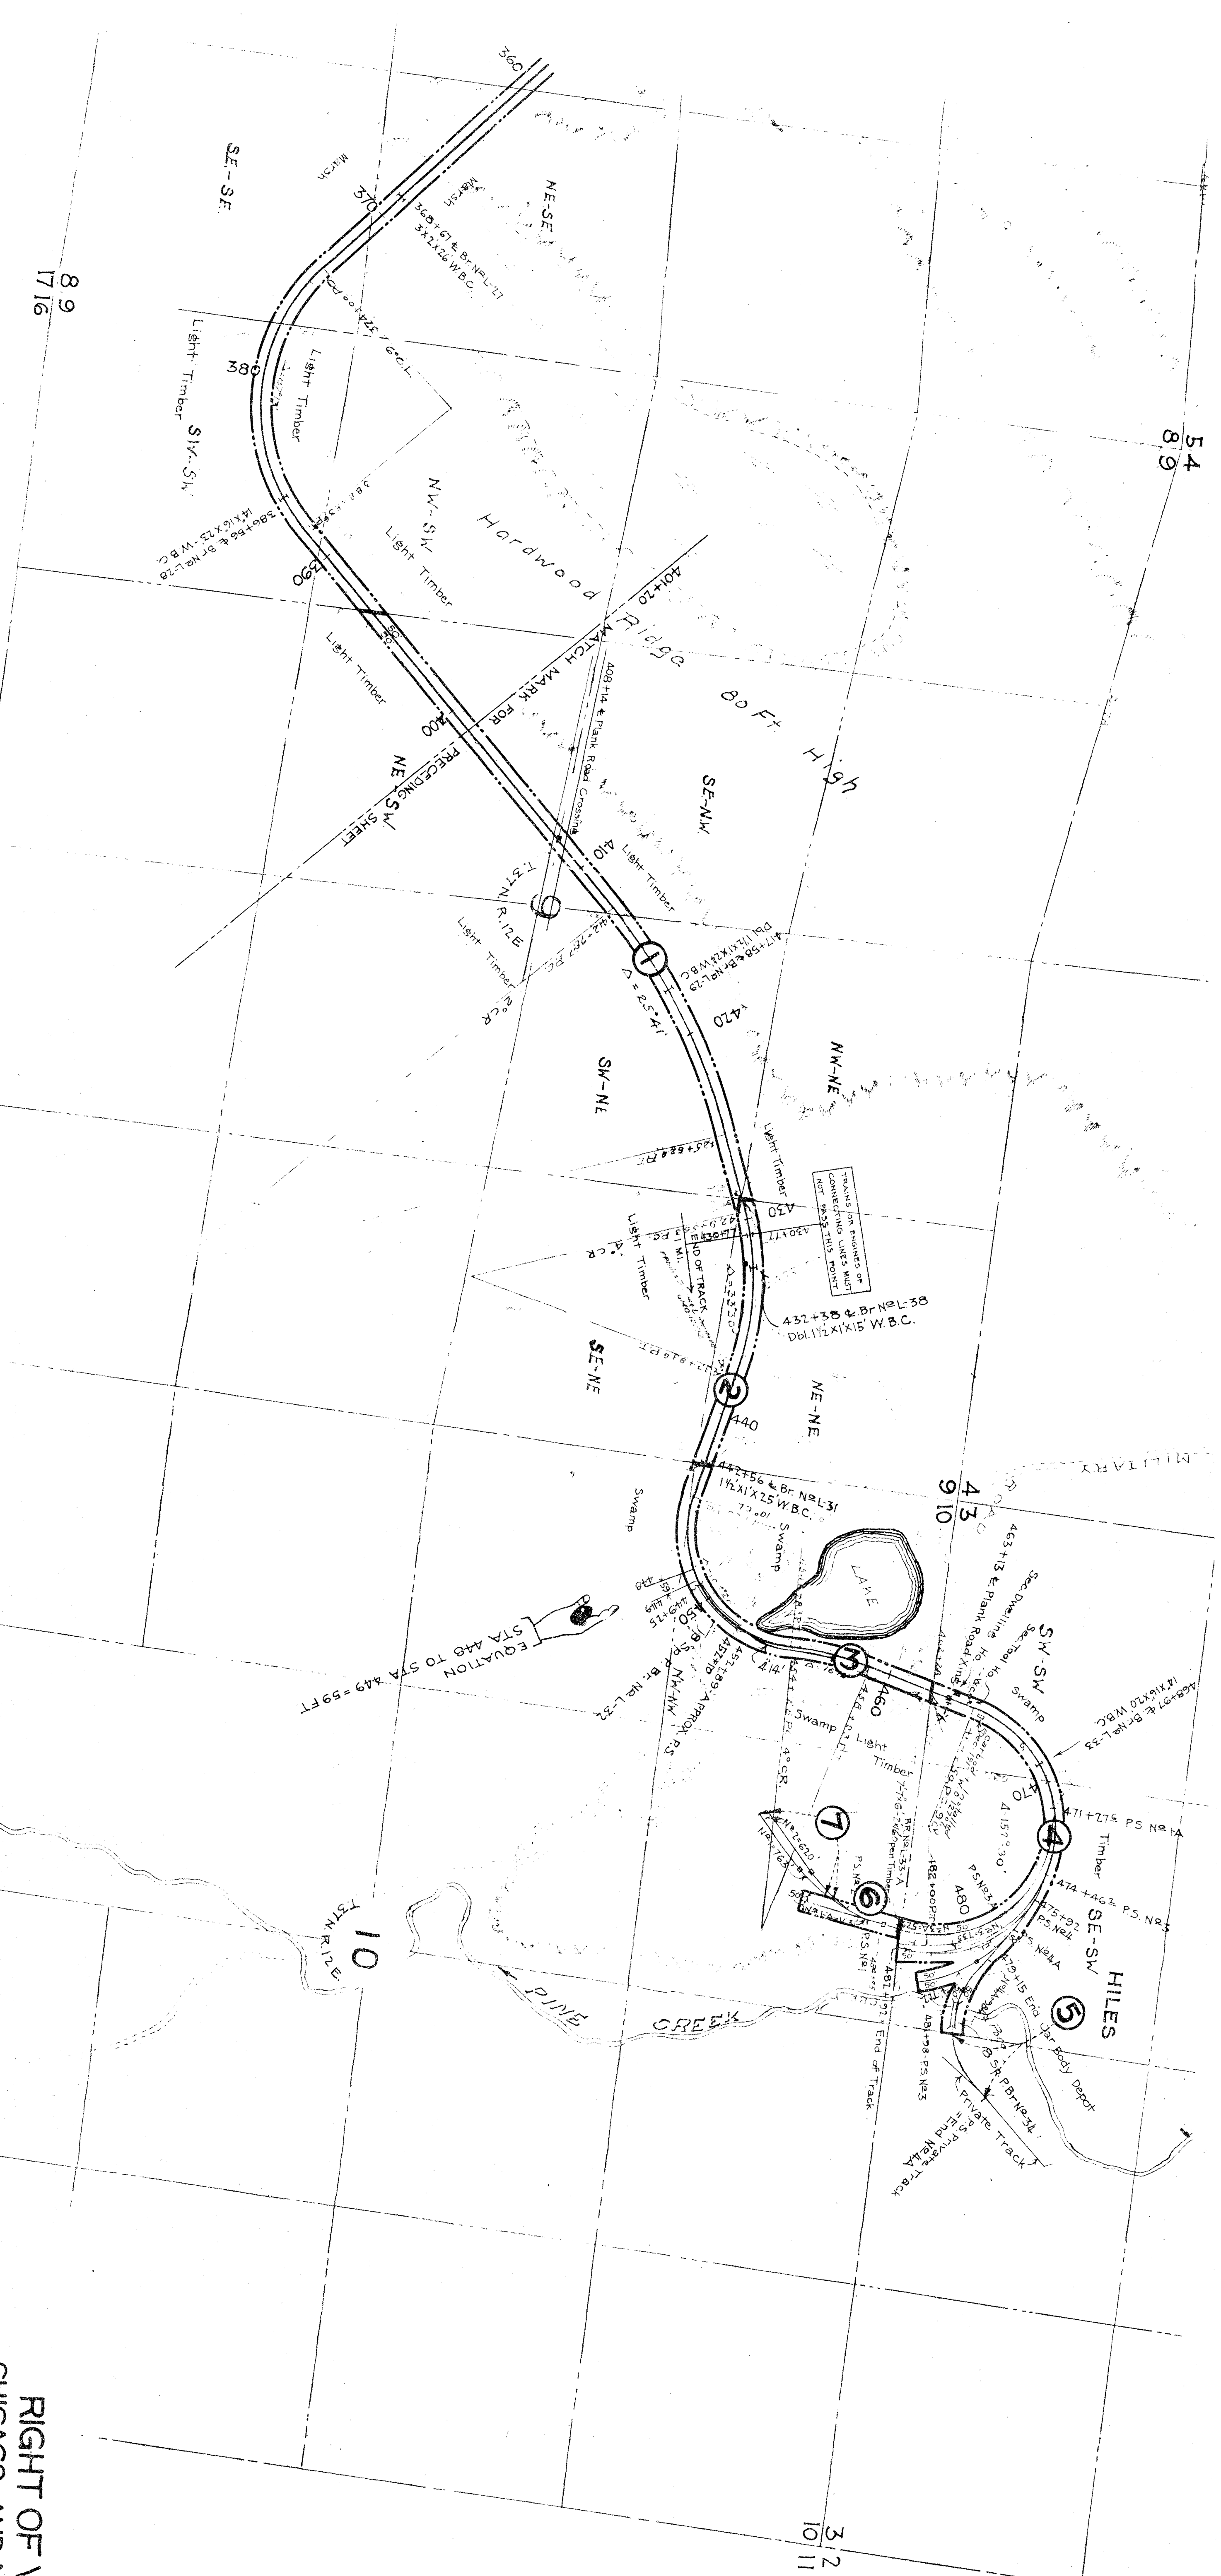

RIGHT OF WAY AND TRACK MAP
CHICAGO AND NORTH-WESTERN RAILWAY
OPERATED BY THE
C. & N. W. RY. CO.
ASHLAND DIVISION
HILES JCT., WIS. TO HILES MILL, WIS.

SCALE 1 IN. = 400 FT.
STA. 401+70 TO STA. 481+92
OFFICE OF CHIEF ENGINEER
CHICAGO, ILL. JUNE 30, 1917.

Sheet No. 3 of 3, C. & N. W. Ry.
from Survey Station 401+70
to Survey Station 481+92
S. P. O. S. *Seawick*
Valuation Engineer

PLATTED - R.A.W. NOV. 21, 1916
TRACED - W.C.D. NOV. 25, 1916
CHECKED - R.A.W. DEC. 4, 1916