


NO.	DATE	RECORD	REMARKS	A.R.E.

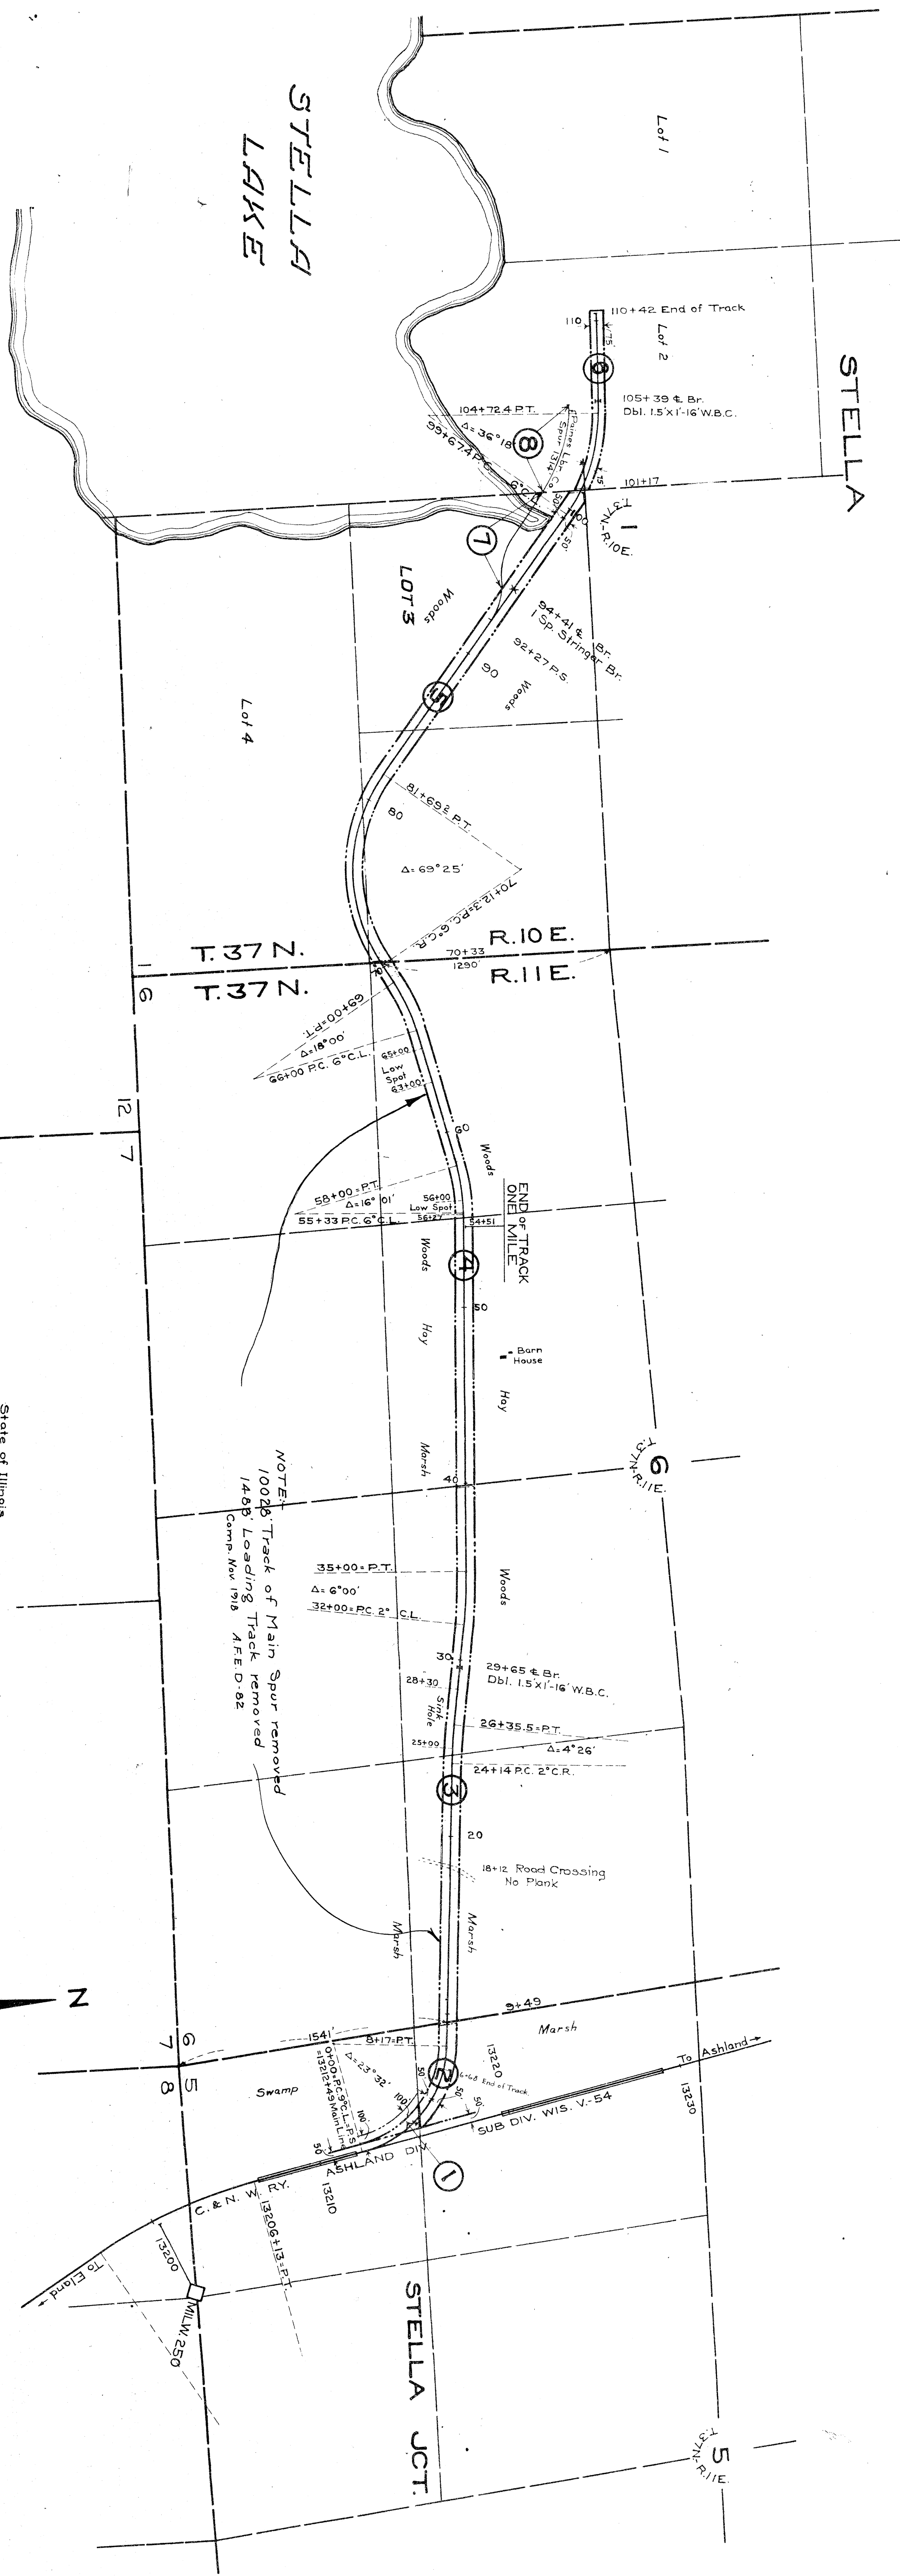

State of Illinois
County of Cook
I, the undersigned, officer of the Chicago and North Western Railway do hereby certify that this is a correct map in a series of primary sheets and no supplemental sheets of said railway from survey station 0200 to survey station 110+42. Ashland Division, State of Wisconsin prepared from the records of said company.

Correct
Valuation Engineer

Subscribed and sworn to before me, this 12th day of April, 1912.
Notary Public in and for the
County of Cook
State of Illinois

My commission expires May 11, 1912.

RIGHT OF WAY AND TRACK MAP
CHICAGO AND NORTH-WESTERN RAILWAY
OPERATED BY THE
C. & N. W. RY. CO.
ASHLAND DIVISION
ELAND, WIS. TO STATE LINE, MICH.
STA. 0+00 TO STA. 110+42
SCALE: 1 IN. = 400 FT.
JUNE 30, 1917.
OFFICE OF CHIEF ENGINEER
CHICAGO, ILL.