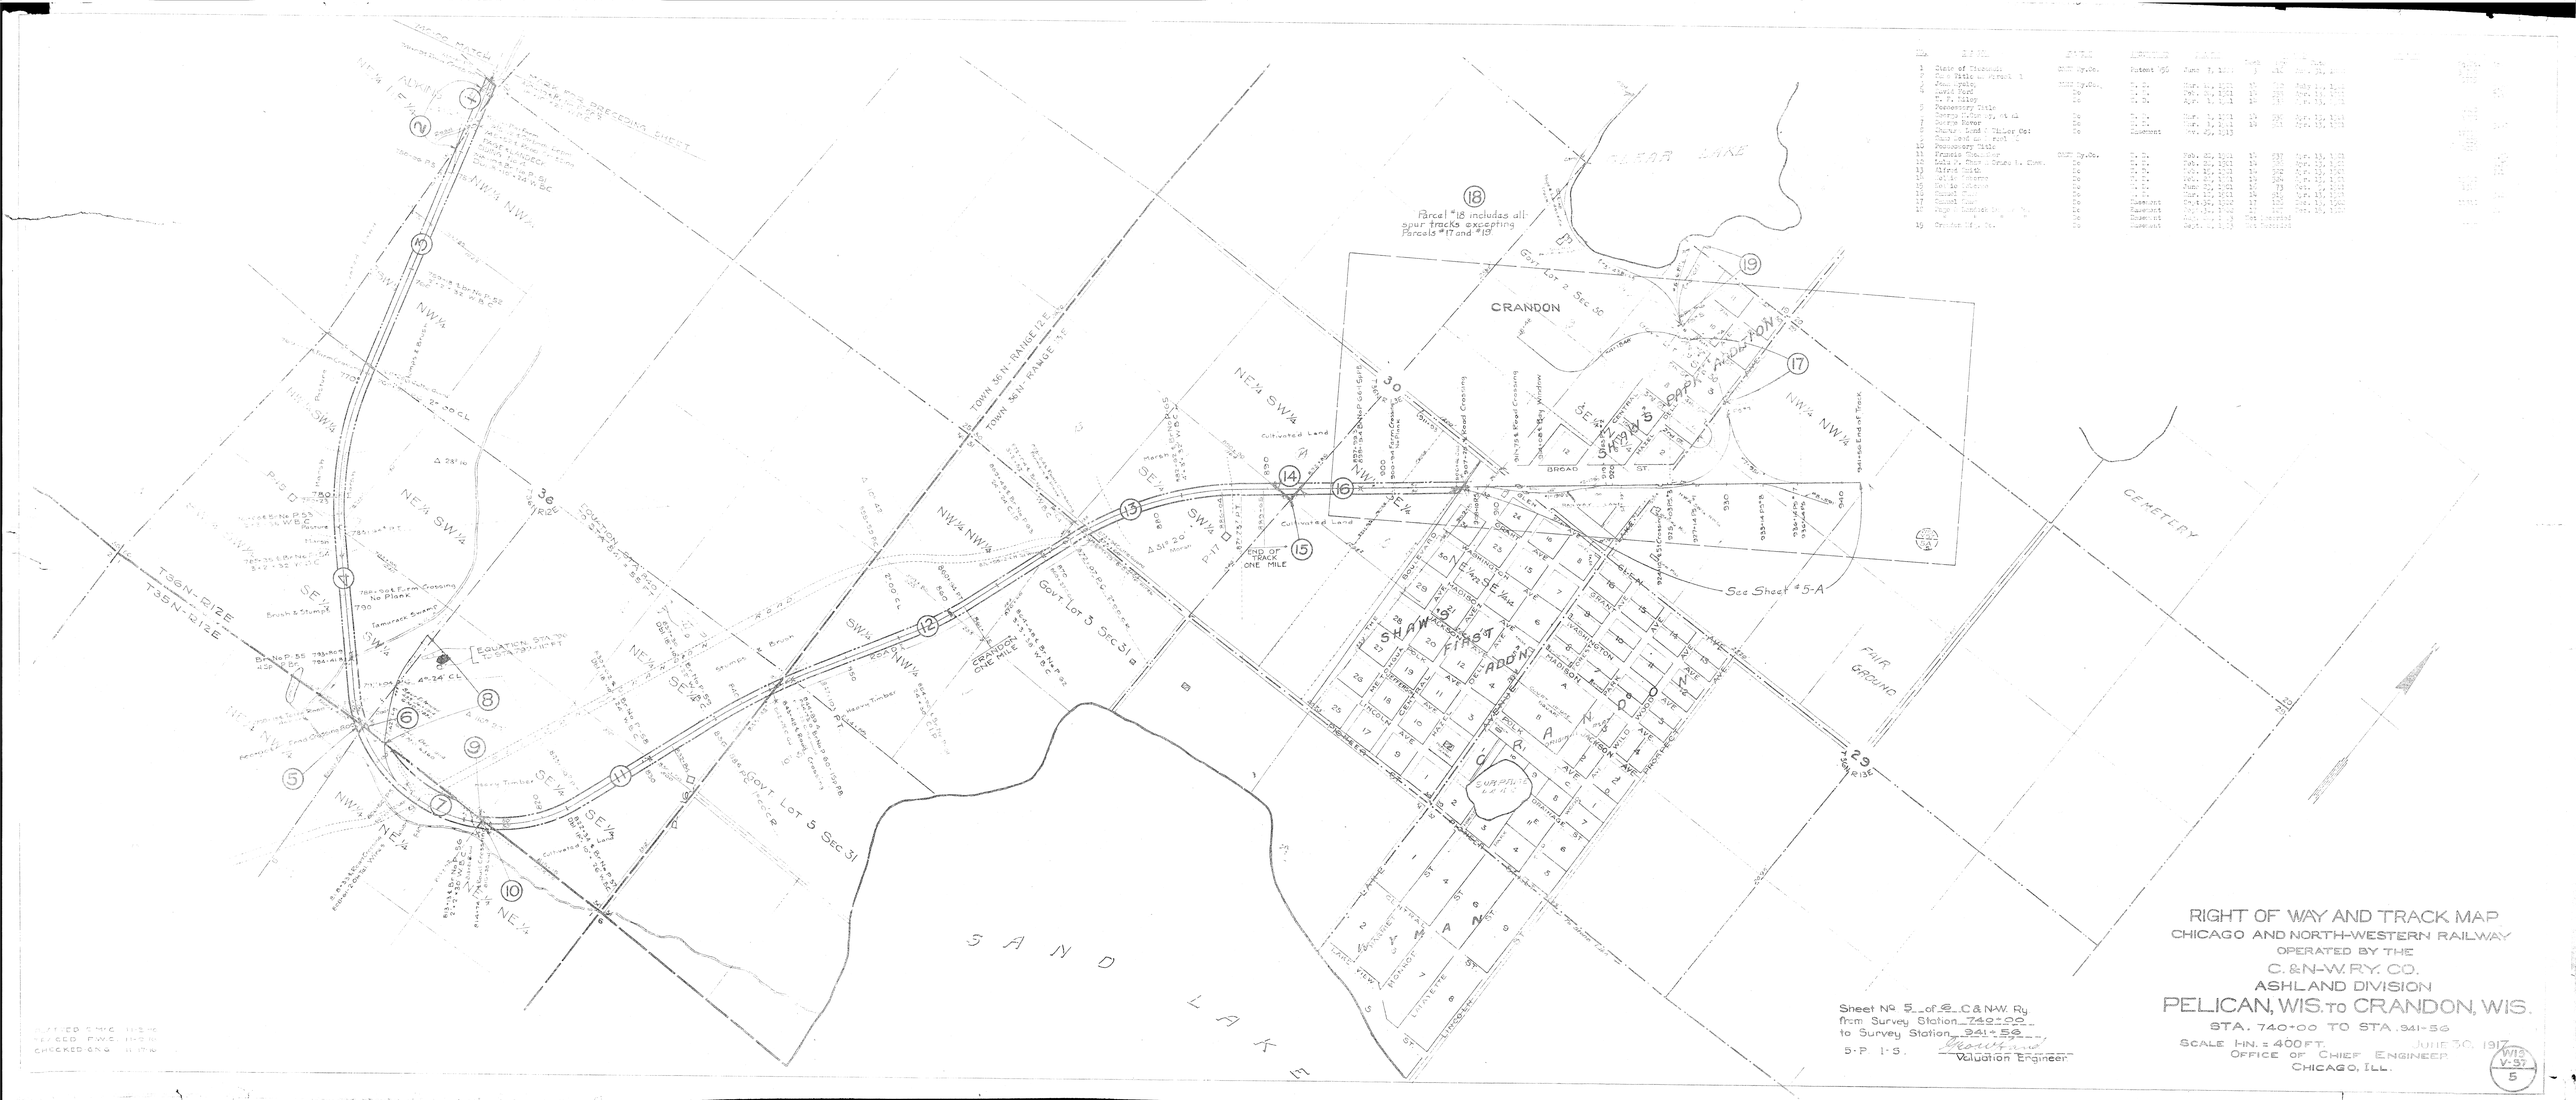

Connects with preceding sheet
T36N-R12E
T35N-R12E
TOWN 36 N-RANGE 12 E
TOWN 36 N-RANGE 13 E
NW¼ NW¼
NE¼ SW¼
SE¼ SW¼
SW¼ NW¼
SE¼ SE¼
NE¼ NE¼
Equation Sta.
Govt Lot 5 Sec 31
Govt Lot 3 Sec 31
Govt Lot 2 Sec 30
Crandon One Mile
End of Track One Mile
Cultivated Land
Heavy Timber
Tamarack Swamp
Brush & Stumps
Marsh
Pasture
No Plank
Farm Crossing
Road Crossing
Bay Window
End of Track
Parcel #18 includes all spur tracks excepting Parcels #17 and #19
See Sheet #5-A
CRANDON
SHAW'S FIRST ADDN
SHAW'S PARK ADDITION
CRANDON
LAKE VIEW
SAND LAKE
CLEAR LAKE
SURPRISE LAKE
FAIR GROUND
CEMETERY
BOULEVARD
CENTRAL AVE
MADISON AVE
WASHINGTON AVE
LINCOLN AVE
HAZEL AVE
POLK AVE
WILD WOOD AVE
PROSPECT AVE
DRAINAGE ST
GRANT AVE
GLEN AVE
BROAD
MONROE ST
LAFAYETTE ST
LAKE ST
29
30
36
① ② ③ ④ ⑤ ⑥ ⑦ ⑧ ⑨ ⑩ ⑪ ⑫ ⑬ ⑭ ⑮ ⑯ ⑰ ⑱ ⑲

No.	[illegible]	[illegible]	[illegible]	[illegible]	Book	Page	Date	[illegible]
1	State of Wisconsin	C&NW Ry.Co.	Patent 456	June 7, [illegible]	3	[illegible]	Apr. 31, [illegible]	[illegible]
2	Same Title as Parcel 1							[illegible]
3	John Hyslop	C&NW Ry.Co.	W. D.	Mar. 10, 1901	14	[illegible]	July 1[illegible], 1901	[illegible]
4	David Ford	Do	W. D.	Feb. 20, 1901	14	533	Apr. 13, 1901	[illegible]
	E. F. Riley	Do	W. D.	Apr. 1, 1901	14	[illegible]	Apr. 13, 1901	
5	Possessory Title							[illegible]
6	George H.Con[illegible], et al	Do	W. D.	Mar. 1, 1901	14	530	Apr. 13, 1901	[illegible]
7	George Rover	Do	W. D.	Mar. 1, 1901	14	521	Apr. 13, 1901	[illegible]
8	Chavan[illegible] Land & Timber Co:	Do	Easement	Nov. 29, 1913				[illegible]
9	Same Deed as Parcel #6							[illegible]
10	Possessory Title							[illegible]
11	Francis Shoemaker	C&NW Ry.Co.	W. D.	Feb. 20, 1901	14	537	Apr. 13, 1901	[illegible]
12	Lulu P. Shaw & Grace L. Shaw.	Do	W. D.	Feb. 20, 1901	14	520	Apr. 13, 1901	[illegible]
13	Alfred Smith	Do	W. D.	Feb. 15, 1901	14	522	Apr. 13, 1901	7.2
14	Nellie Osborne	Do	W. D.	Feb. 20, 1901	14	524	Apr. 13, 1901	[illegible]
15	Nellie Osborne	Do	W. D.	June 20, 1901	16	73	Oct. 9, 1901	[illegible]
16	Samuel Shaw	Do	W. D.	Mar. 12, 1901	14	519	Apr. 13, 1901	[illegible]
17	Samuel Shaw	Do	Easement	Sept.30, 1902	17	126	Dec. 15, 1902	[illegible]
18	Page & Landeck Lumber Co.	Do	Easement	Sept.30, 1902	17	127	Dec. 15, 1902	[illegible]
	" " " "	Do	Easement	Aug. [illegible], 1[illegible]3	Not Recorded			
19	Crandon Mfg. Co.	Do	Easement	Sept. [illegible], 1903	Not Recorded			[illegible]

PLATTED C.M'C 11-3-16
TRACED F.W.C. 11-8-16
CHECKED G.N.G 11-17-16

Sheet Nº 5 of 6 C&N-W. Ry
from Survey Station 740+00
to Survey Station 941+56
5-P. 1-5.
G. Row Land
Valuation Engineer

RIGHT OF WAY AND TRACK MAP
CHICAGO AND NORTH-WESTERN RAILWAY
OPERATED BY THE
C. & N-W. RY. CO.
ASHLAND DIVISION
PELICAN, WIS. TO CRANDON, WIS.
STA. 740+00 TO STA. 941+56
SCALE 1 IN. = 400 FT. June 30, 1917
OFFICE OF CHIEF ENGINEER
CHICAGO, ILL.

WIS
V-37
5