No.	GRANTOR	GRANTEE	INSTRUMENT	DATE	Book	Page	RECORDED	REMARKS	AREA Sq.Ft.	AREA Ac.
1	United States	Military Ry.Co.	Map Filed	Feb. 8, 1868			U.S.Land Office, Washington, D.C.			60.71
2	Adam Schliesmann	Do	T. D.	Sept.15, 1885	2	348	Oct. 1, 1896			3.74
3	William Luby	Do	W. D.	June 16, 1879	3	101	June 26, 1879			5.13
4	A. L. Cary	Do	C.D.	Oct. 14, 1867	2	366	Oct. 17, 1867			1.75
5	Same Deed as Parcel 13									1.49
6	Northwestern Pine Land Co.	Do	T. D.	Jan. 27, 1890	3	331	Feb. 6, 1890			3.65
7	A. L. Cary	Do	C.D.	Oct. 10, 1867	2	903	Oct. 30, 1867			9.19
8	Same Deed as Parcel 14									1.40

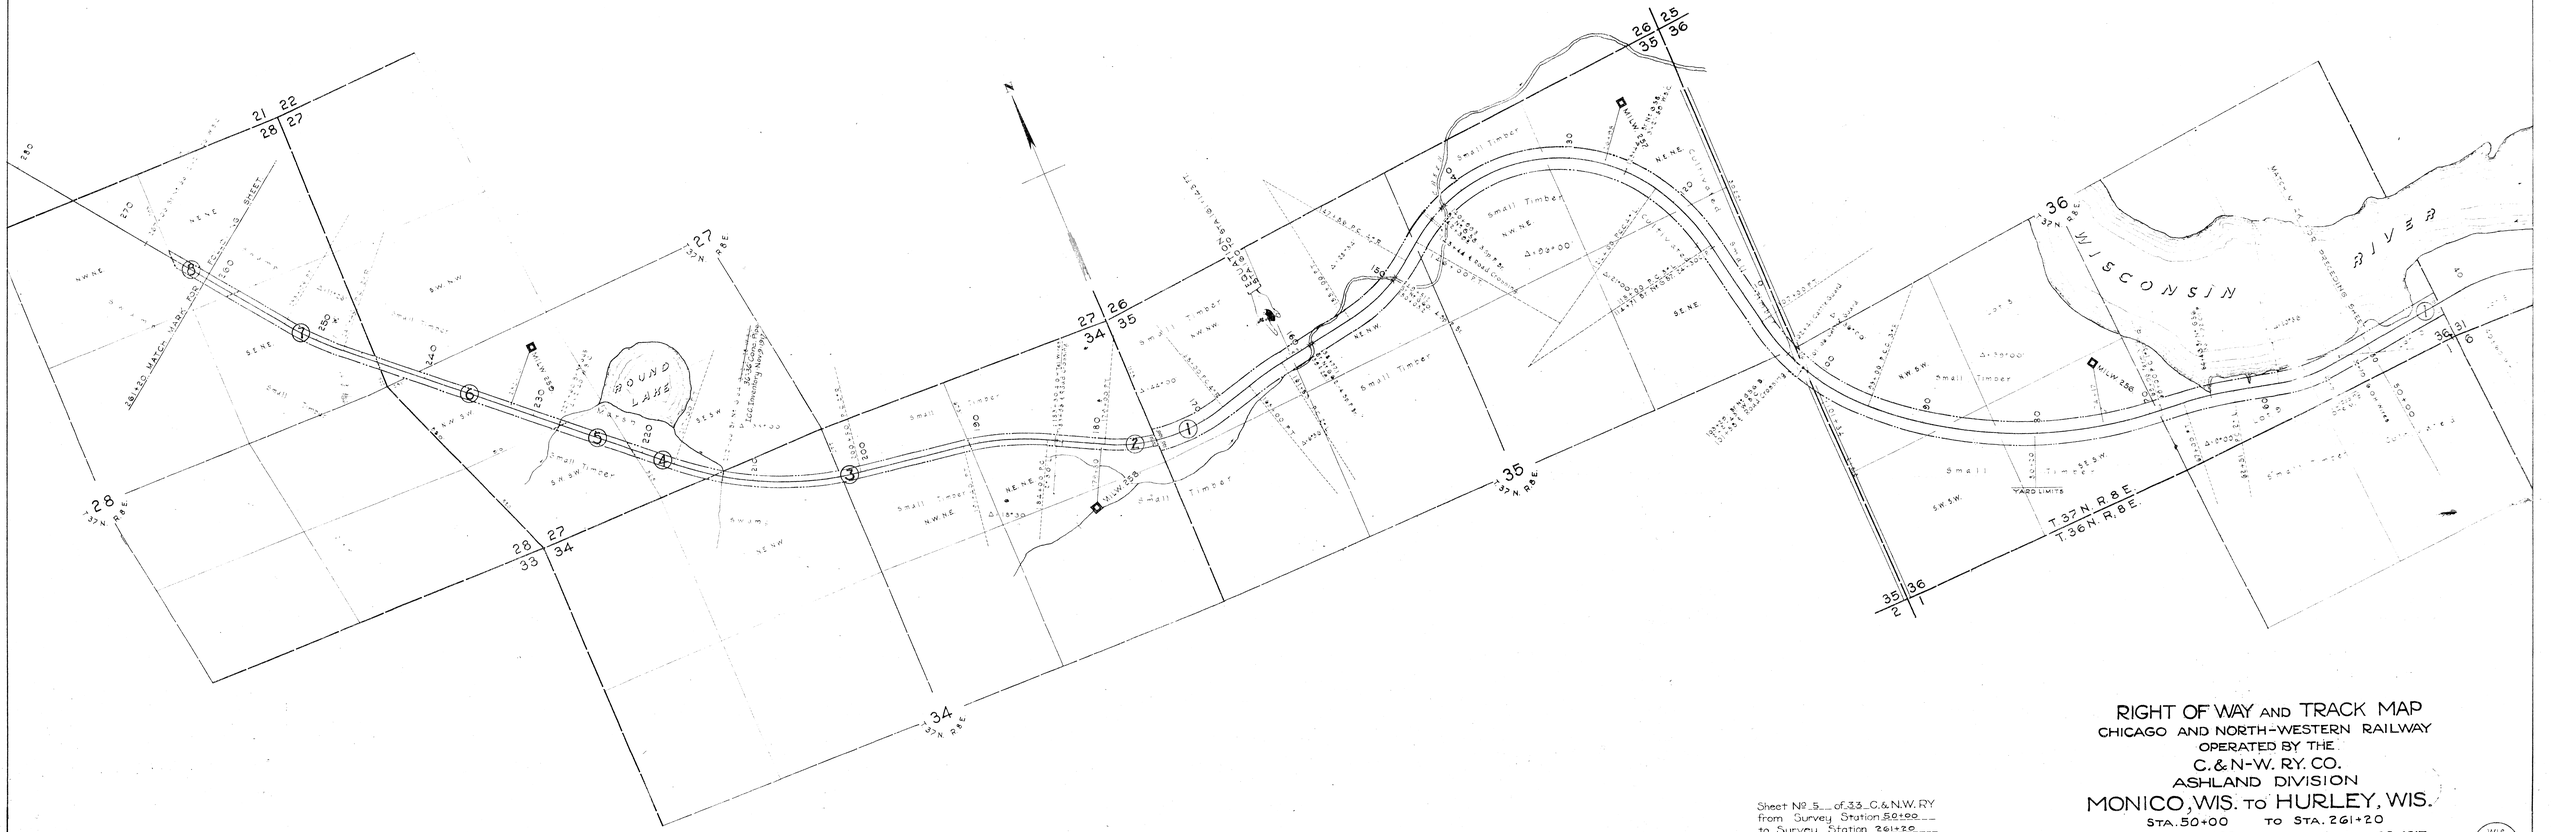

Plotted by R.F.S. Oct 6 1916
Traced by S.N.G Nov. 1 1916
Checked by R.F.S. Nov. 10 1916

Sheet No. 5 of 33 C.&N.W. RY
from Survey Station 50+00
to Survey Station 261+20
23-P. 10-S.
Valuation Engineer

RIGHT OF WAY AND TRACK MAP
CHICAGO AND NORTH-WESTERN RAILWAY
OPERATED BY THE
C.&N-W. RY. CO.
ASHLAND DIVISION
MONICO, WIS. TO HURLEY, WIS.
STA. 50+00 TO STA. 261+20
SCALE 1-IN. = 400 FT. JUNE 30, 1917.
OFFICE OF CHIEF ENGINEER
CHICAGO, ILL.

WIS. V-60
5