



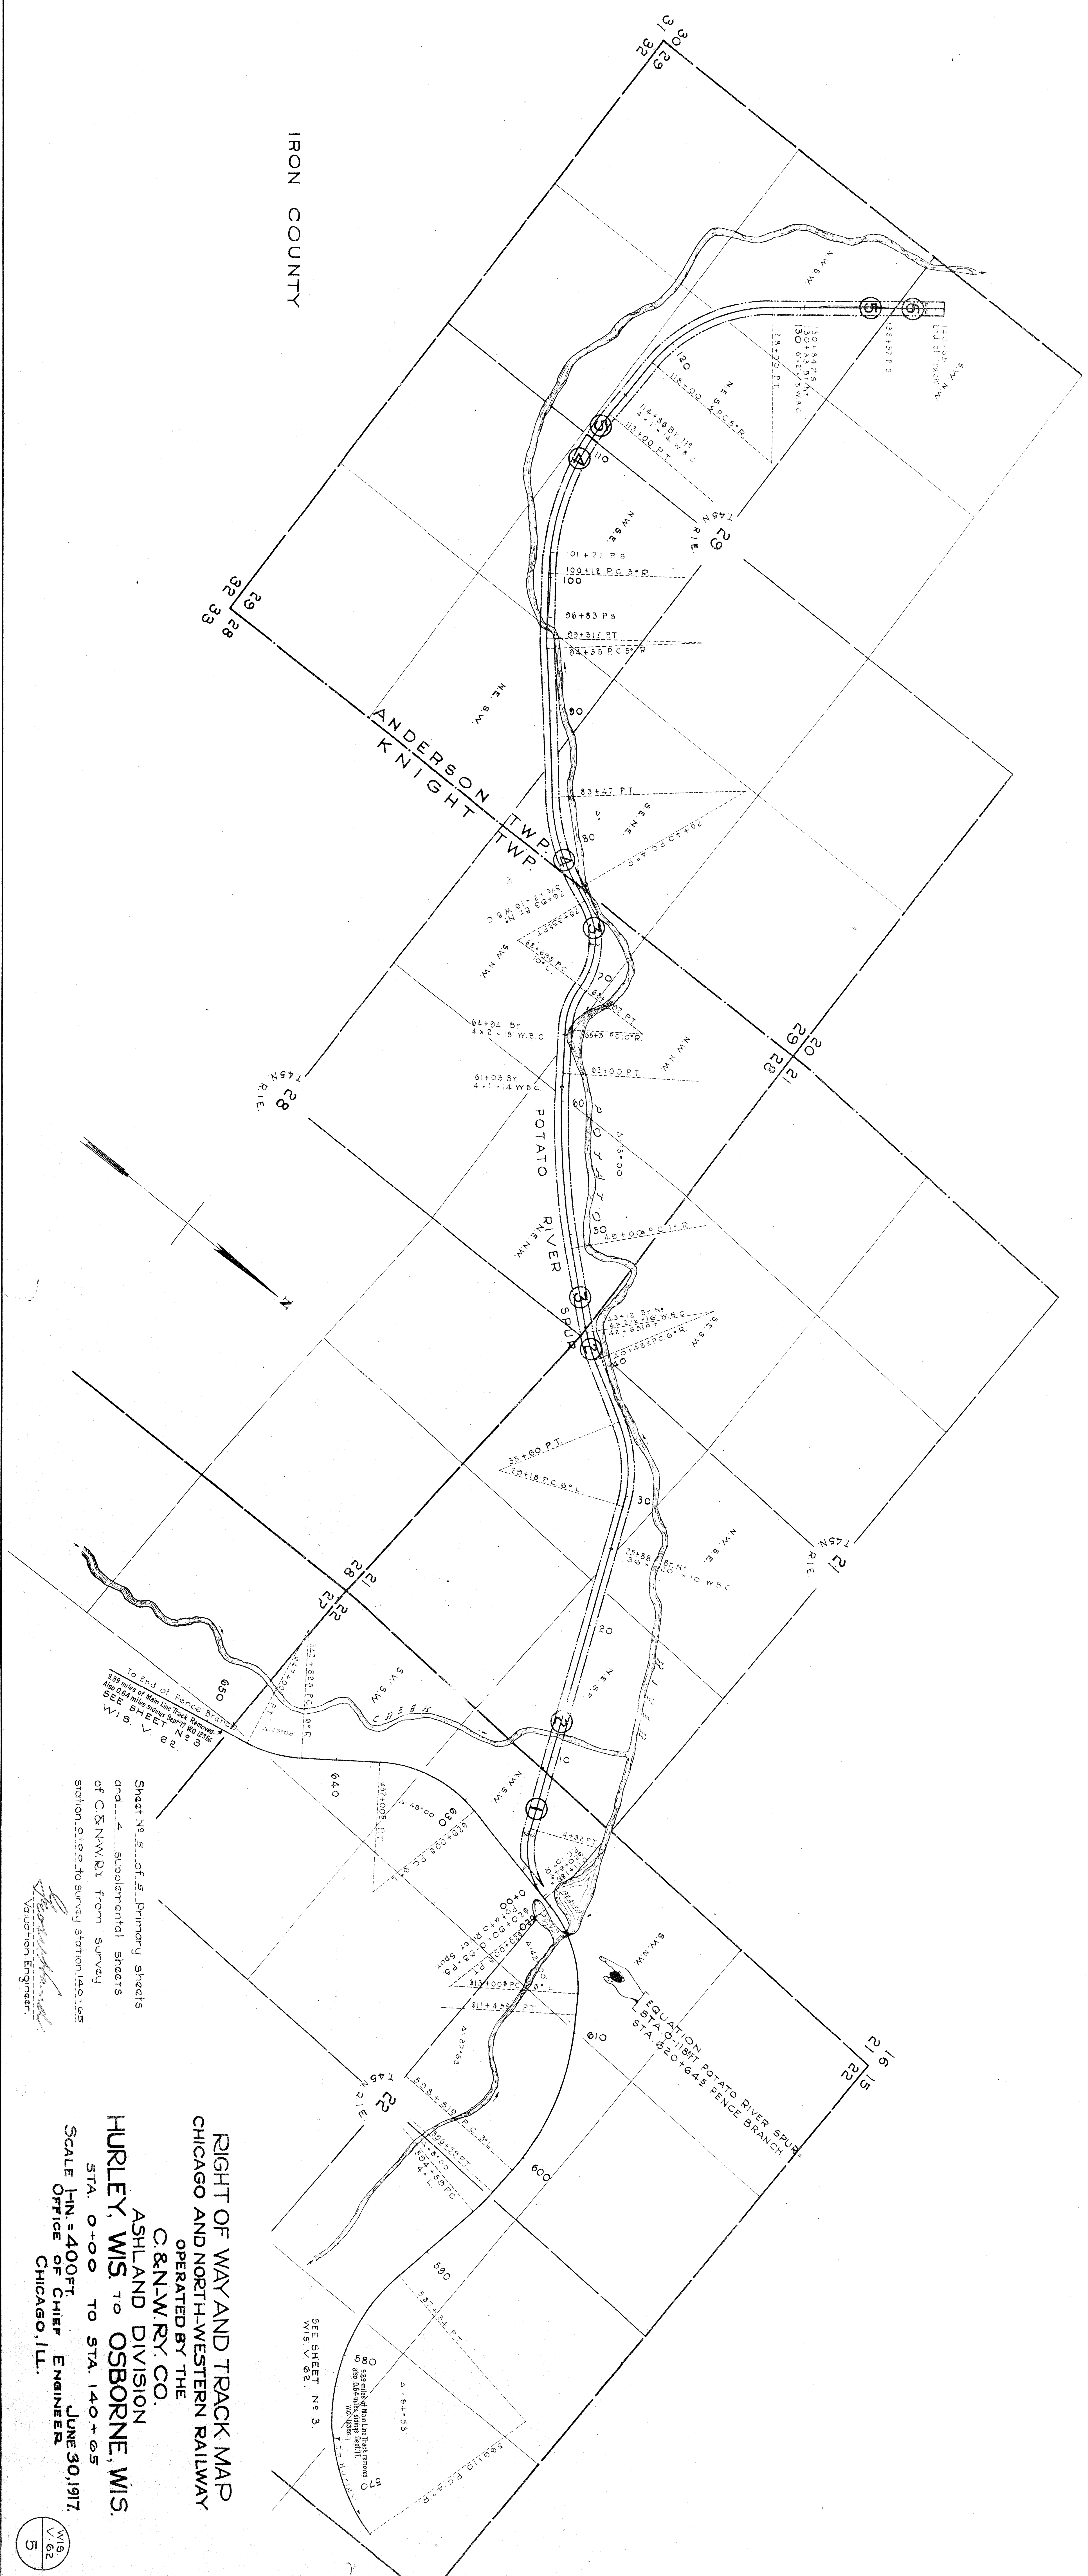

RIGHT OF WAY AND TRACK MAP
CHICAGO AND NORTH-WESTERN RAILWAY
OPERATED BY THE
C. & N. W. RY. CO.
ASHLAND DIVISION
HURLEY, WIS. TO OSBORNE, WIS.
STA. 0+00 TO STA. 140+65
SCALE 1 IN. = 400 FT.
JUNE 30, 1917.
OFFICE OF CHIEF ENGINEER
CHICAGO, ILL.