


NO.	REMARKS	DATE	BY	RECORD	REMARKS	DATE
1	Passenger title	Apr. 21, 1886	21	113	Apr. 21, 1886	1.56
2	A. L. City	May 2, 1886	22	114	May 2, 1886	1.56
3	National Central R.R. Co. at 21	July 23, 1892	19	57	July 23, 1892	1.09
4	President Abbott	Aug. 1, 1892	51	206	Aug. 1, 1892	1.09
5	Sum. Dist. as Parcel #3	Sept. 17, 1912	Not Recorded		Sept. 17, 1912	1.77
6	Sum. Dist. as Parcel #2					

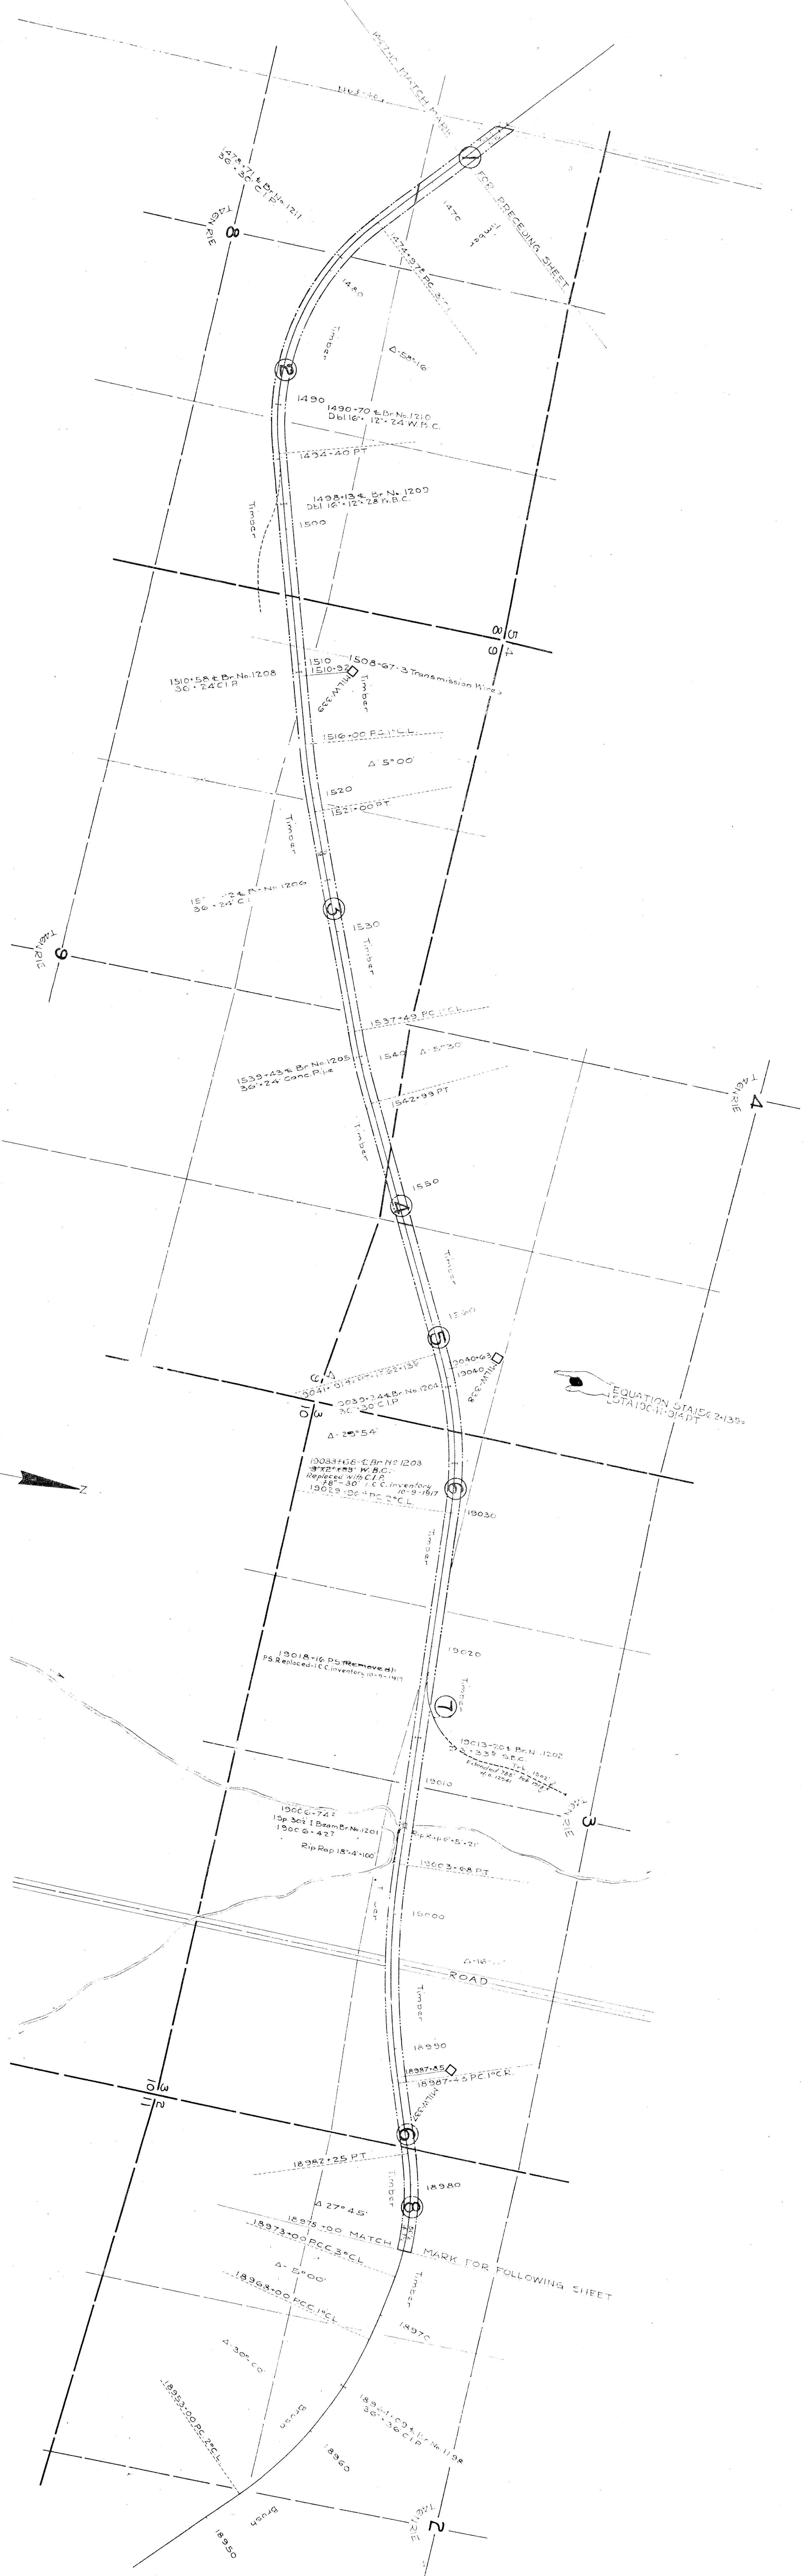

RIGHT OF WAY AND TRACK MAP
CHICAGO AND NORTH-WESTERN RAILWAY
OPERATED BY THE
C. & N. W. RY. CO.
ASHLAND DIVISION
ASHLAND, WIS. TO HURLEY, WIS.
STA. 1467+10 TO STA. 18975+00

Sheet No. 8 of 11 Primary sheets
and 11 Supplemental sheets
of C. & N. W. RY. from survey
Station 1467+10 to survey station 18975+00

SCALE 1"=400 FT.
JUNE 30, 1917
OFFICE OF CHIEF ENGINEER
CHICAGO, ILL.