


NO.	SECTION	DATE	BOOK	PAGE	REMARKS	DATE	BY	REMARKS

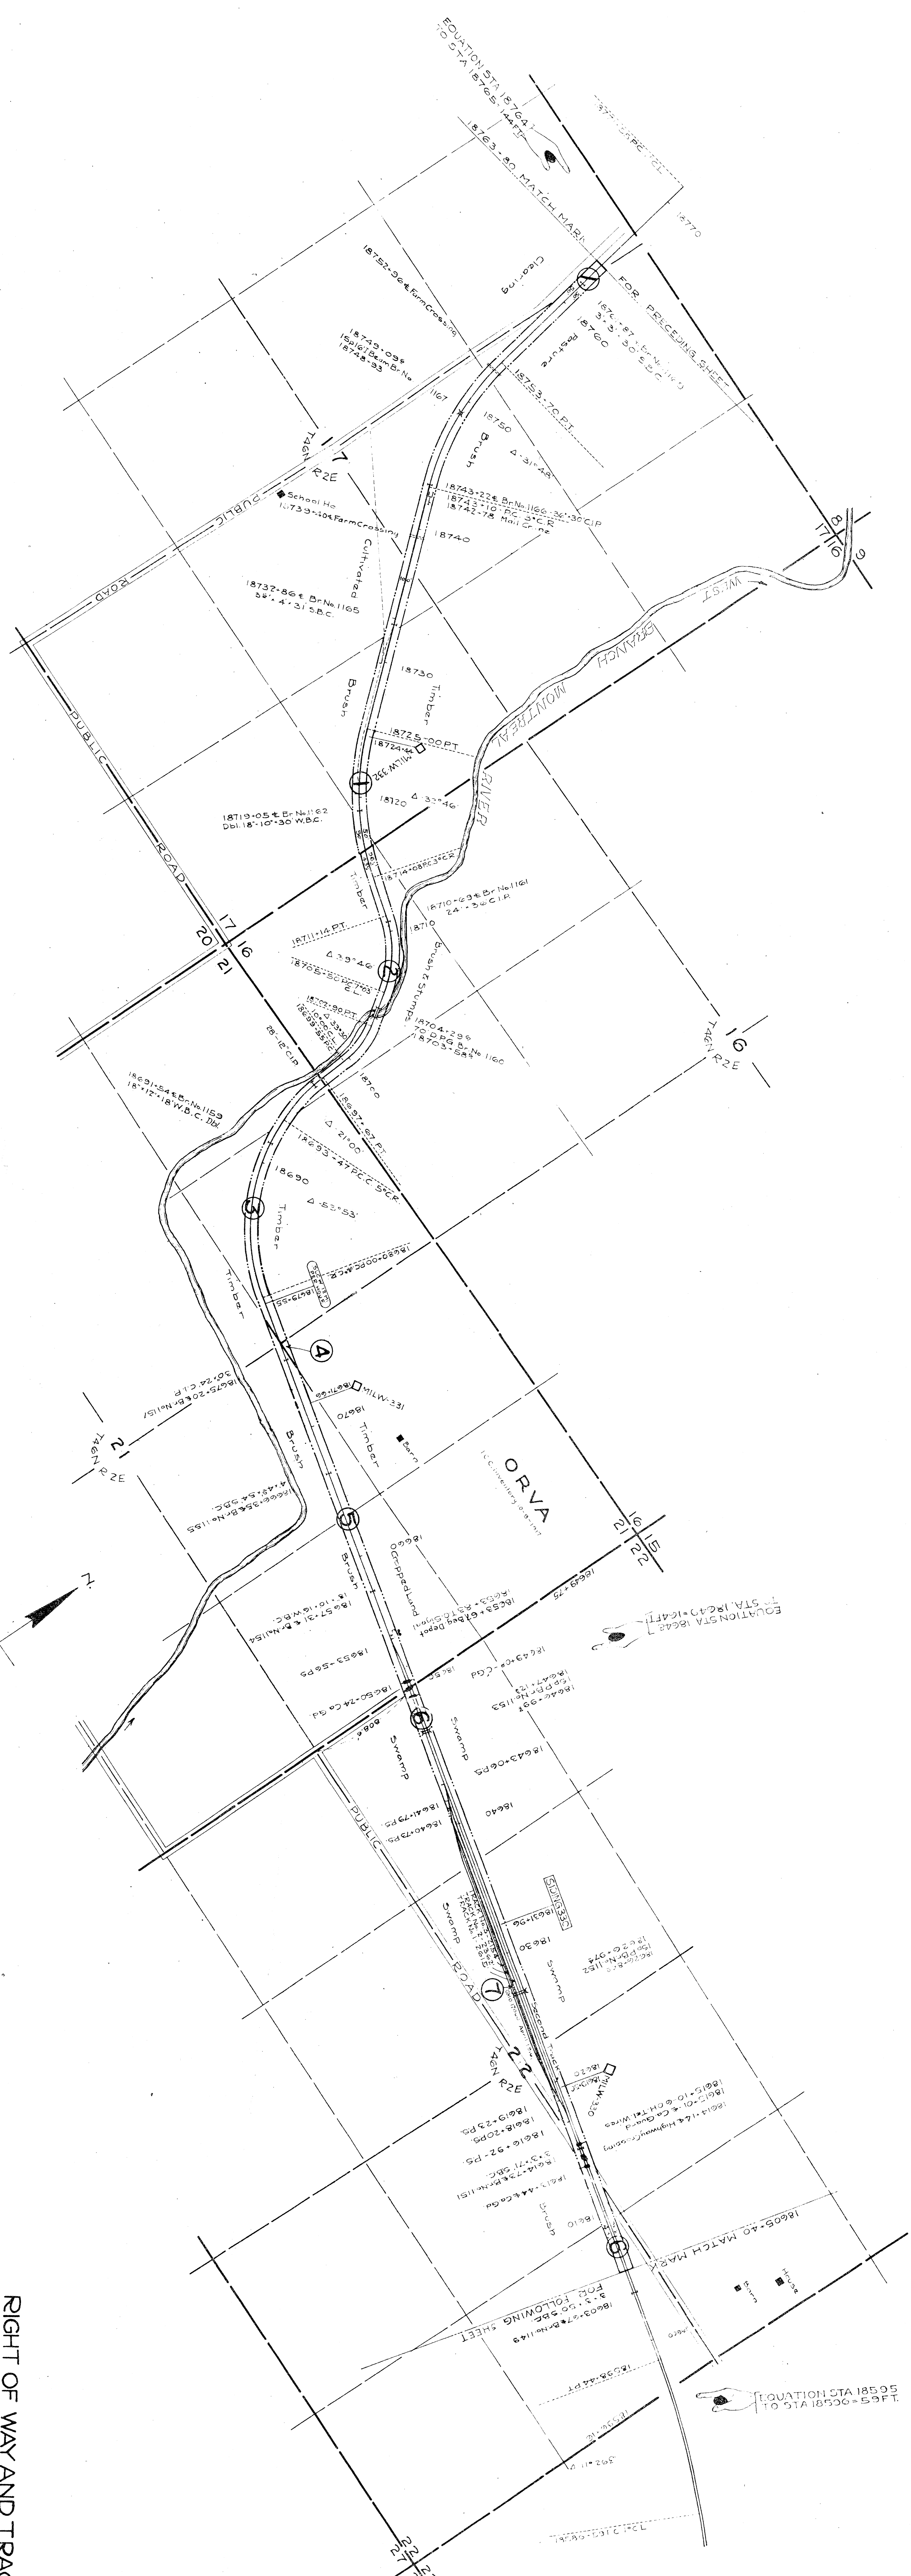

RIGHT OF WAY AND TRACK MAP
CHICAGO AND NORTH-WESTERN RAILWAY
OPERATED BY THE
C. & N. W. RY. CO.
ASHLAND DIVISION
ASHLAND, WIS. TO HURLEY, WIS.
SCALE 1-IN. = 400 FT.
OFFICE OF CHIEF ENGINEER
CHICAGO, ILL.

Sheet No. 10 of 11. Primary sheets
and supplemental sheets
of C. & N. W. RY. from survey
J. H. Taylor
Valuation Engineer

PLATTED C.V.B. NOV 28, 1916
TRACED F.W.C. DEC 2, 1916
CHECKED C.V.B. JAN 10, 1917

