No.	GRANTOR	CHAPTER	INSTRUMENT	DATE	RECORDED Book	Page	Date	AREA Acres	Sq. Feet	REMARKS
1	Mich. Goetz	A. & W. Ry.	W. D.	Nov. 11,1893	Y	190	Dec. 28,1894		21,450	
2	Adolph Mallich	"	W. D.	Mar. 5,1894	Y	211	Apr. 2,1894	1	9,440	
2	Fred Siegmann	"	W. D.	Apr. 26,1894	1	593	Apr. 26,1894			
3	August Baumann	"	W. D.	June 7,1893	G	5	July 27,1894	2	93,100	
4	Carl Gaul	"	W. D.	Mar. 27,1894	G	551	Mar. 27,1894	1	12,910	
4	Release	"	Release	Oct. 19,1908	3	369	Nov. 14,1908			
4	Conn. Ghaz	"	W. D.	Mar. 9,1894	X	538	Mar. 13,1894	1	8,760	
5	John Oberber	"	Release	Oct. 19,1908	3	372	Nov. 14,1908			
5	Release	"	W. D.	Jan. 25,1904	2	554	Mar. 13,1894	4	330	
6	Otto Mintoff	"	Release	Oct. 19,1908	3	370	Nov. 14,1908			
7	Albert Praska	"	W. D.	June 21,1894	G	28	July 27,1894	1	26,440	
8	Julius Kath	"	W. D.	Mar. 7,1894	G	432	Oct. 20,1894	4	17,200	
9	Bank of Sturgeon Bay	"	W. D.	---,1894	11	103	Apr. 7,1894	7	10,796	
10	Carl Lachts	"	Contract	Jan. 27,1892	Y	410	Sept.22,1892		34,940	
10	Carl Lachts, heirs	"	Condemned	Lay Co.1914	Clerk of Court	Dkt.1-57				
11	James Keogh	"	W. D.	Feb. 27,1894	X	561	Mar. 13,1894	3	28,300	
12	Godfred Buschmann	"	W. D.	Feb. 26,1894	Y	169	Feb. 26,1894	4	27,360	
13	Louis Branning	"	W. D.	Feb. 23,1894	X	557	Mar. 13,1894		4,990	
14	William Branning	"	W. D.	Feb. 23,1894	X	540	Feb. 23,1894	4	60	
15	Christ. Leyer	"	W. D.	Mar. 9,1894	X	559	Mar. 13,1894		10,000	
16	Fred Knuth Sr.	"	W. D.	Feb. 26,1894	X	542	Feb. 26,1894	4	7,260	
17	John O'Hare	"	W. D.	Apr. 4,1894	G	30	July 27,1894	2	11,980	
18	Albertine Lindemayer	"	W. D.	Mar. 26,1894	1	589	Apr. 24,1894		10	
19	Lucy Hazborn	"	Condemned	Jan. 25,1894	Clerk of	Court	Dkt.1-58	3	9,350	
20	R. Clark	"	W. D.	Jan. 2,1894	X	543	Feb. 26,1894		21,200	

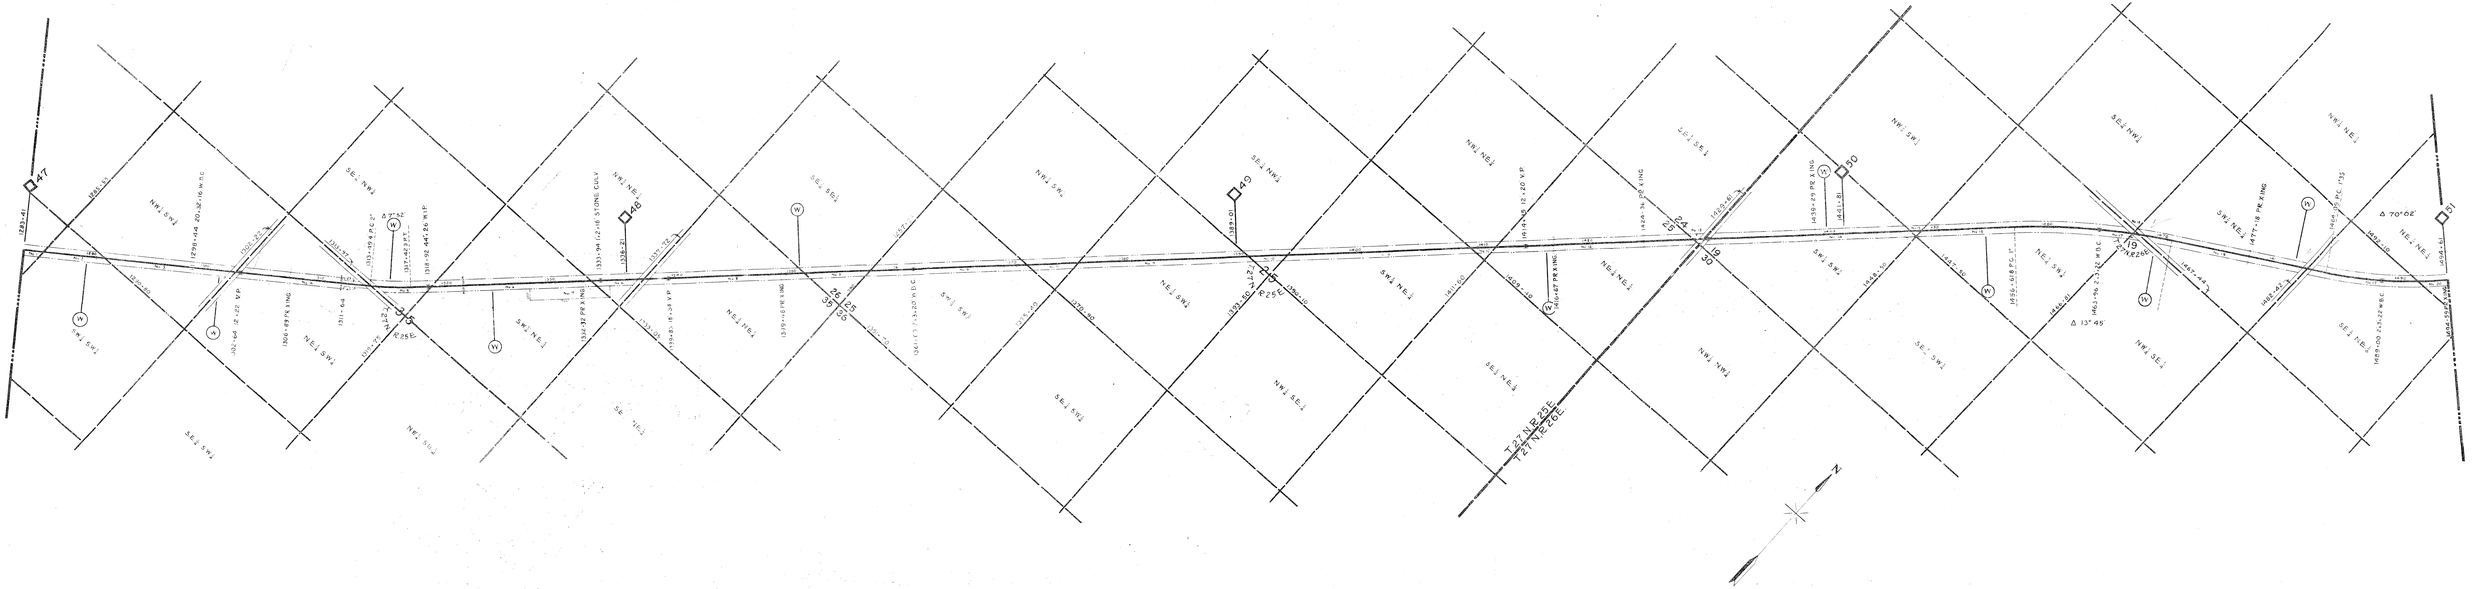

Filed Nov. 7 1916 at 12 o'clock M. in the Chester and Western Railway Company's
record of maps, from Station 1283-41 to Station 1494-61.

[signature] Chief Engineer

RIGHT OF WAY AND TRACK MAP

AHNAPEE AND WESTERN RAILWAY

OPERATED BY

AHNAPEE AND WESTERN RAILWAY

STATION 1283-41 TO STATION 1494-61

SCALE: 1 INCH 400 FEET

JUNE 30, 1916

OFFICE OF CHIEF ENGINEER
GREEN BAY, WIS.

V. 3 WS. 7