NUMBER	GRANTOR	GRANTEE	INSTRUMENT	DATE	RECORD			AREA		REMARKS
					Book	Page	Date	Acres	Sq. Feet.	
1	C. B. & Q. RR. Co.	W. G. B. Ry.	Agreement	Dec. 1,1910						
2	J. C. Olsen	"	W.D.	Sep.15,1907	122	173	May 8,1908	1	740	
2A			Preassesory						22,000	
3	T. Paulson	W. G. B. Ry.	W.D.	June 29,1907	120	534	May 8,1908	2	43,080	
4	Rendix Erricksen	"	W.D.	June 29,1907	120	535	May 8,1908		13,800	
5	S. Stephensen	"	W.D.	Aug. 2,1907	120	530	May 8,1908	1	32,940	
6	Nels Peterson	"	W.D.	June 29,1907	120	533	May 8,1908	1	38,440	
7	John A. Thorson	"	W.D.	July 2,1907	120	528	May 8,1908	2	32,680	
8	S. Torgerson	"	W.D.	June 29,1907	120	529	May 8,1908	3	18,120	
9	Kittel Evenson	"	W.D.	June 20,1907	120	510	May 8,1908	3	27,820	
10	A. P. Thorsen	"	Condemn.	July 19,1907	Clerk of Court			3	26,820	
10	S. P. Thorsen	"	W.D.	Mar. 7,1907	120	508	May 8,1908			
11	Hans. Olson	"	W.D.	June 24,1907	120	505	May 8,1908		28,600	
12	F. J. Anderson	"	W.D.	Aug. 1,1907	120	513	May 8,1908	1	37,040	
13	K. B. Knudtson	"	W.D.	July 3,1907	120	514	May 8,1908	4	34,260	
14	D. G. Danielson	"	W.D.	Aug. 14,1907	122	170	May 8,1908	5	17,150	
15	Julia M. Danielson	"	W.D.	July 2,1907	120	518	May 8,1908		1,060	
16	A. T. Rowe	"	W.D.	July 2,1907	120	511	May 8,1908	1	22,140	
17	Rison Hansen	"	W.D.	June 29,1907	120	527	May 8,1908	1	41,140	

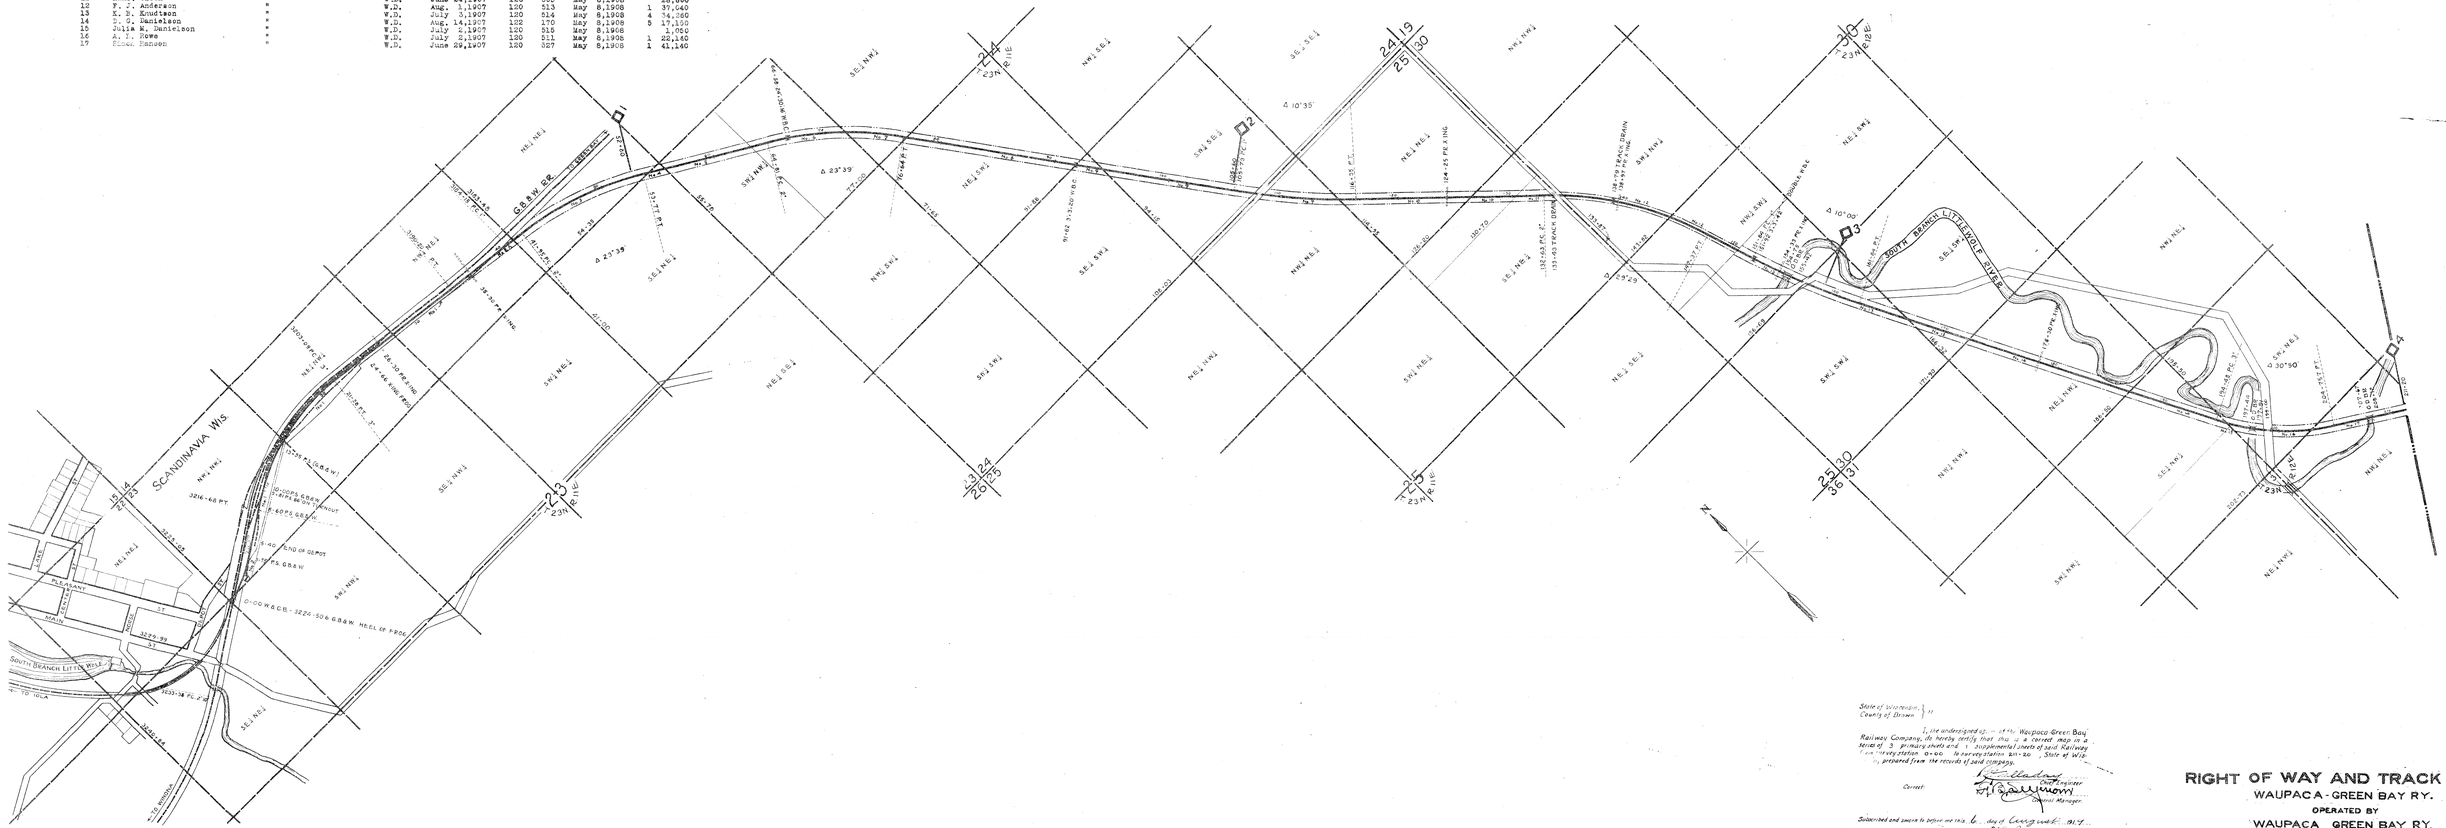

State of Wisconsin } ss
County of Brown }

I, the undersigned, Engineer of the Waupaca Green Bay Railway Company, do hereby certify that this is a correct map in a series of 3 primary sheets and 1 supplemental sheets of said Railway from survey station 0+00 to survey station 211+20 State of Wis. as prepared from the records of said company.

Correct:

Engineer
Colonel Manager

Subscribed and sworn to before me this 6 day of January 1914

Notary Public in and for the County of Brown, State of Wisconsin.

My commission expires January 1st, 1914.

RIGHT OF WAY AND TRACK MAP

WAUPACA-GREEN BAY RY.

OPERATED BY

WAUPACA GREEN BAY RY.

STATION 0+00 TO STATION 211+20

SCALE: 1 INCH = 400 FEET JUNE 30, 1913

OFFICE OF CHIEF ENGINEER

V I WIS. 1