NUMBER	GRANTOR	GRANTEE	INSTRUMENT	DATE	RECORD			AREA	
					Book	Page	Date	Acres	Sq. Feet
1	Thomas Kubie	T.Chase,Rec., G.B.& L.RR	R.W.D.	Jan. 19,1880	22	207	Mar. 31,1880		29,000
2	Mrs. J.E.Hutchins	"	"	Nov. 11,1879	22	47	Dec. 19,1879	1	1,940
2A	Karoline Schmit	"	"	Nov. 12,1879	22	44	Dec. 19,1879	2	12,880
2B	Miss C.Spaulding	"	"	Sept.10,1879	22	40	Dec. 19,1879	1	1,440
3	Geo.Burrows	"	4.C.D.	Feb. 2, 1880	22	211	Mar. 31,1880	3	23,090
4			Agr.Pos						680
5	Anna J. Listowski	"	R.W.D.	Apr. 26,1879	21	431	July 26,1879	7	25,130
6	Albert Gmuroth	"	"	Jan. 19,1880	22	208	Mar. 31,1880	5	39,200
7	Michael Ielen	"	"	Jan. 26,1880	22	210	Mar. 31,1880	3	19,310
8	Miran D.Merchant	"	"	Dec. 31,1880	22	601	Aut. 29,1881	6	10,140
9	James F. Alexander	"	"	Mar. 16,1880	22	202	Mar. 31,1880	2	39,230
10			Agr.Pos						5,850
11	Henry M. Pierce	G.B.& L.RR	4.C.D.	June 25,1877	20	415	Nov. 12,1878	9	3,760
11	Lewis A. Baker	"	"	Sept. 10,1873	21	452	July 31,1879		
12	Henry M. Pierce	"	4.C.D.	June 25,1877	20	416	Nov. 12,1878	3	3,600
13	Arcadia Mineral Springs Co.	T.Chase,Rec., G.B.& L.RR	R.W.D.	May 22,1880	22	274	June 1,1880	1	16,040
13	Geo. Hiles	"	R.W.D.	May 25,1880	"	208	June 1,1880		

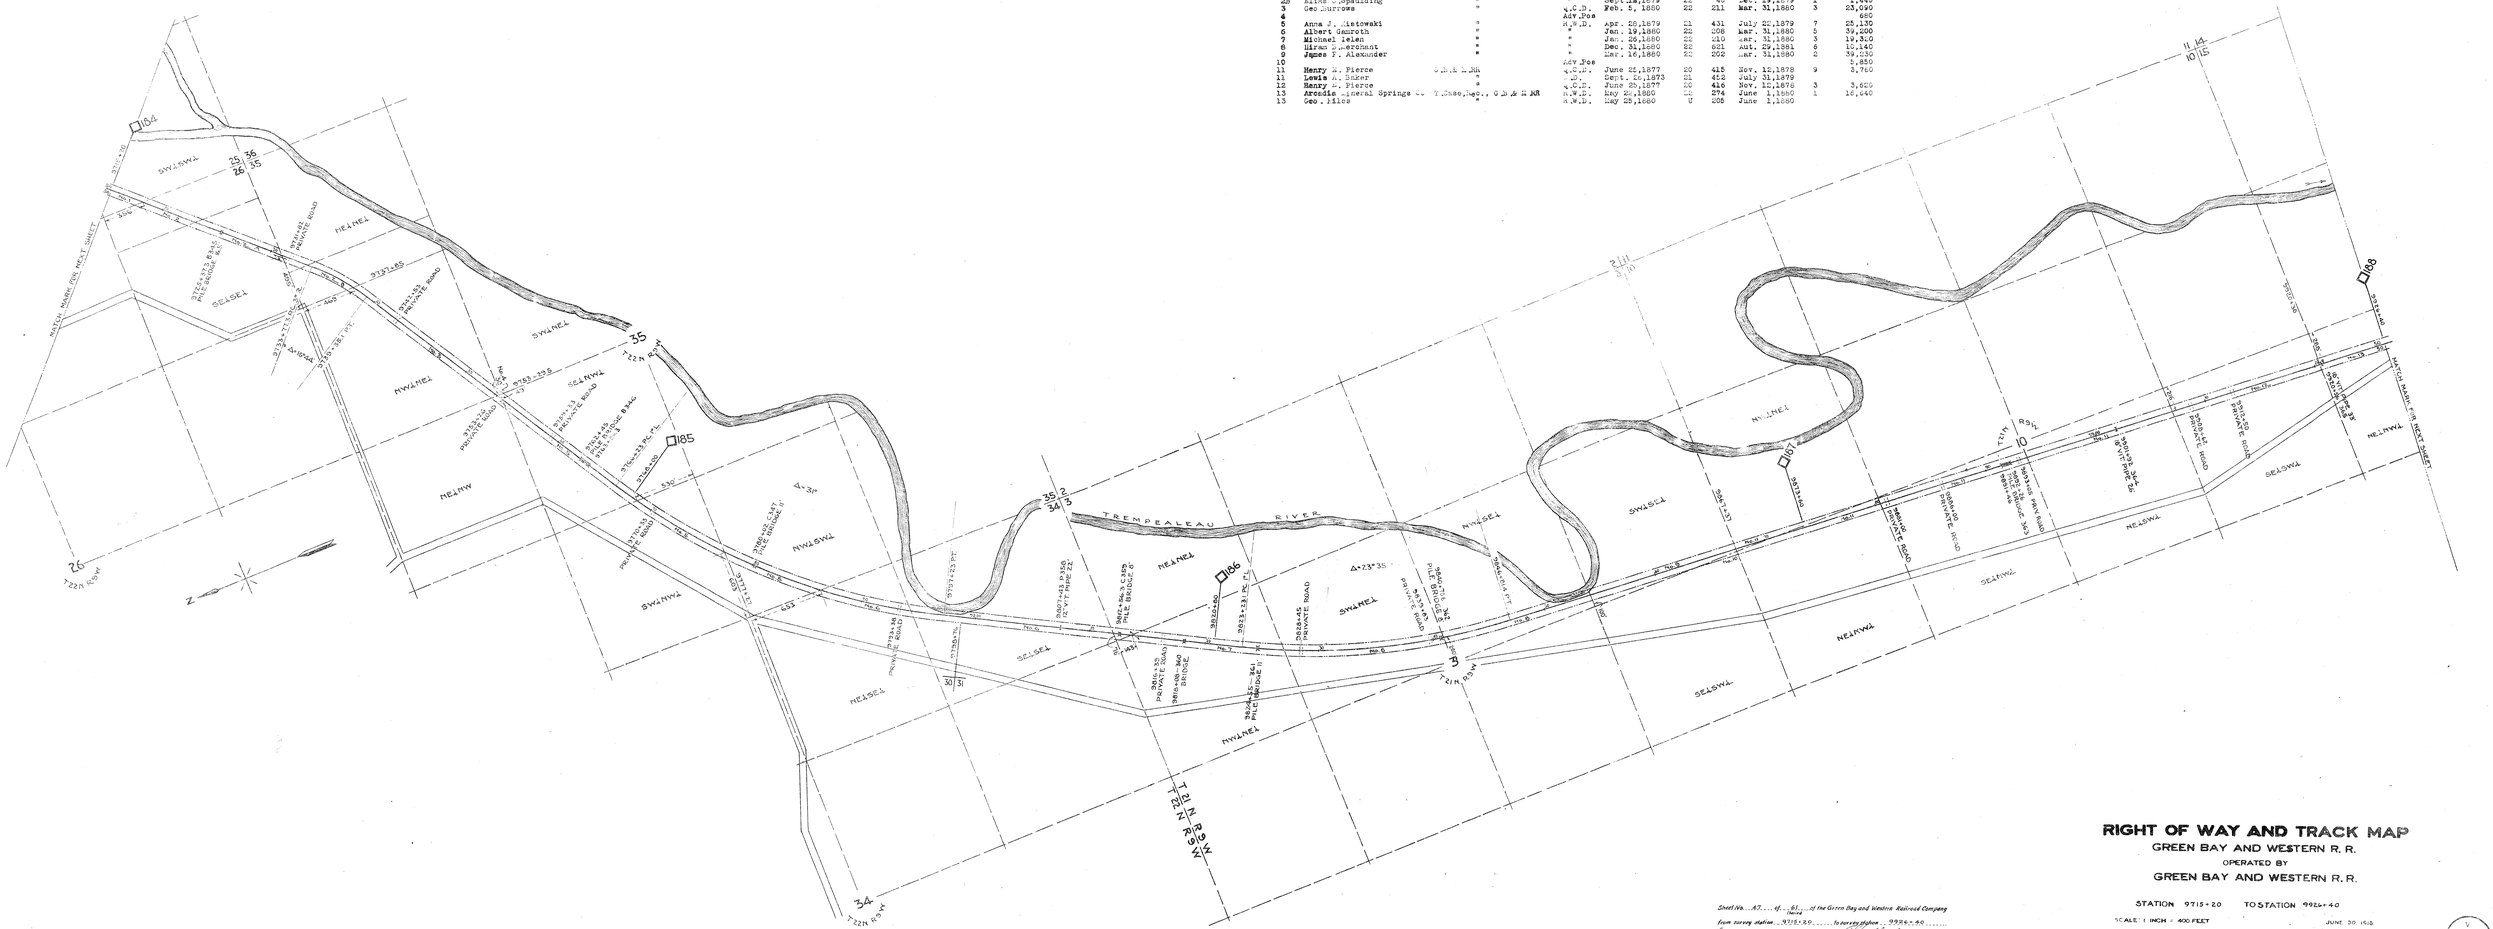

RIGHT OF WAY AND TRACK MAP

GREEN BAY AND WESTERN R. R.

OPERATED BY

GREEN BAY AND WESTERN R. R.

STATION 9715+20 TO STATION 9924+40

SCALE: 1 INCH = 400 FEET JUNE 30, 1918

OFFICE OF CHIEF ENGINEER
GREEN BAY, WIS.

Sheet No. 47 of 81 Sheets of the Green Bay and Western Railroad Company from survey station 9715+20 to survey station 9924+40


V
1A. WIS.
47