
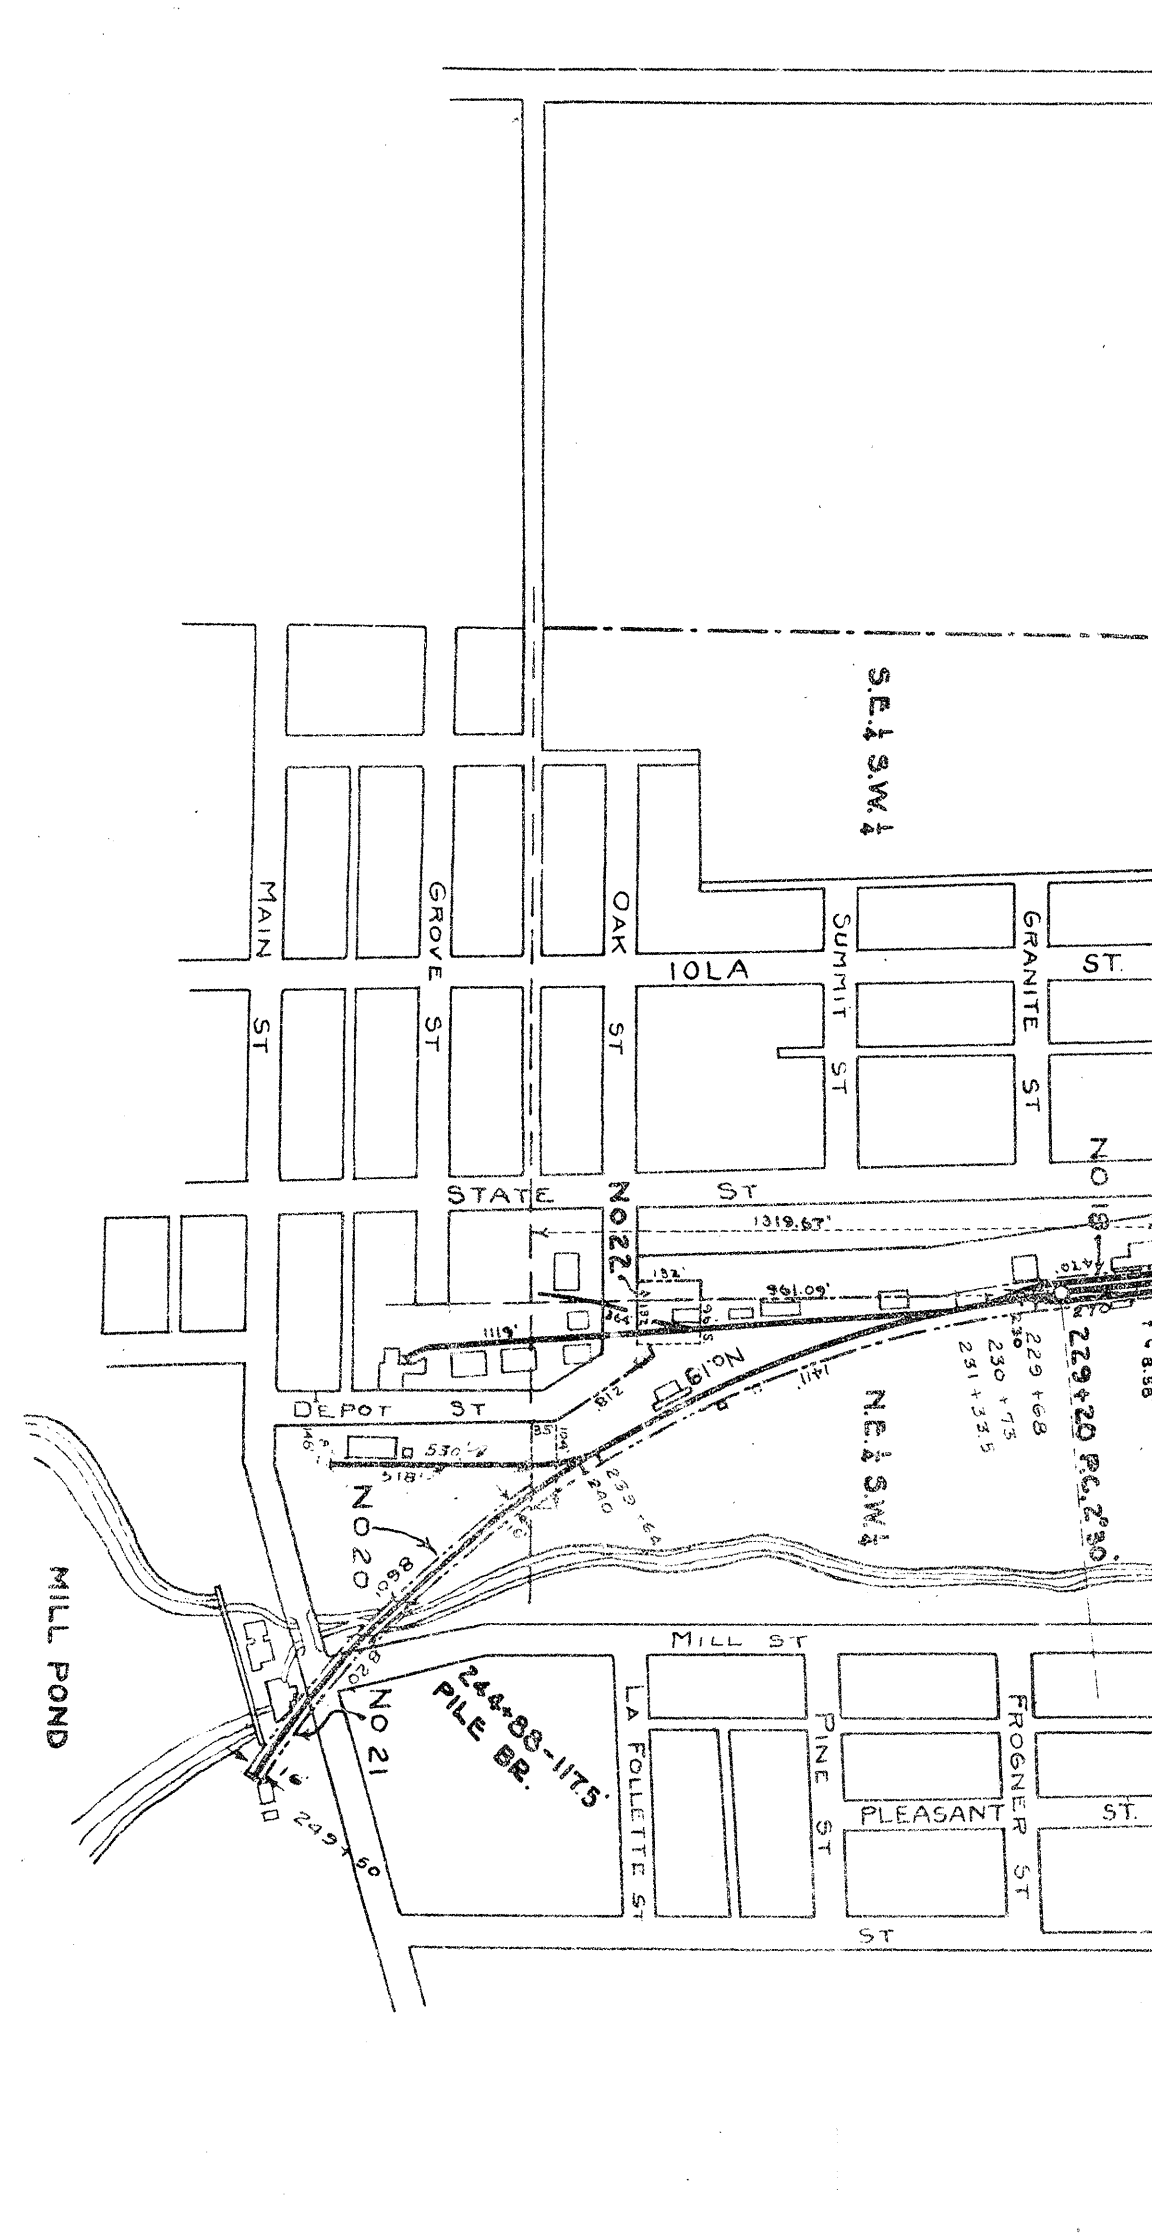


 

RIGHT OF WAY AND TRACK MAP

GREEN BAY AND WESTERN R.R.
OPERATED BY
STATION 0+00 TO STATION 2+9-50

SCALE: 1 INCH = 400 FEET
OFFICE OF CHIEF ENGINEER
GREEN BAY, WIS.
JUNE 30, 1916

NUMBER	GRANTOR	GRANTEE	INSTRUMENT	DATE	RECORD	Book	Page	Date	AREA	Sq. Feet	REMARKS
1	Ole M. Mathre	Iola & Northern RR.	W.D.	June 1, 1894	83	June 21, 1894	222	June 21, 1894	35	820	
2	John O. Weistad			July 19, 1893	81	Nov. 28, 1893	401	Nov. 28, 1893	36	760	
3	N. L. Nelson			June 23, 1893	81	June 26, 1893	253	June 26, 1893	1	17	90
4	Isaac Peterson			June 23, 1893	81	June 26, 1893	253	June 26, 1893	2	36	760
State of Wisconsin
County of Brown
I, the undersigned, Clerk of the Green Bay and Western
Railroad Company, do hereby certify that the foregoing
series of 1 primary sheets and 1 supplemental sheet of said Railroad
right of way map, as shown to me by the Chief Engineer of said
company, prepared from the records of said company.

Witness my hand and the seal of said County of Wisconsin,
this 1st day of June, 1916.

Chief Engineer
Green Bay and Western Railroad Company
Green Bay, Wisconsin