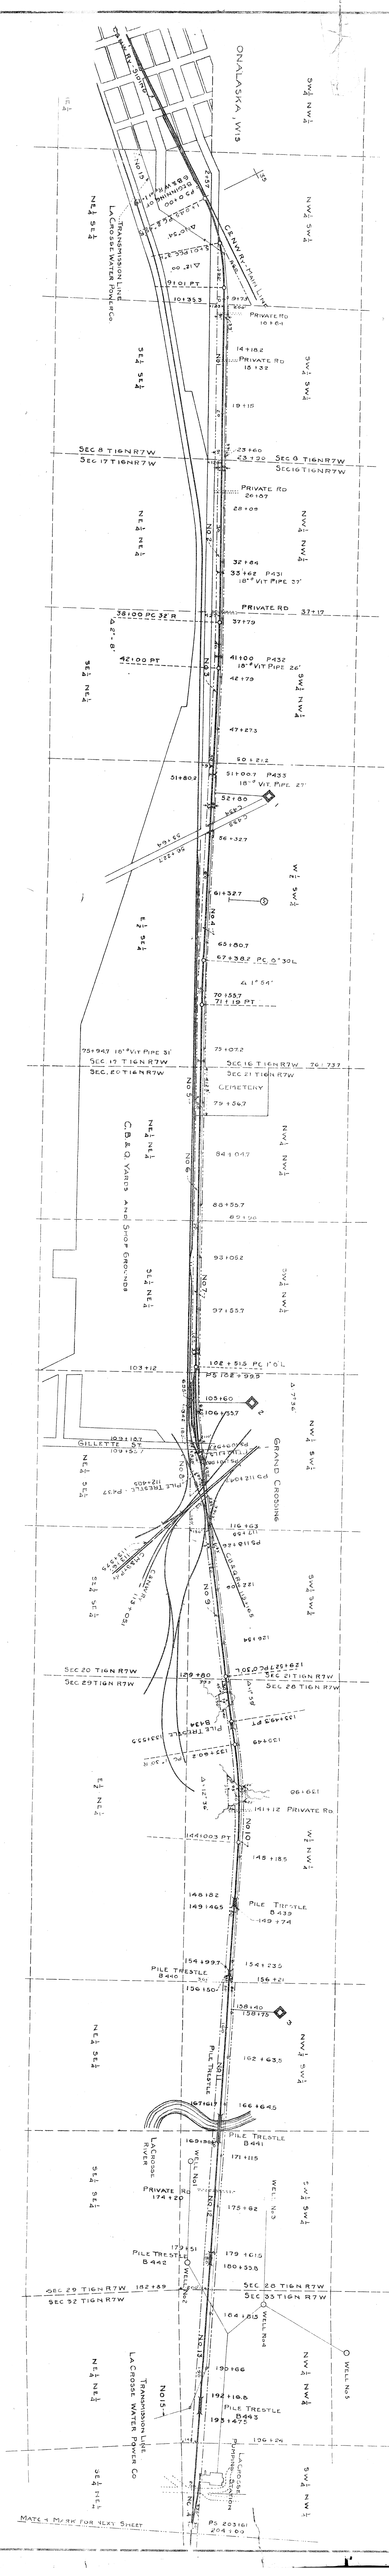

RIGHT OF WAY AND TRACK MAP

GREEN BAY AND WESTERN R. R.

OPERATED BY

GREEN BAY AND WESTERN R. R.

LA CROSSE BRANCH

STATION 0-00 TO STATION 204-00

SCALE 1 INCH = 400 FEET

JUNE 30, 1916

OFFICE OF CHIEF ENGINEER

GREEN BAY, WIS

SHEET 1











