NUMBER	GRANTOR	GRANTEE	INSTRUMENT	DATE	RECORD Book	Page	Date	AREA Acres	NE. AREA Sq. Feet.
1	L. Larchide	K.G.B.&W. RR	W.D.	Aug. 11,1892	71	311	Aug. 12,1892		6,014
2			Adv.Pos.						7,040
3	James Clapp	K.G.B.&W. RR	W.D.	Jan. 4,1892	71	61	Jan. 16,1892		43,200
4	Schumacher Bros.	"	W.D.	July 24,1891	73	478	Oct. 24,1894		13,800
5	H. Brehmer	"	Condemned	July 28,1891	Clerk of Court			1	3,440
6	Albert Weiss	"	Condemned	July 28,1891	Clerk of Court			1	24,120
6	Albert Weiss	"	W.D.	Sept. 3,1891	67	433	Sept.11,1891		
7	Ludvig Martin	"	W.D.	May 28,1891	67	307	June 16,1891	4	23,260
8	Fred Scheller	"	W.D.	May 27,1891	67	317	June 16,1891	1	21,740
9	Richard Koenig	"	W.D.	May 29,1891	67	324	June 16,1891	3	4,220
9	Herman Jahsn	"	Release	May 11,1903					
10	Fredrick Bremer	"	W.D.	May 28,1891	67	319	June 16,1894	3	6,320
11	August Greilling	"	W.D.	June 27,1891	71	73	Jan. 27,1892	4	12,660
12	F. K. Straubel	"	W.D.	June 24,1891	67	368	June 27,1891		35,150
12A	F. K. Straubel	"	W.D.	Mar. 28,1903	96	65	Mar. 31,1903		35,150
13	Gertrude Rotne	"	W.D.	June 4,1891	67	336	June 16,1891		23,550
14	Felicite Duchateau	"	W.D.	July 14,1891	67	390	July 21,1891	1	26,305
14A	Phillip Georgin	"	Release	Oct. 30,1899	78	331	Nov. 21,1899		
15	A. Van VenRoy	"	W.D.	June 20,1891	67	378	July 7,1891	1	23,522
16	P. Van VenRoy	"	W.D.	May 27, 1891	67	329	June 16,1891	5	26,572
17	Frank Liebman	"	W.D.	June 2,1891	67	320	June 16,1891	1	24,393
18	Edmund Liebman	"	W.D.	May 27,1891	67	328	June 16,1891	1	27,007
19			Adverse Possession						2,000
20	Frank Golueke	K.G.B.&W. RR	W.D.	Jan. 30,1892	71	121	Mar. 4, 1892		21,600
21	Wm R. Enderby	"	W.D.	June 5,1891	67	331	June 16,1891	2	18,731
22	C. Guidmilder	"	W.D.	June 5,1891	67	341	June 16,1891		31,200
23	H. Kriecher	"	W.D.	May 29,1891	67	323	June 16,1891	1	11,840
24	James Clapp	C.&N.W. Ry.	Condemned Agreement		Clerk of Court				
24	C.&N.W. Ry.	K.G.B.&W. RR							
25	Barbara Hagemeister	C.&N.W. Ry.and K.G.B.&W.RR	Condemned	Sept.23,1895	Clerk of Court				31,128
26	Peter Tuyles	" "	Condemned	Sept.23,1895	Clerk of Court				8,700
27	Peter Tuyles	" "	W.D.	Dec. 12,1910	119	286	Dec. 16,1910		11,484
28	Barbara Hagemeister	" "	Condemned	Sept.23,1895	Clerk of Court				29,280
"8	Hagemeister Brewing Co.	" "	Easement Possessory	Aug. 7,1895	79	242	Nov. 15,1895		3,000

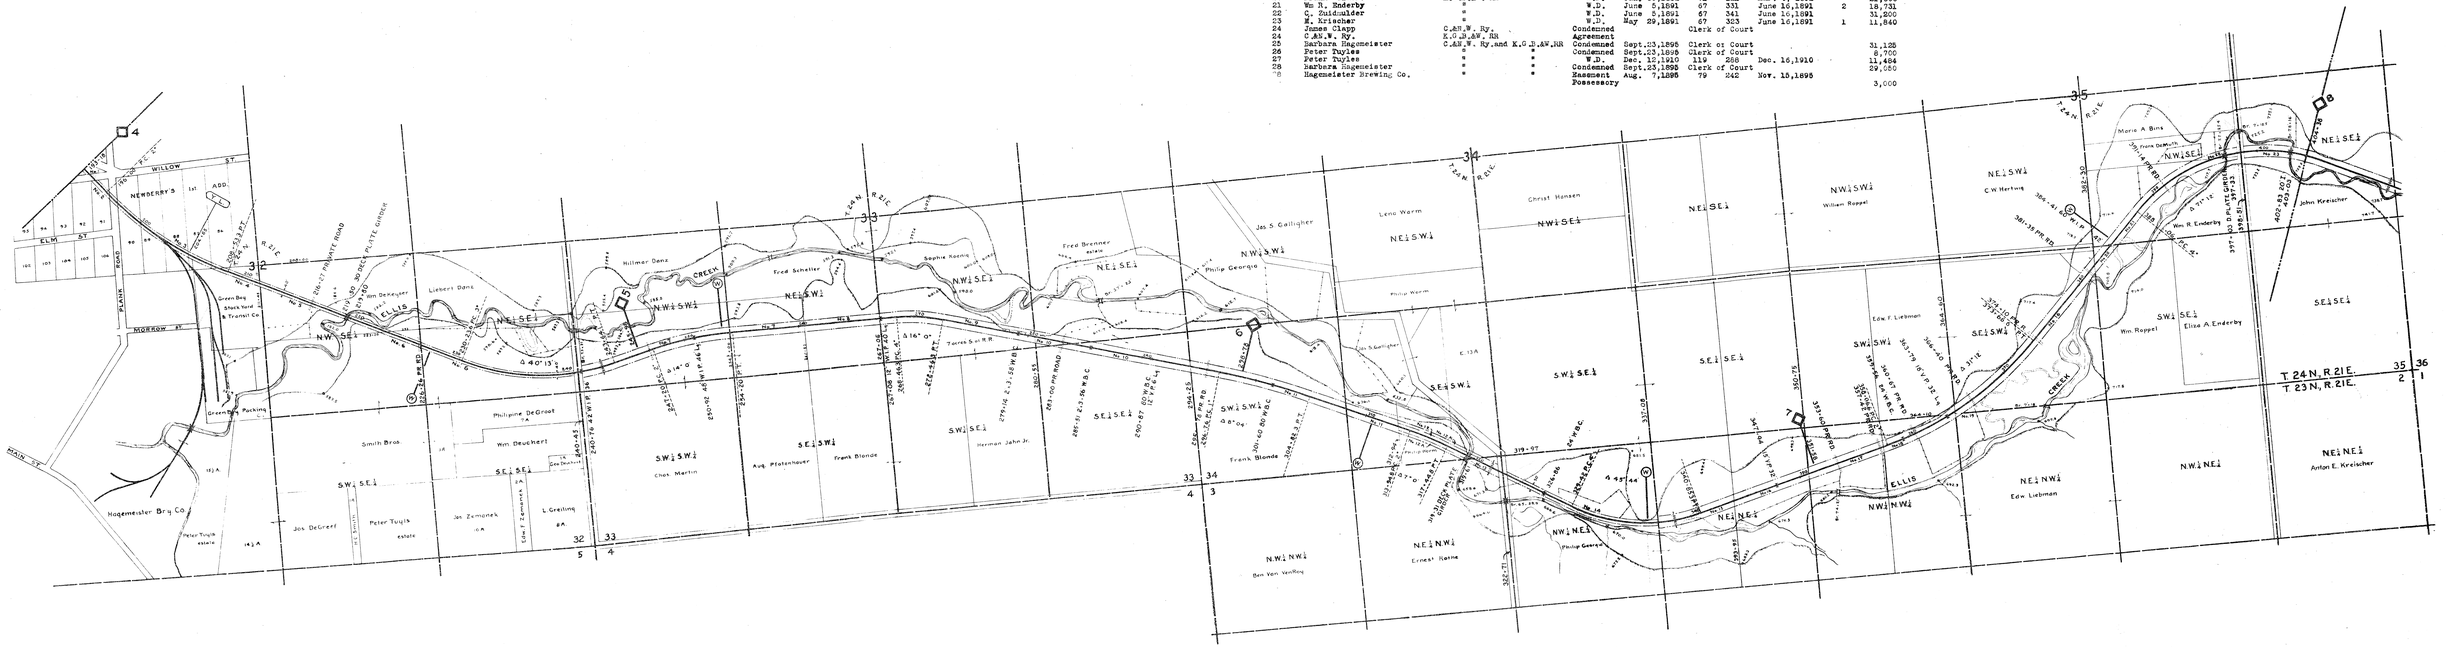

Sheet No. 2 of 14 Sheets of the Kewaunee, Green Bay and Western Railroad
Company from Survey Station 193+18 to Survey Station 404+38
Chief Engineer

RIGHT OF WAY AND TRACK MAP
KEWAUNEE, GREEN BAY AND WESTERN R. R.
OPERATED BY
KEWAUNEE, GREEN BAY AND WESTERN R. R.

STATION 193+18 TO STATION 404+38

SCALE: 1 INCH 400 FEET JUNE 30, 1916

OFFICE OF CHIEF ENGINEER
GREEN BAY, WIS.

V-2-WIS
2